




• D.D. Hole No. 8
Surf 21, 1911-12

SCOTT LOHR

• D.D. Hole No. 4
Surf 21, 1911-12

JENNER TOWNSHIP
CONEMAUGH TOWNSHIP

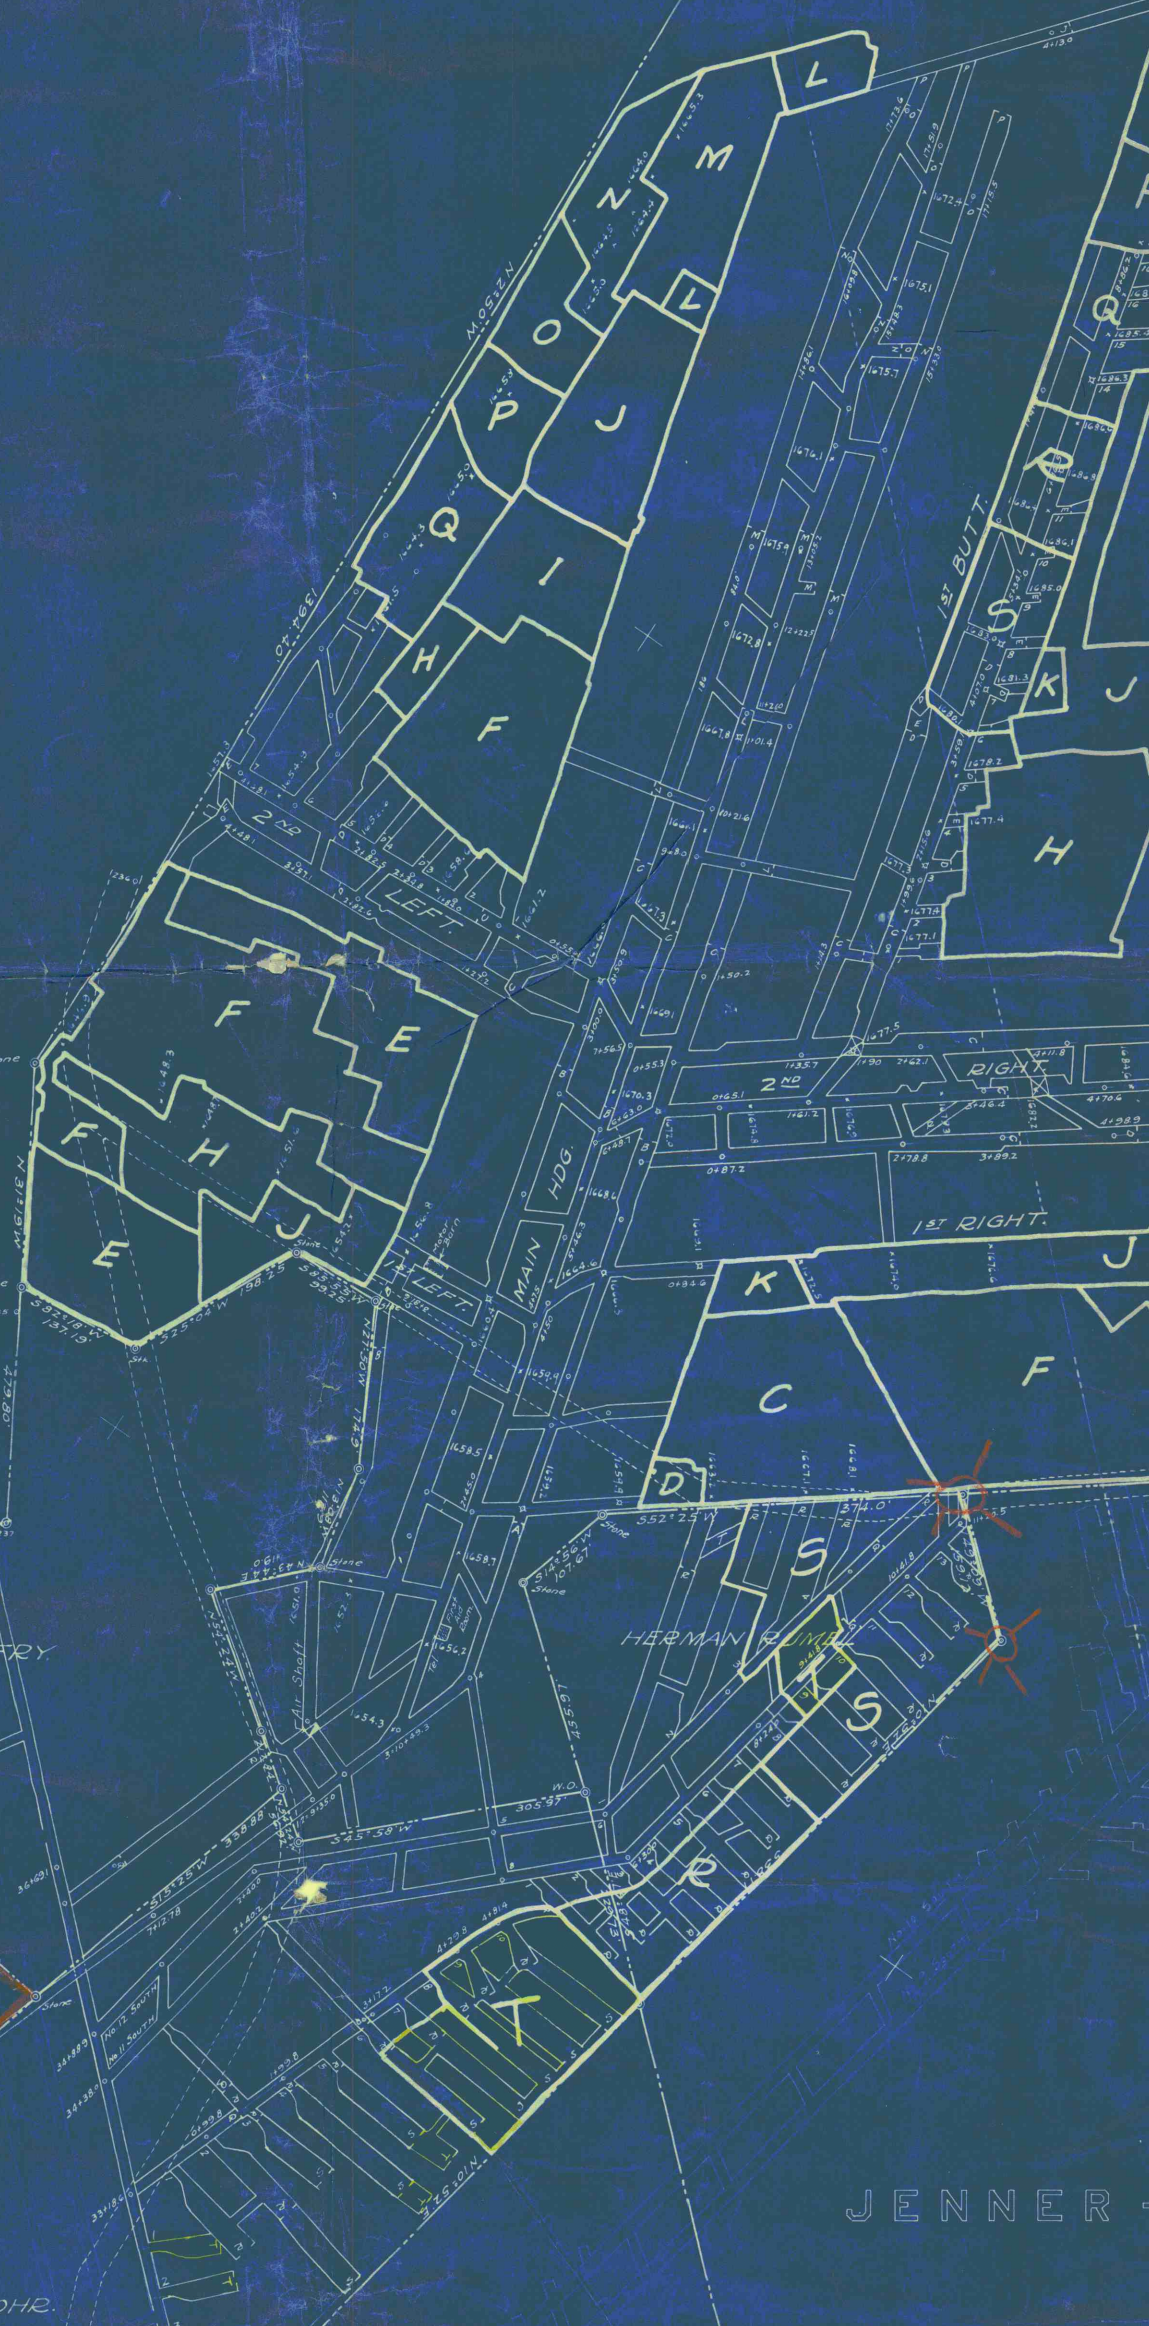

ISAAC HOSTETLER

ELIZA LOHR

HIGAM BLOUGH

PENN SMOKELESS COAL CO.
HIYASOTA MINE No. 1

SITUATE IN
JENNER AND CONEMAUGH TOWNSHIPS
SOMERSET COUNTY
PENNSYLVANIA
Scale 1"=100'
JUNE 19, 1919.

J. B. Madsen & Company
Civil and Mining Engineers
Johnstown, Penna.