


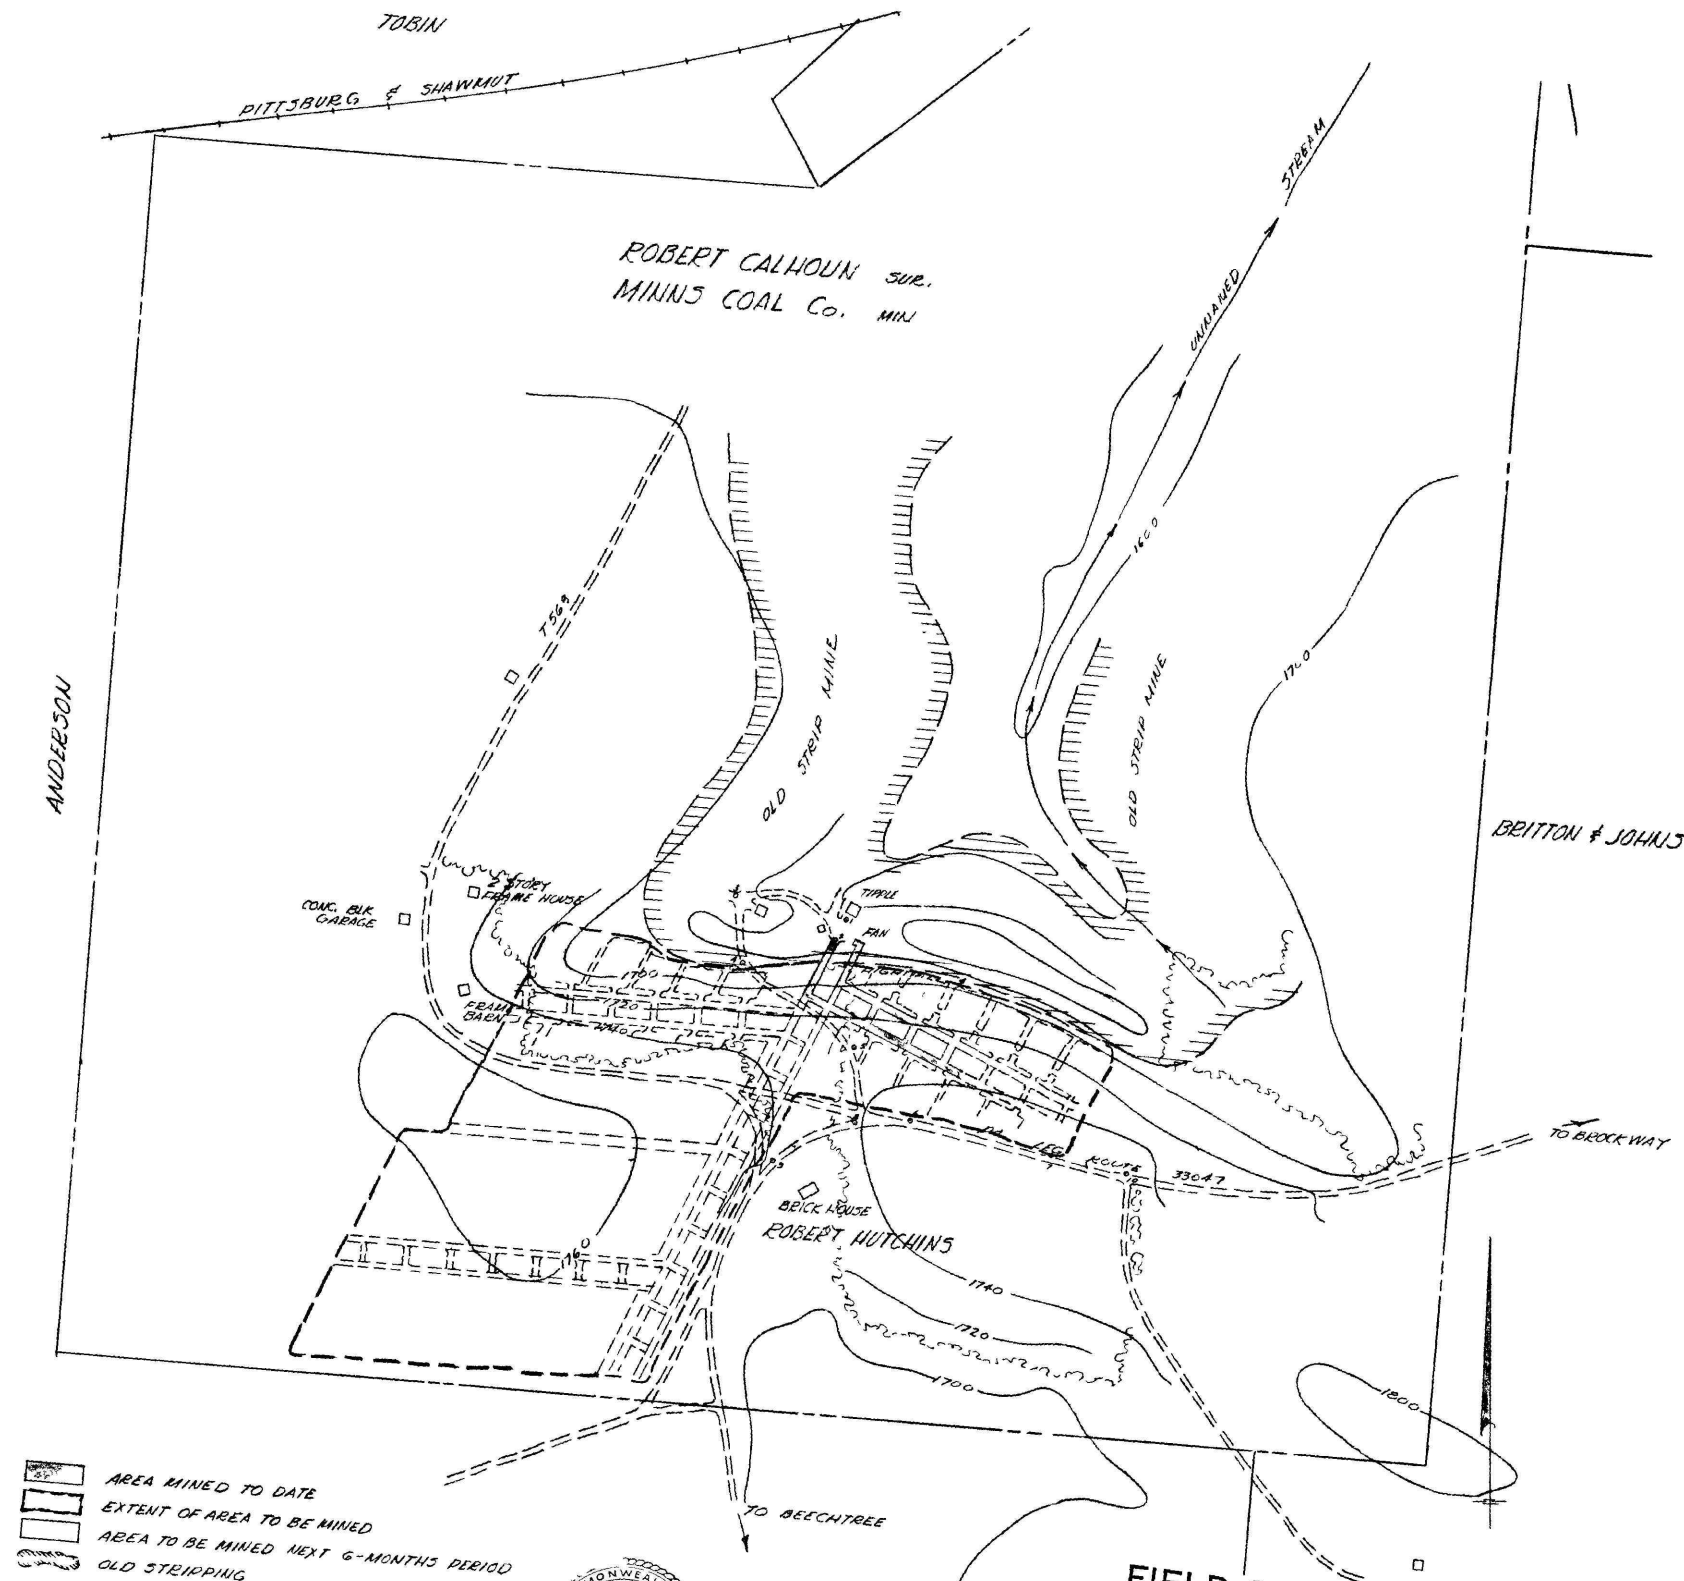

AREA MINED TO DATE
 EXTENT OF AREA TO BE MINED
 AREA TO BE MINED NEXT 6-MONTHS PERIOD
 OLD STRIPPING

YOST ASSOCIATES INC
 ENGINEERS
 DUBUIS, PA



FIELD COPY
 HOLT MINE
 ON THE
 ROBERT CALHOUN PROPERTY
 IN
 WASHINGTON TWP JEFF CO PA.
 SCALE 1"=200' SEPT 13, 66'

#1299
 8-4-99
 CC

13401 13/1

FILE 802A