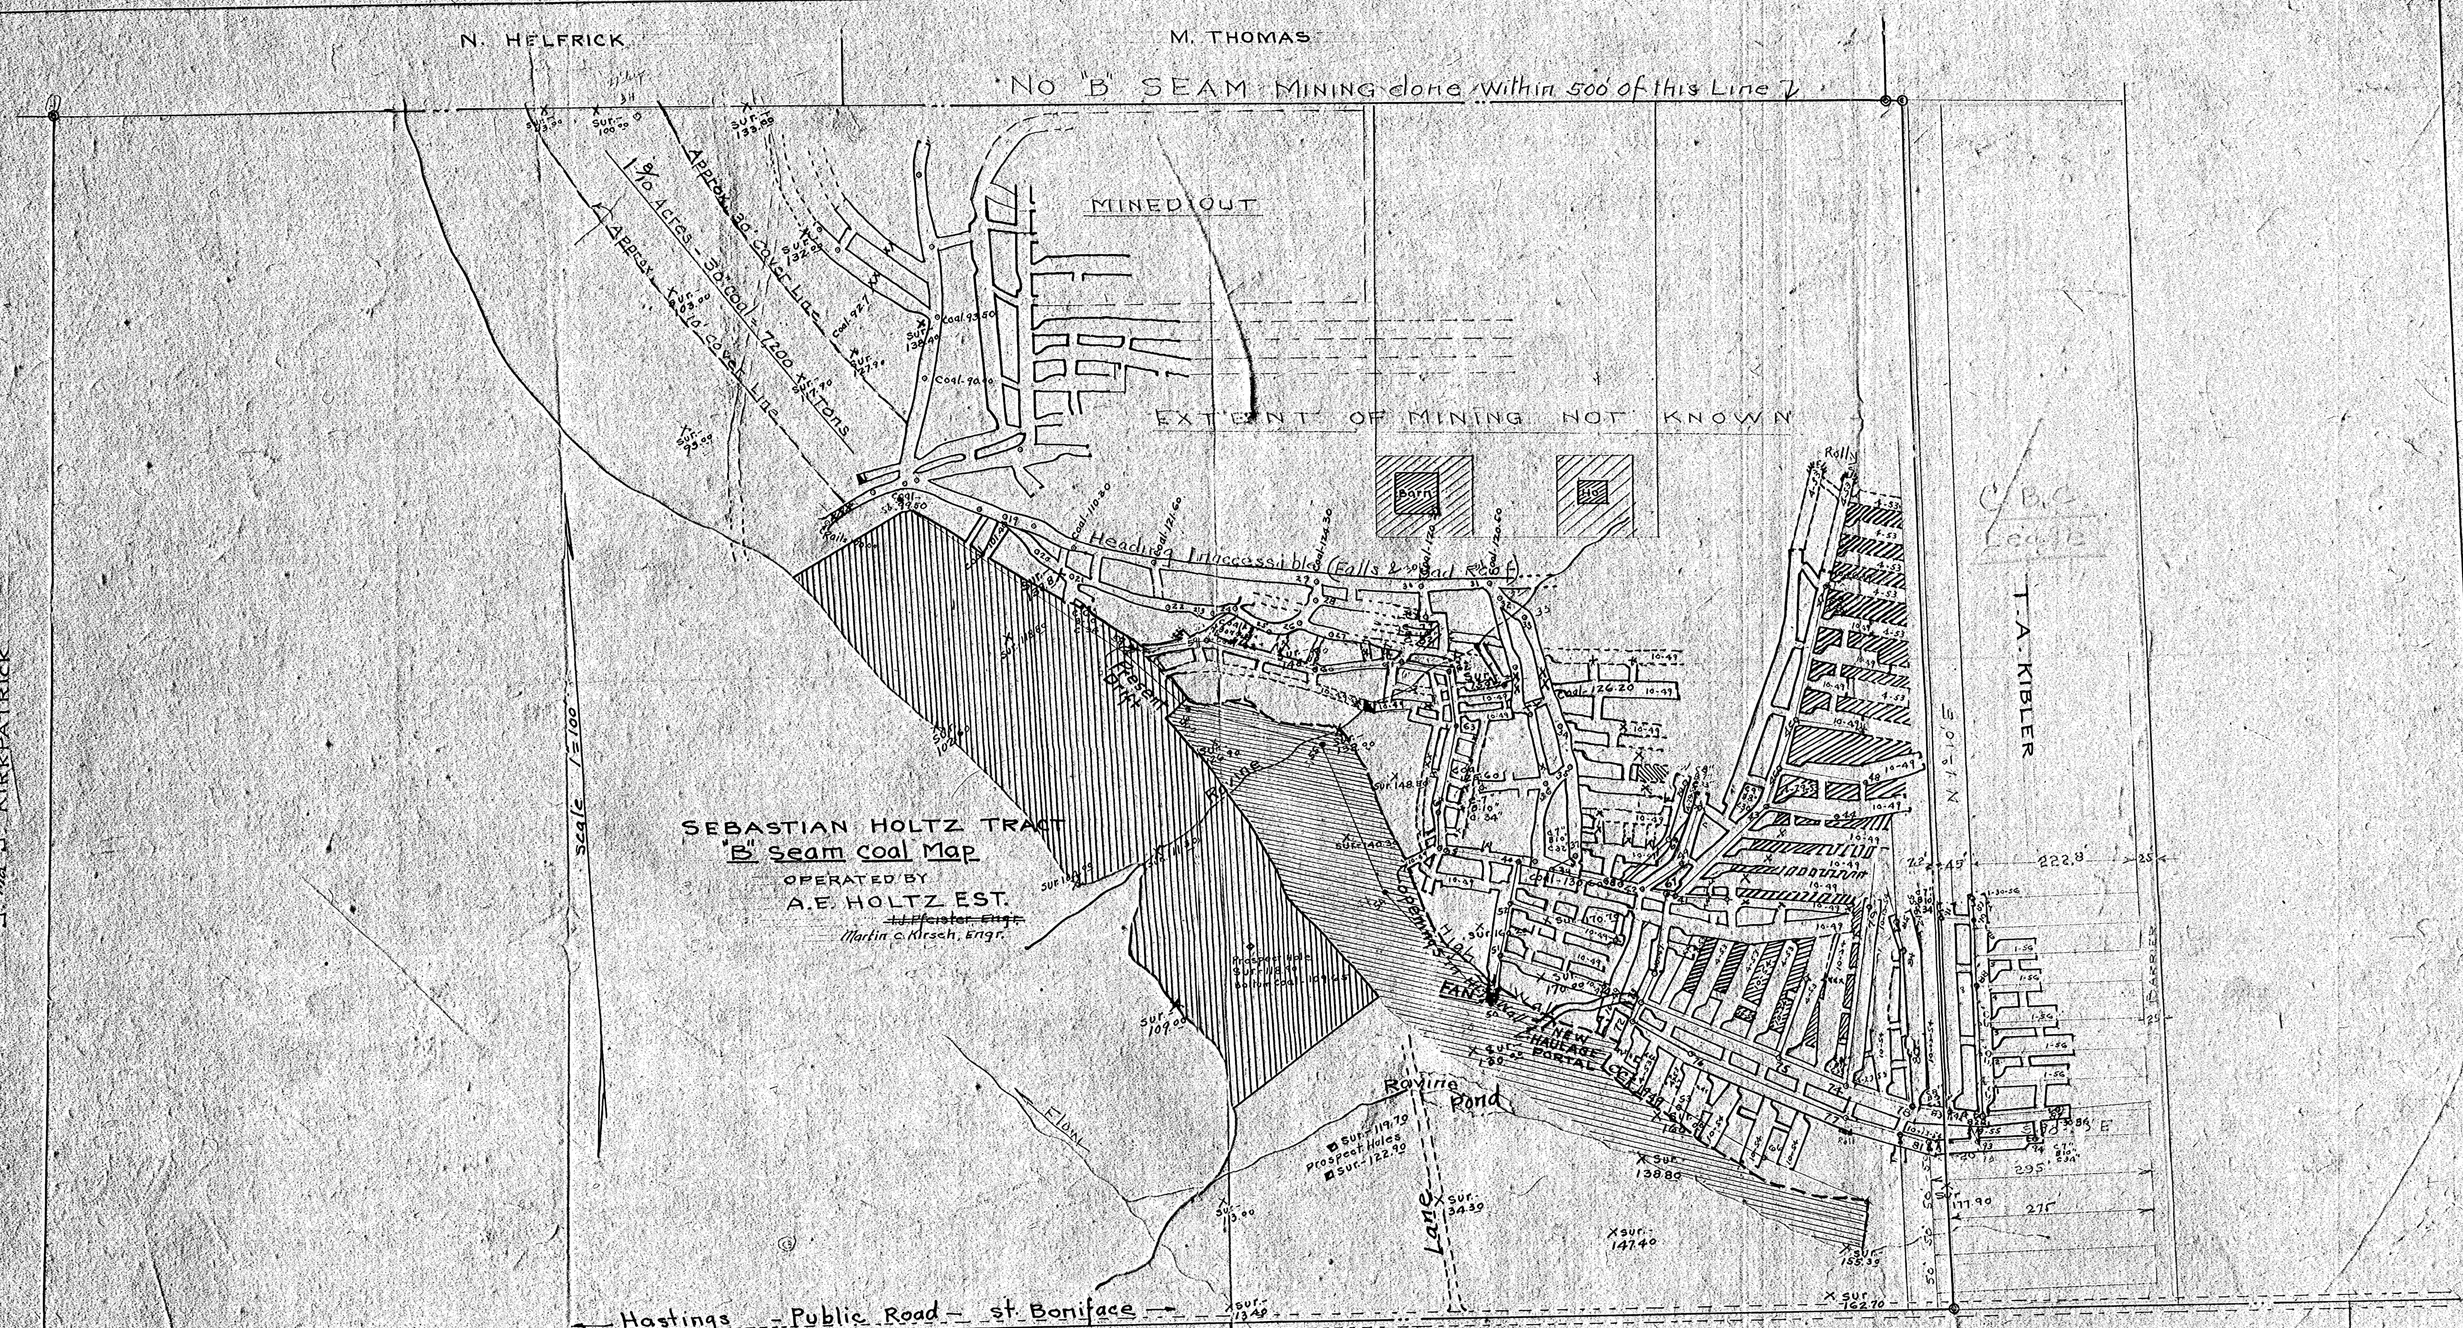N. HELFRICK
M. THOMAS
No "B" SEAM Mining done within 500' of this Line
MINED OUT
EXTENT OF MINING NOT KNOWN
Heading Inaccessible (Falls & Bad Roof)
Barn
T. A. KIBLER
J and J KIRKPATRICK
Scale 1"=100'
SEBASTIAN HOLTZ TRACT
"B" Seam Coal Map
OPERATED BY
A.E. HOLTZ EST.
I.J. Pfeister Engr.
Martin C. Kirsch, Engr.
Ravine
FAN
NEW HAULAGE PORTAL
Ravine Road
Lane
Prospect Holes
Flow
Hastings - Public Road - St. Boniface
BARRIER