


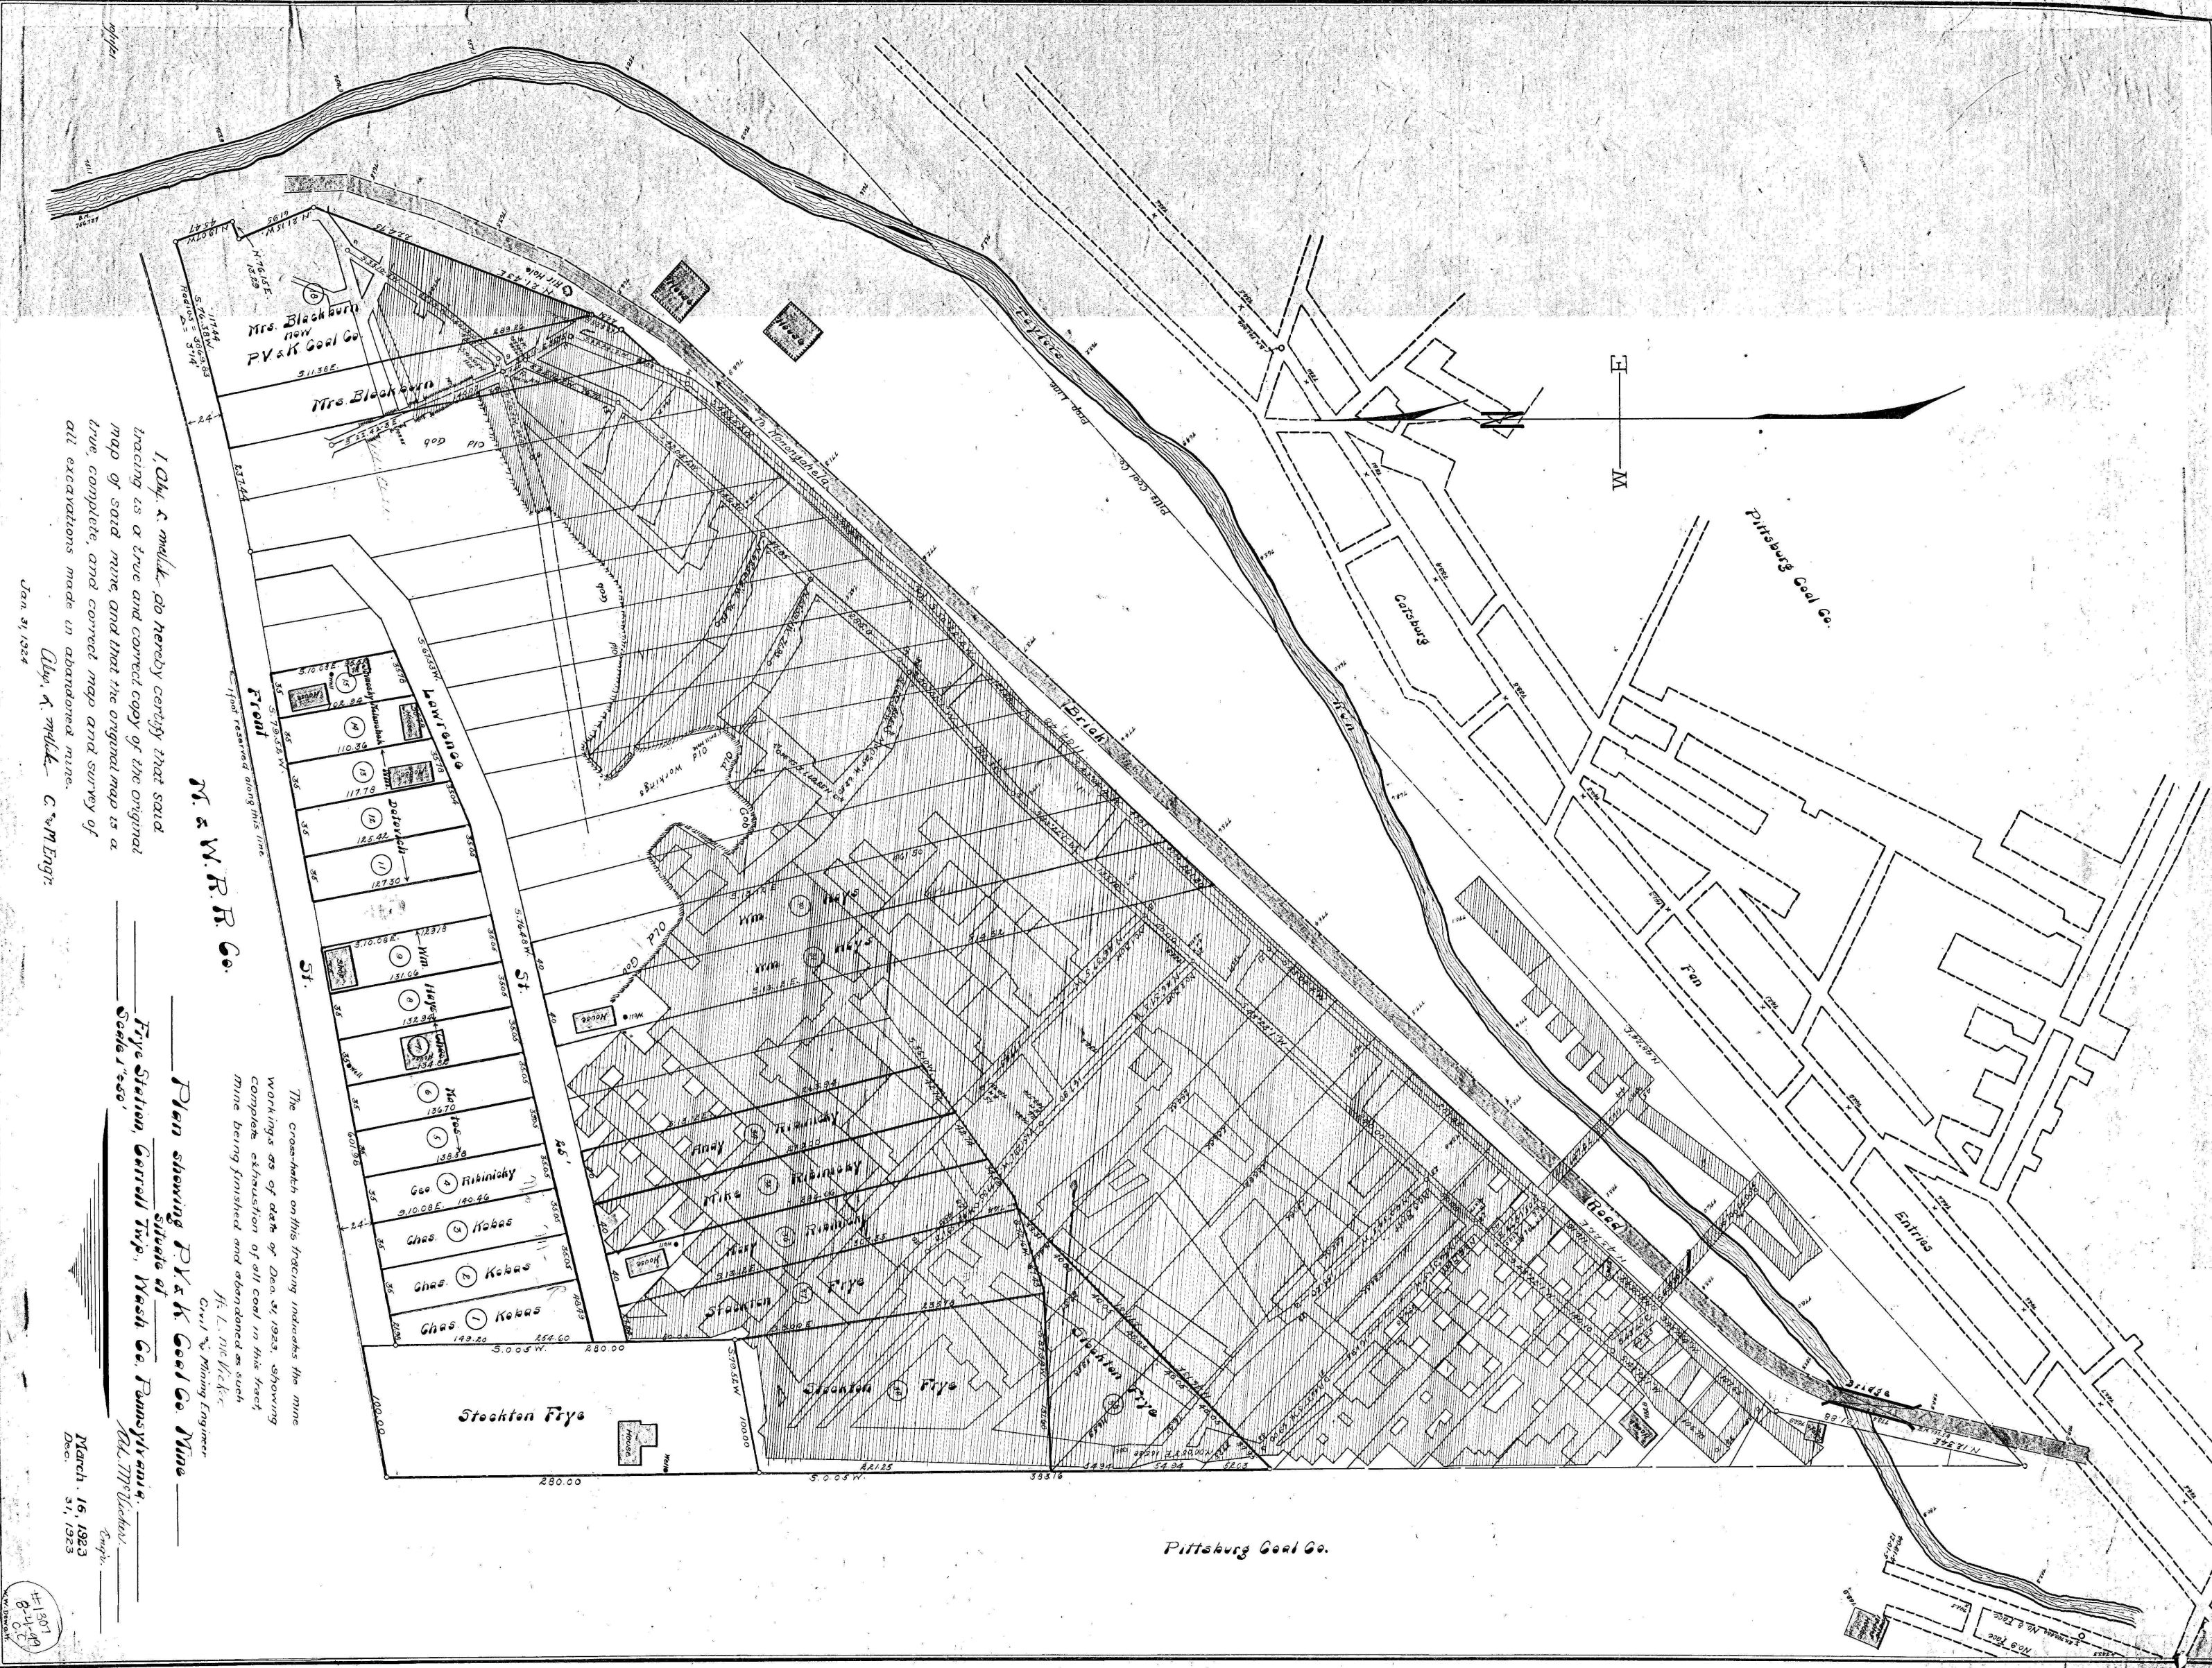

I, Chas. A. muller, do hereby certify that said tracing is a true and correct copy of the original map of said mine and that the original map is a true, complete, and correct map and survey of all excavations made in abandoned mine.

Chas. A. muller, C. & M. Engr.

Jan. 31, 1924

W. & W. R. R. Co.

Plan showing P.V. & K. Coal Co. Mine

Scale 1"=50'

Fire Station, Carroll Twp., Wash. Co., Pennsylvania,

March 16, 1923

Dec. 31, 1923

H. L. McWick,
Civil & Mining Engineer

#1307
8-14-23
W. & W. R. R. Co.