

CURWENSVILLE (JUNG U S 322) 9.7 MI
CLANTA 4.6 MI

(Glen Richey)


FIELD COPY

YORKSHIRE COAL CO.
MADERA, PA.


LOCATION OF
MINE & COAL LAND

CLEARFIELD, PA.
SEPT. 7, 1966

ROY C. KINDIG
REG. ENGR.

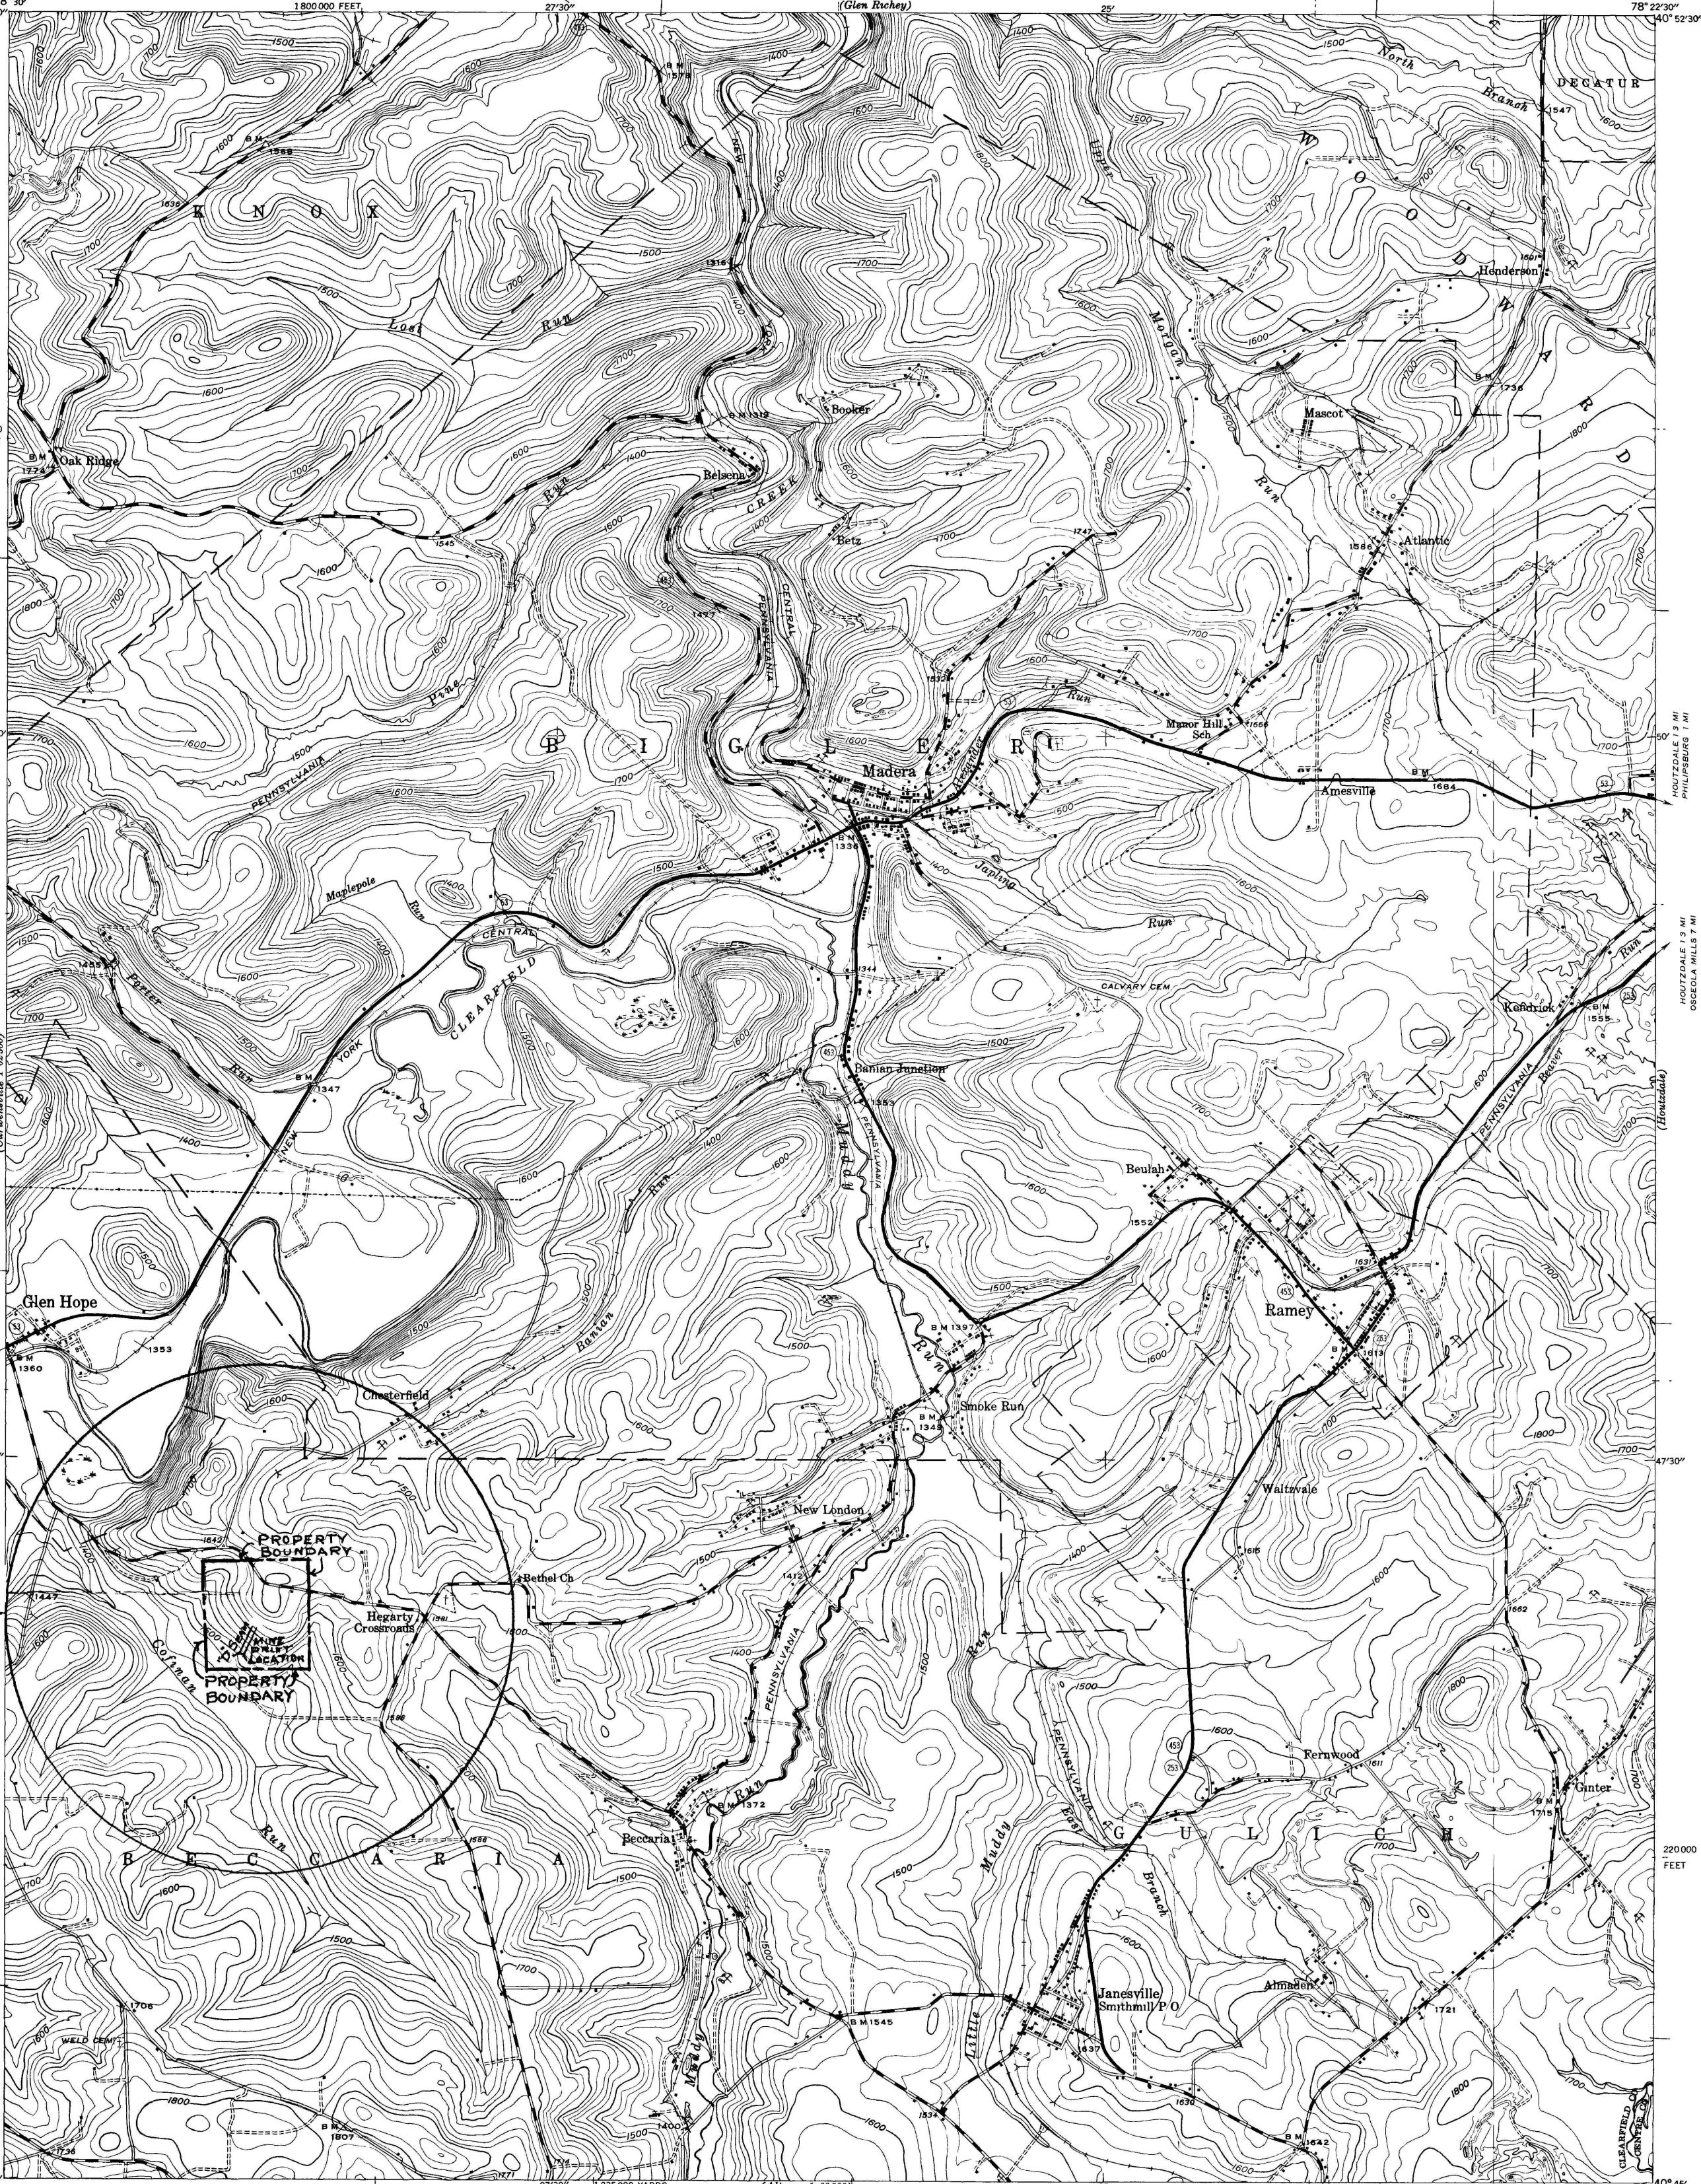

Maped by the Geological Survey
1945

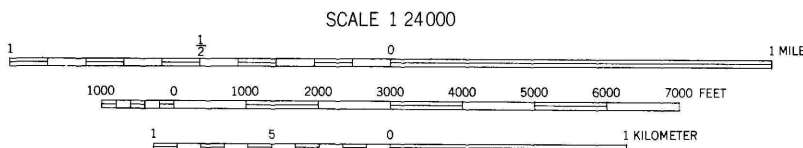

Contour interval 20 feet
Datum is mean sea level

ROAD CLASSIFICATION
Heavy duty ——— 4 LANE 16 LANE Light duty ———
Medium duty ——— 4 LANE 16 LANE Unimproved dirt ———
U S Route State Route

APPROXIMATE MEAN
DECLINATION, 1945

**BECCARIA TOWNSHIP
CLEARFIELD COUNTY
PERMIT NUMBER -182-1
"D"-OR LOWER FREEPORT SEAM**

FOR SALE BY U S GEOLOGICAL SURVEY, WASHINGTON 25, D C
A FOLDER DESCRIBING TOPOGRAPHIC MAPS AND SYMBOLS IS AVAILABLE ON REQUEST

ALLEMANS 2 MI
VAN ORMER 8.7 MI

TYRONE 11 MI
ALTOONA 31 MI

Polyconic projection 1927 North American datum
5000 yard grid based on U S zone system, B
10000 foot grid based on Pennsylvania (North)
rectangular coordinate system

RAMEY, PA

N4045-W7822 5/7 5

1945