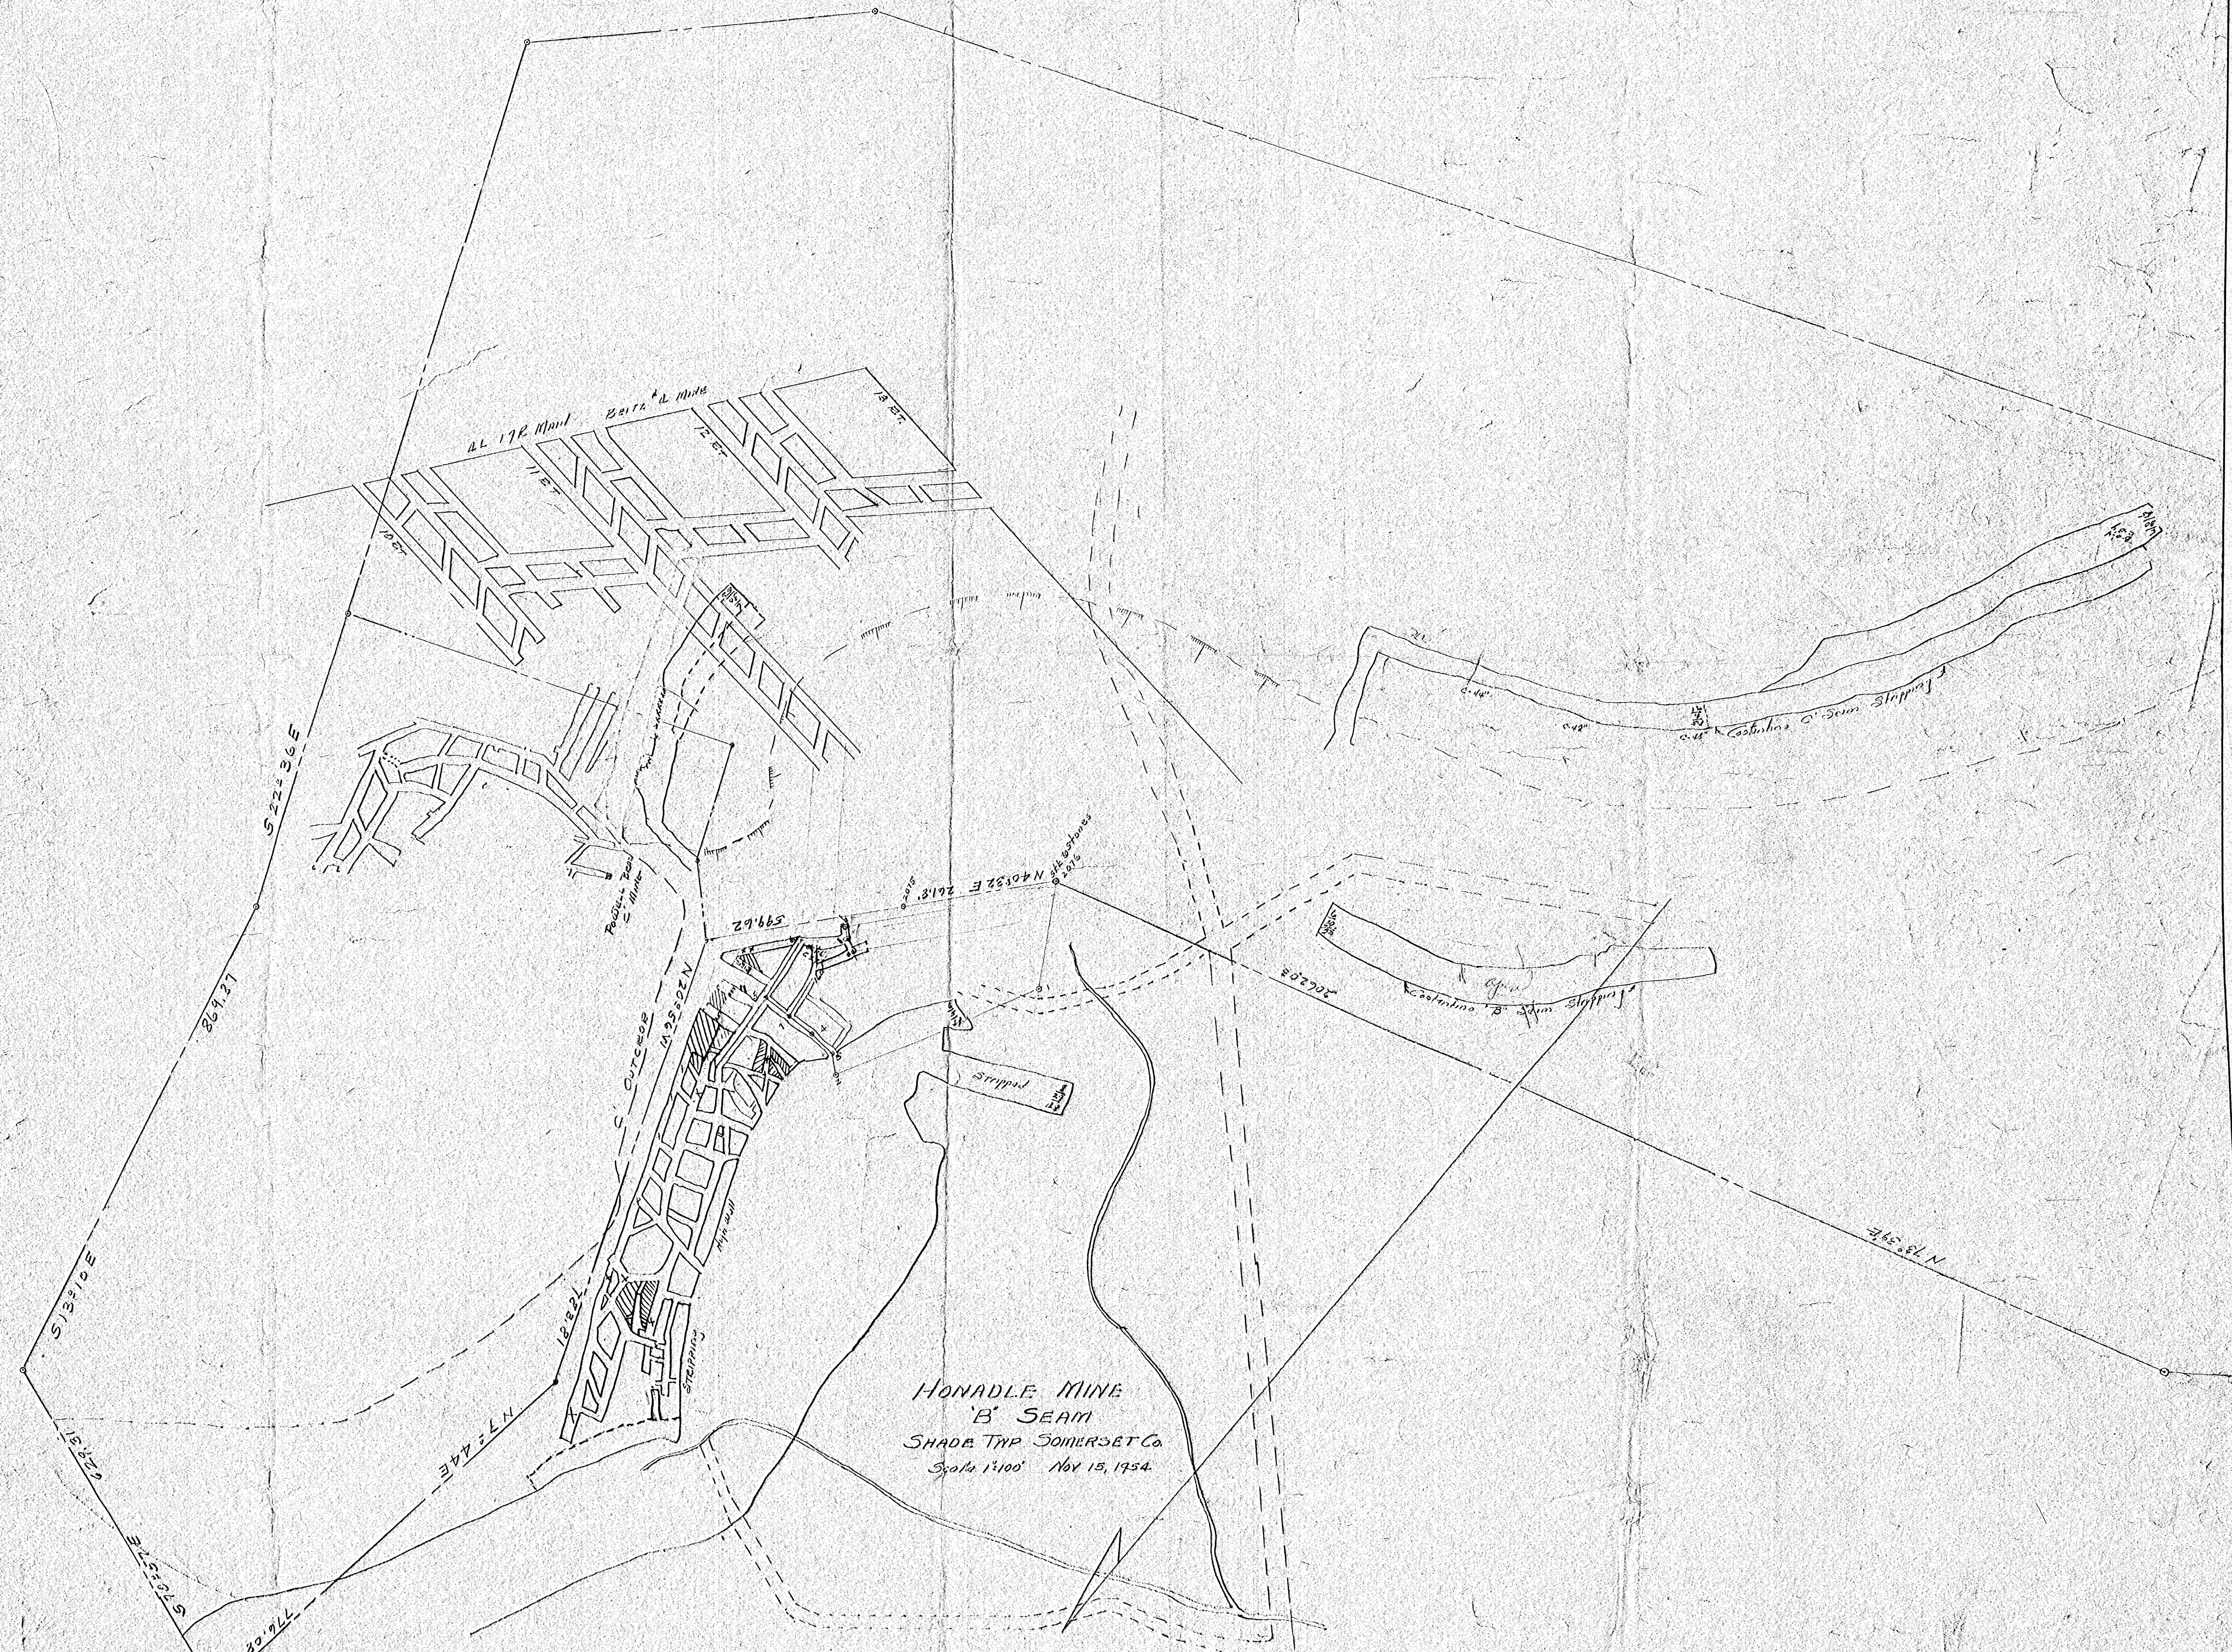

4L 17R Main
Beth 4L Mine
10 Rt.
11 Rt.
12 Rt.
13 Rt.
S 22°36 E
869.27
S 13°10 E
629.81
S 70°52 E
776.08
N 7°44 E
183.81
N 20°59 W
C' Outcrop
599.62
N 40°32 E 261.8'
2075
2016
stk & stones
Stripped
Stripping
High wall
Costantino 'C' Seam Stripping
Costantino 'B' Seam Stripping
Open
C-44"
C-48"
C-48"
N 73°58 E
206.08

HONADLE MINE
'B' SEAM
SHADE TWP SOMERSET CO.
Scale 1"=100' Nov 15, 1954.

#1309
B-4-99
GC