


DAN + ANN PETERMAN (SURFACE)
BERWIND CORP. (COAL)

©DDH #7

Tract 875

UP TO DATE
ACCORDING TO FIRST
MAP FROM BOUCE TRENT
10-2-73

STRIP CUT HIGH WALL

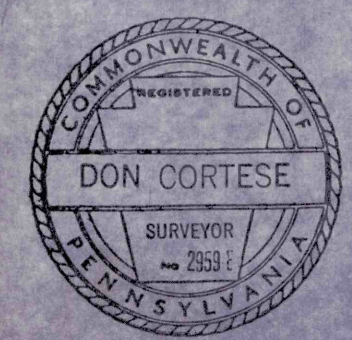

Tract 861

■ Mining Area From 7-11-70 To 1-11-71
▨ Mining Completed

GEORGE HRITZ COAL CO. #4
SHADE TWP. SOMERSET CO. PA.

SCALE 1"=100'

Note: Bench Mark Elevation taken at Bottom of Drift Mouth Baker Whitley #3 Mine.
Now Worked out and Abandoned. Elevations taken 7-17-70 Don Cortese R.S.
R.M. = 2120.70

BERWIND CORP.
SURFACE & COAL

#1322
2-1-79
C.