


TRAUGER MINE

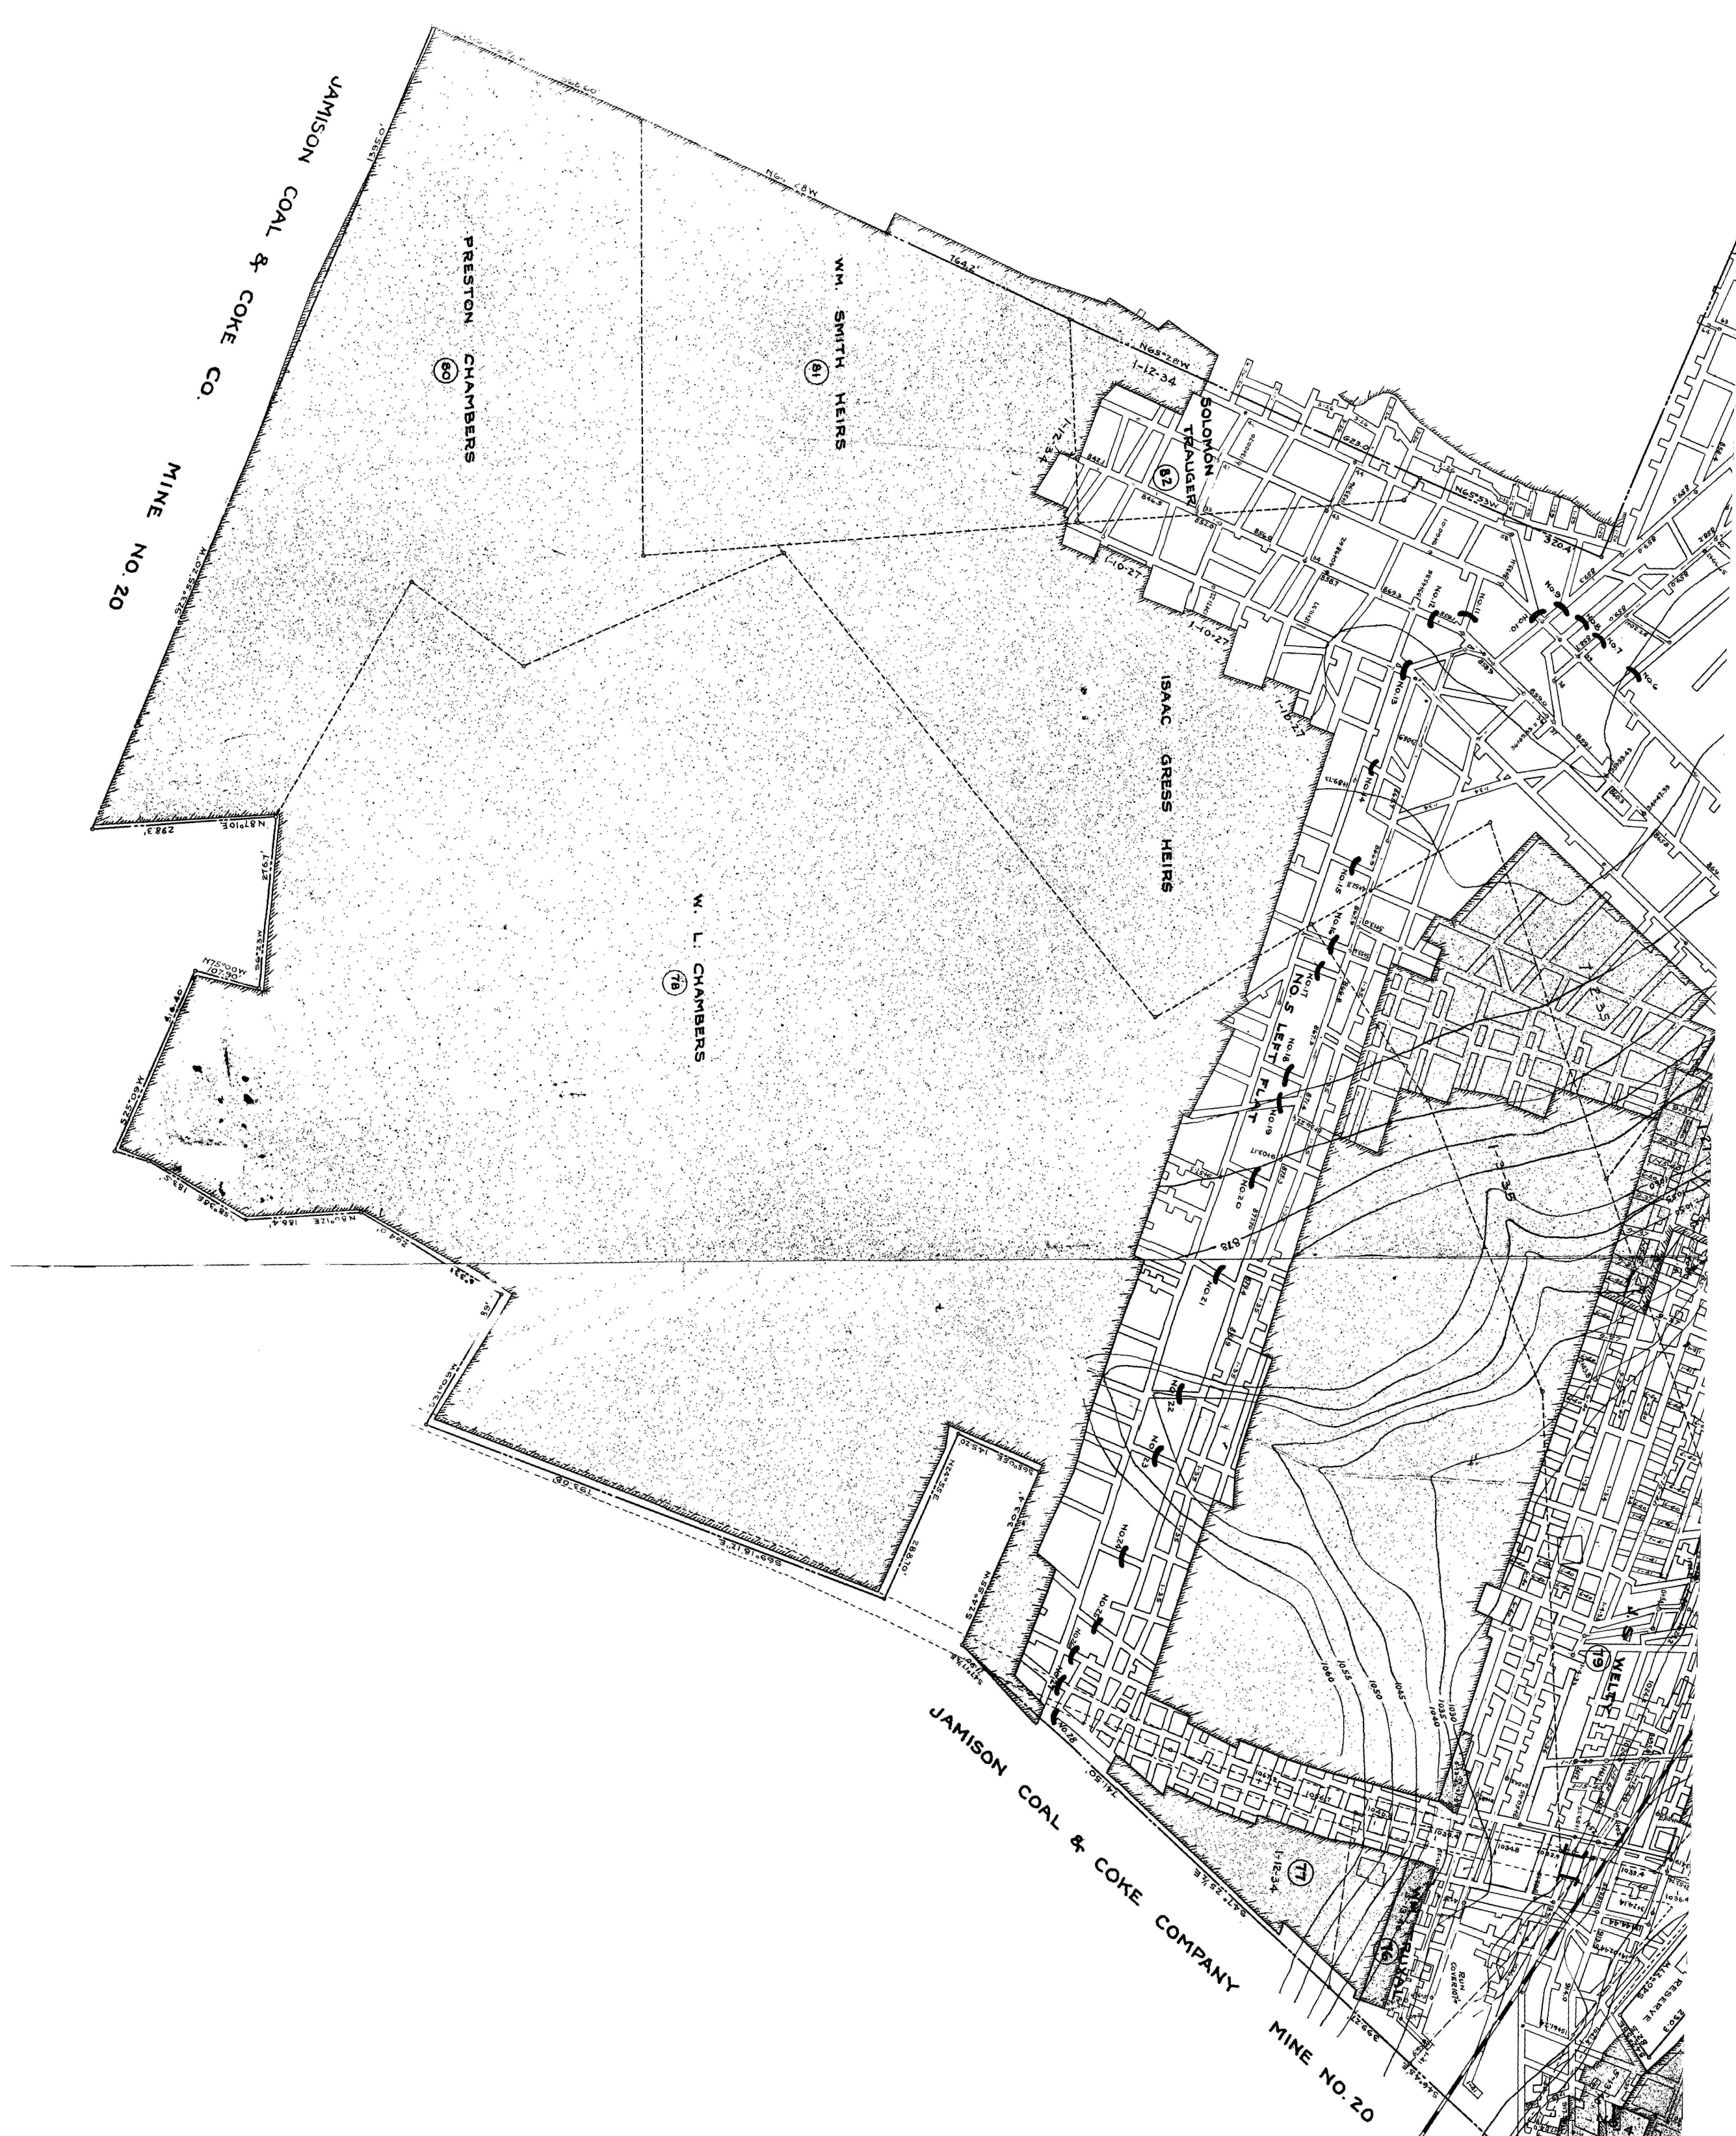

MAP OF MINE
OF
HUMPHREYS COAL AND COKE CO.
UNITY TOWNSHIP
WESTMORELAND CO., PA.
SCALE 1 IN = 100 FT.
JAN. 1935.

UNITY TOWNSHIP
SCALE 1 IN = 100

MAP OF MINE
OF
HUMPHREYS COAL AND COKE CO.
MARQUERITE LEASE.
WESTMORELAND CO., PA.
JAN. 1937

