



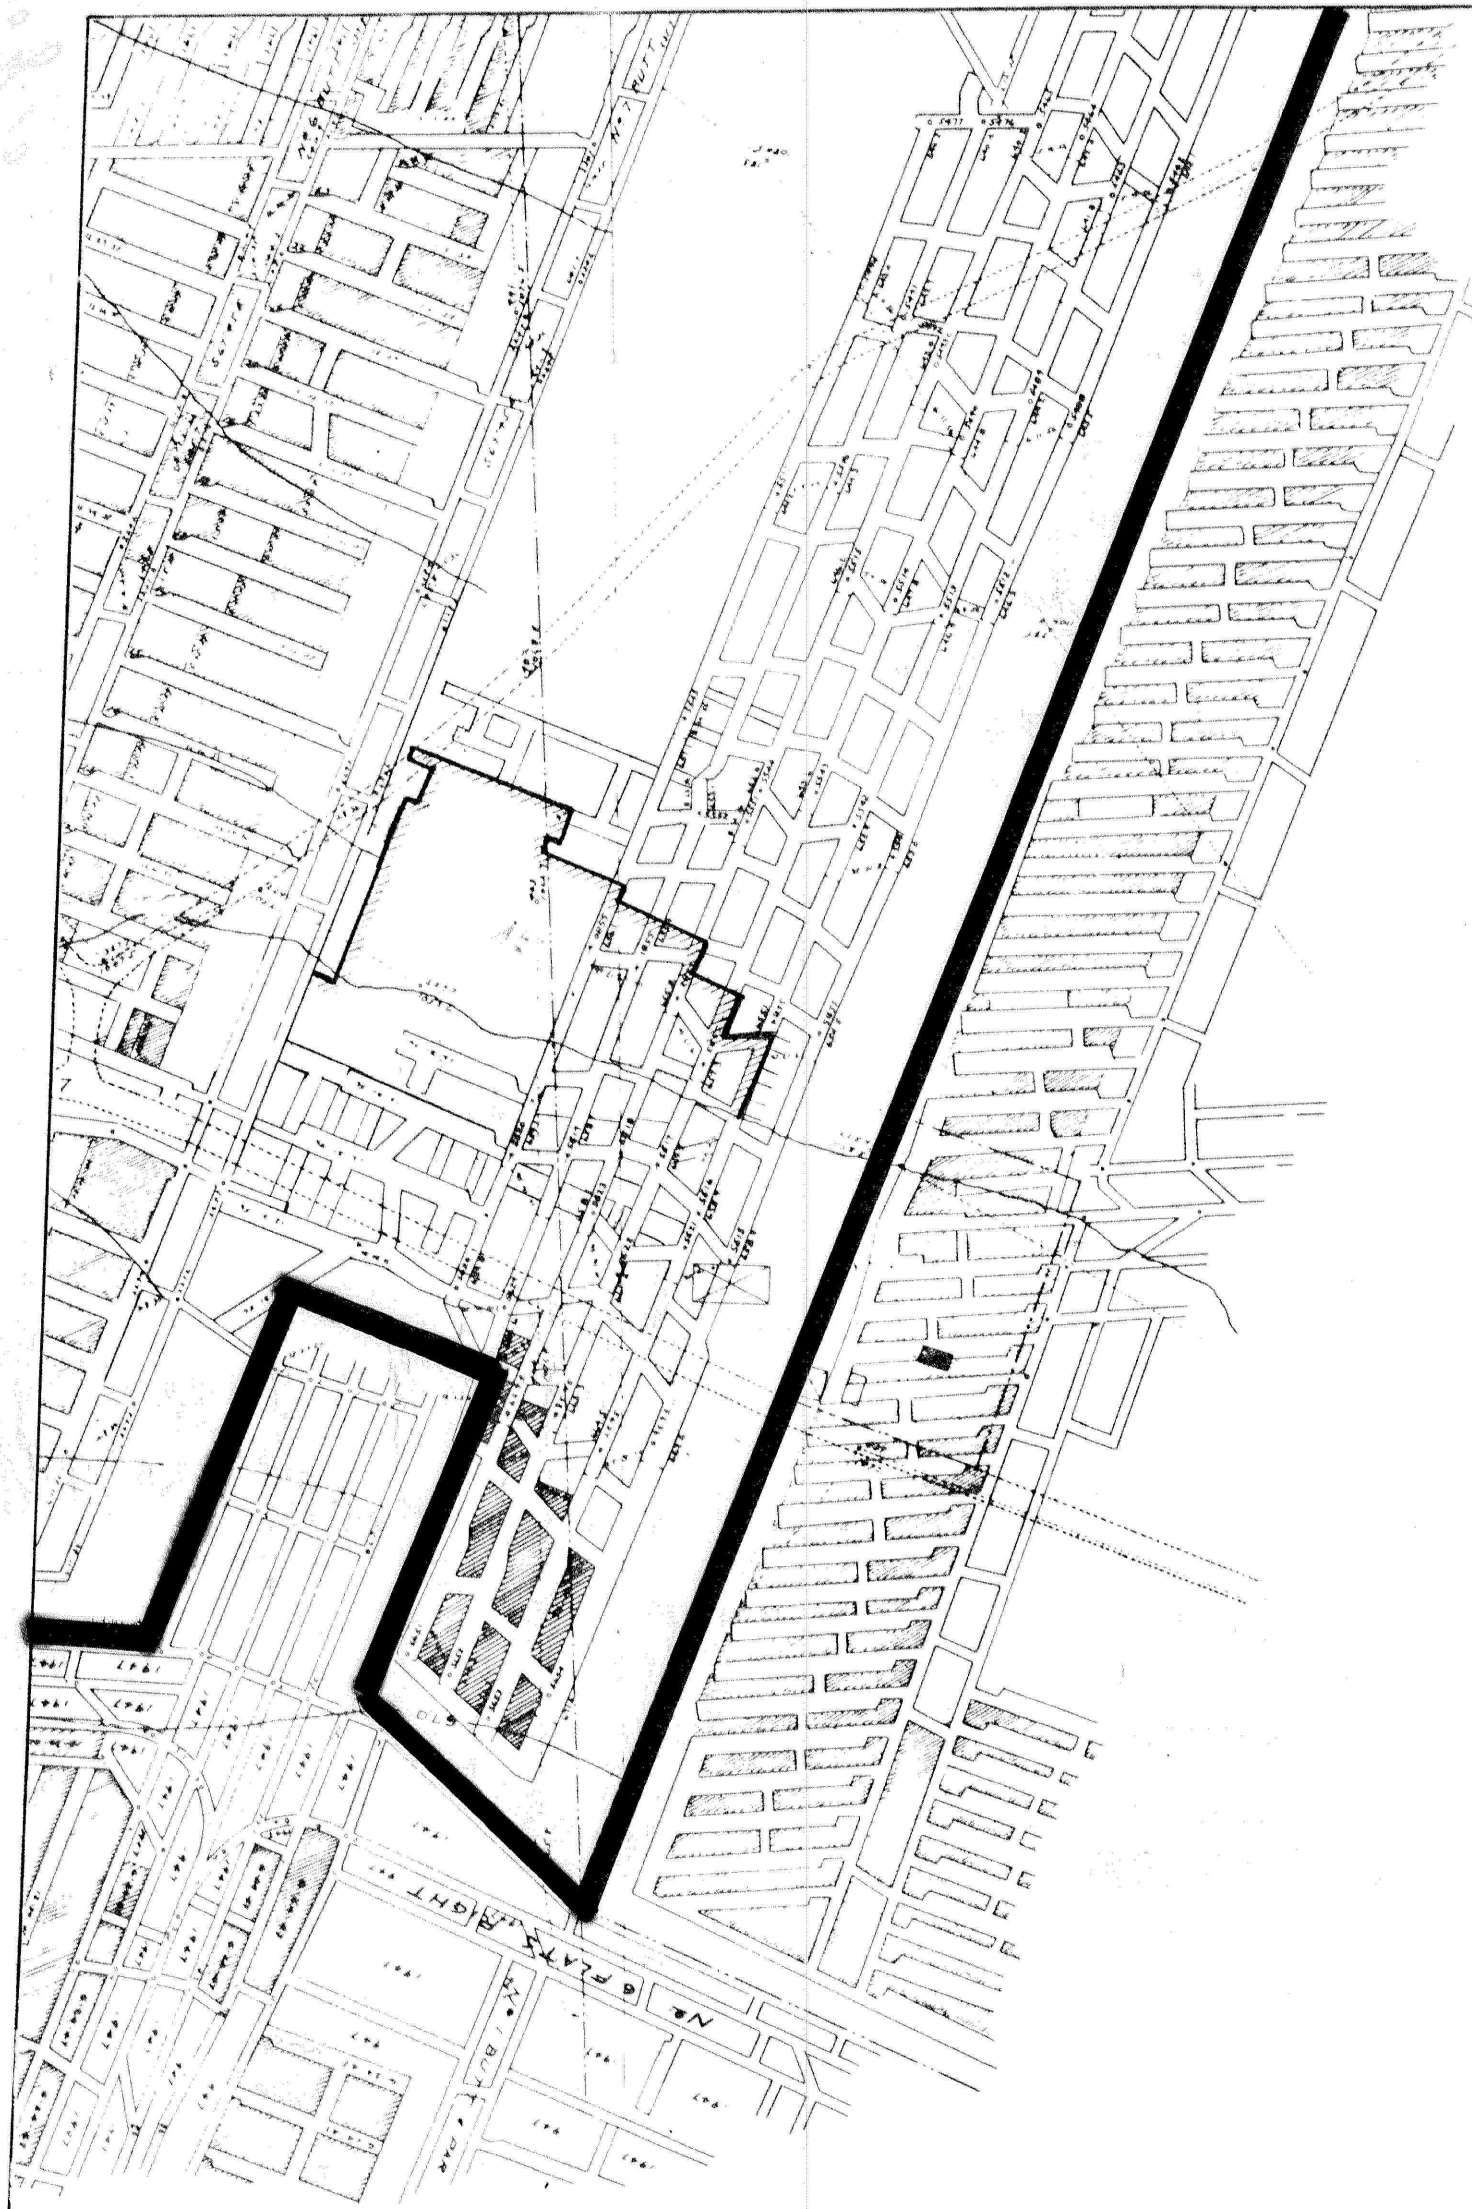

HUTCHINSON MINE

SURVEY DATE - 4-27-73
(FINAL)

SCALE 1" = 200'

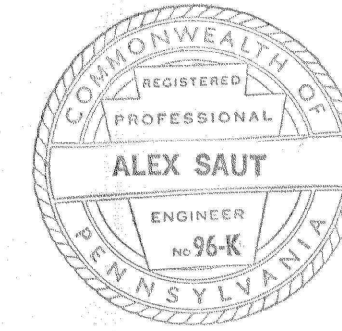

Alex Saut

#1572
8-5-99
CC