


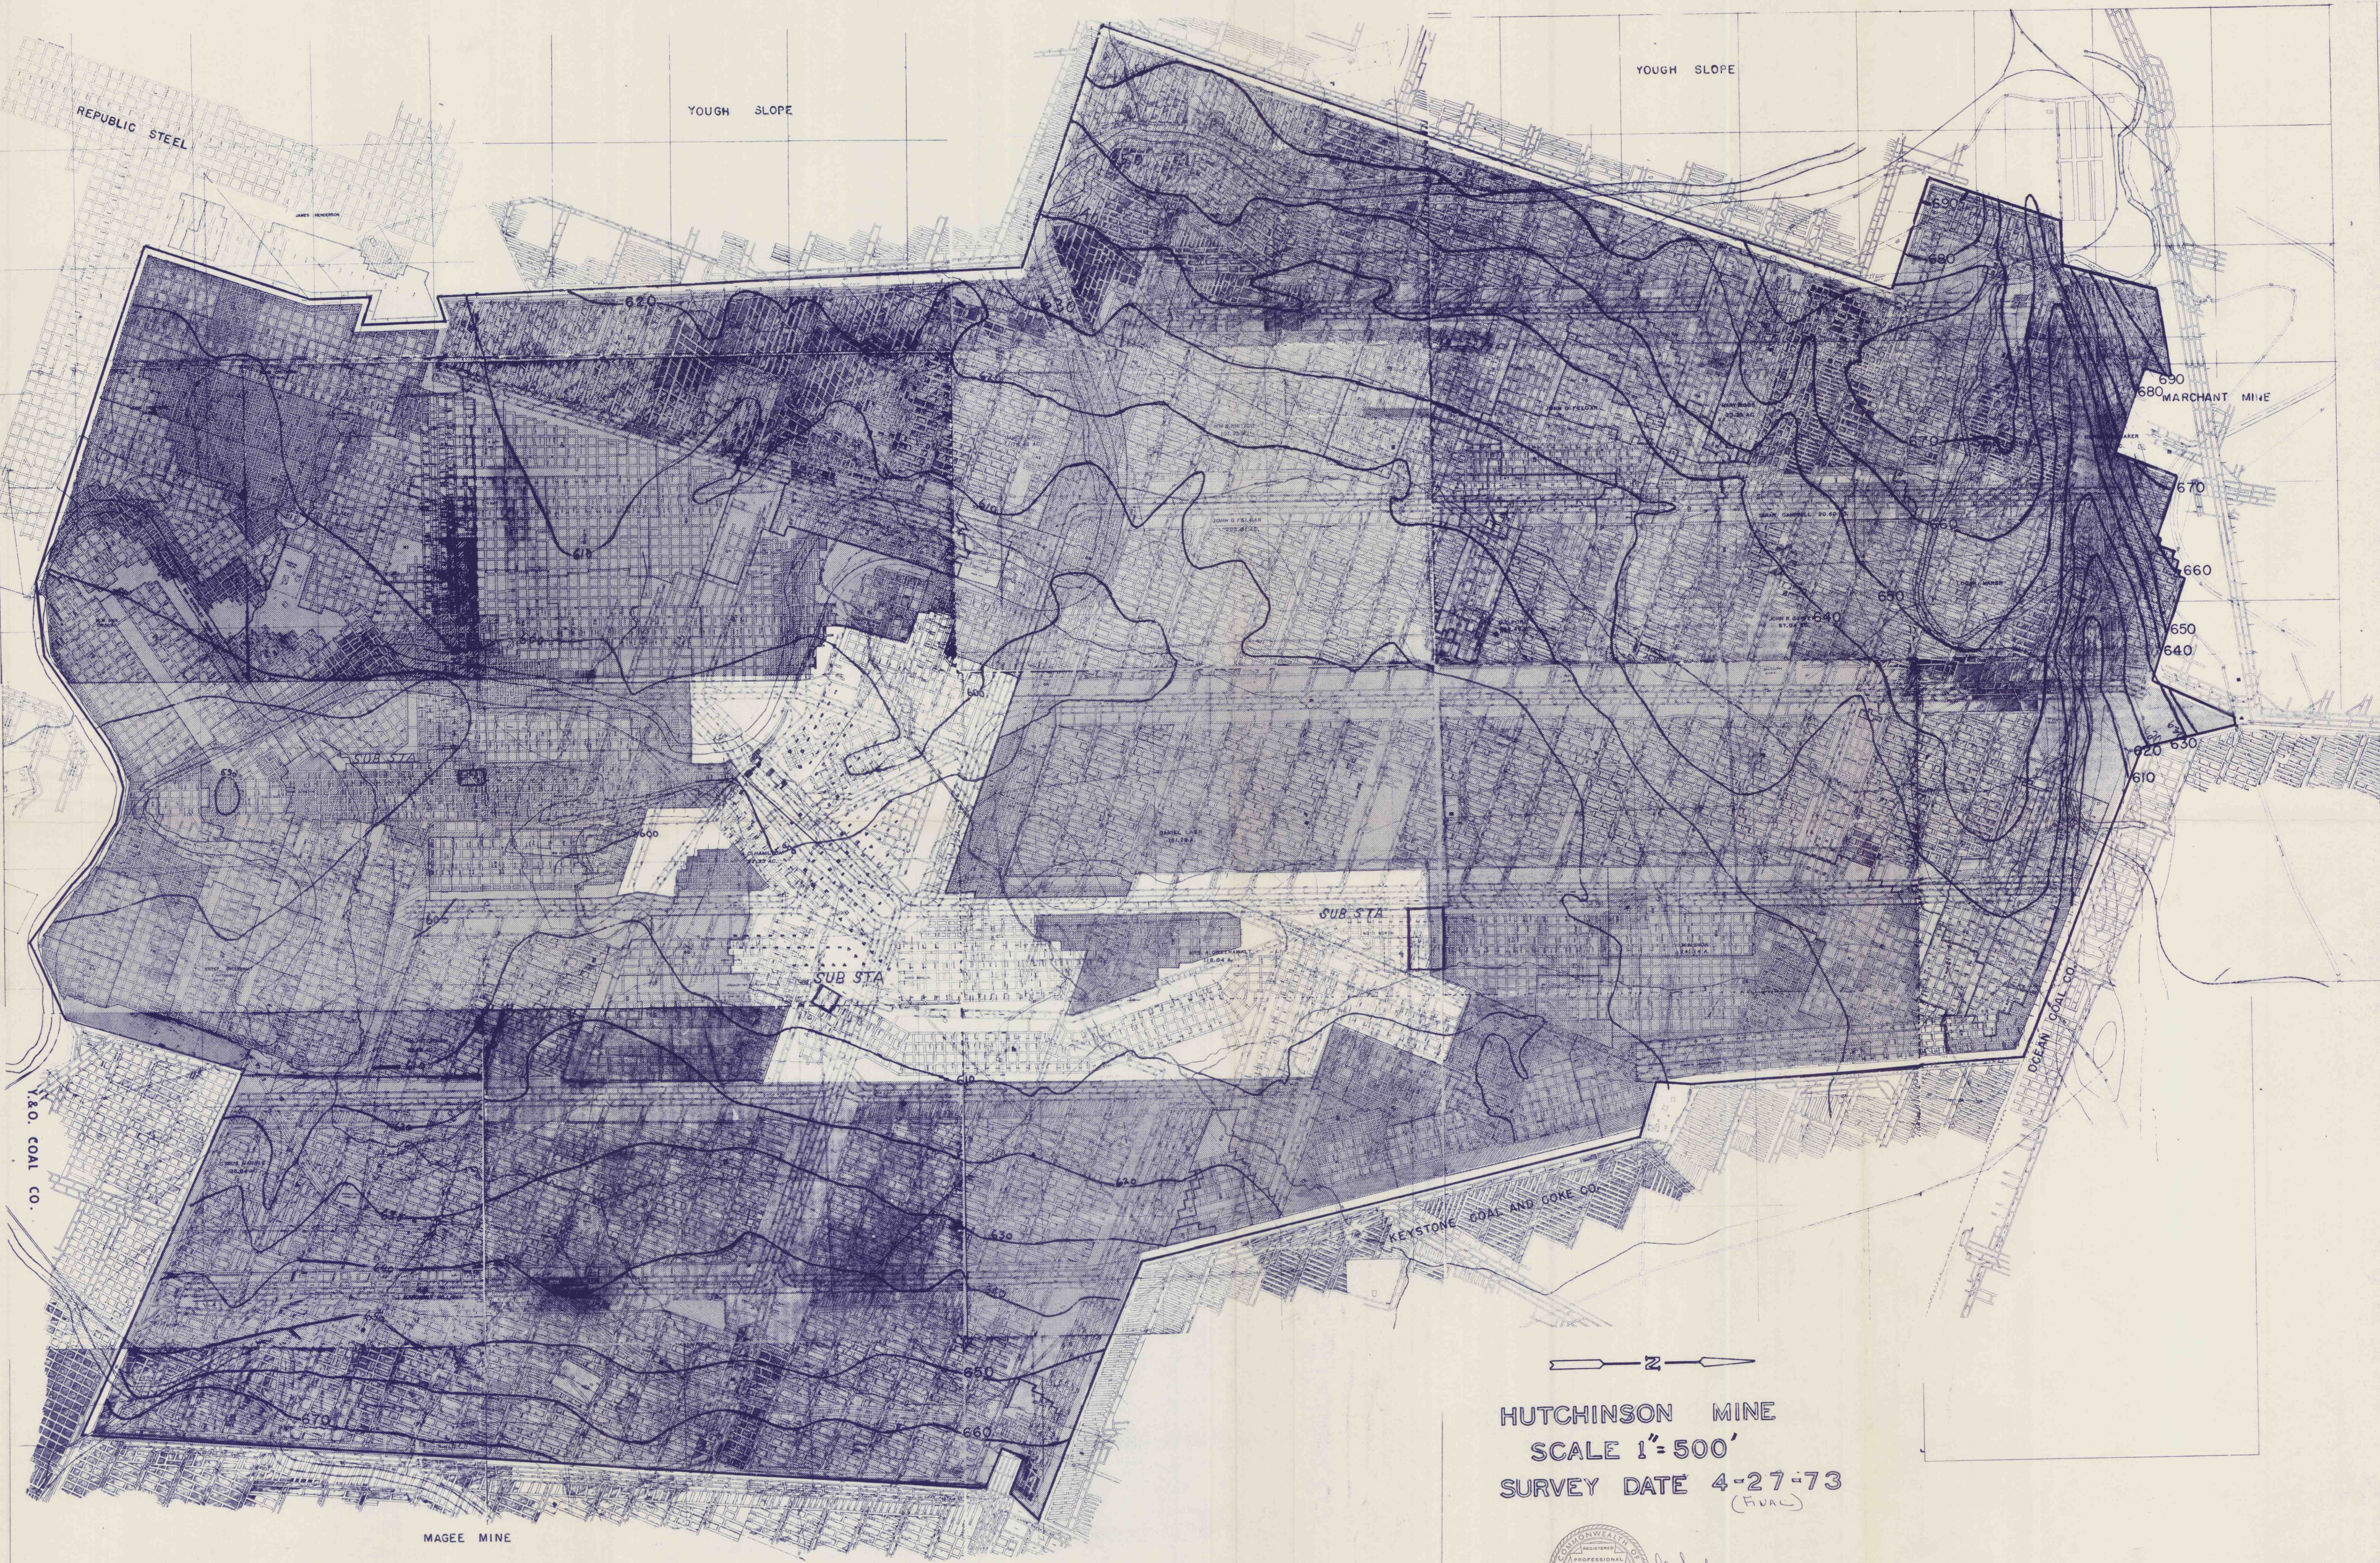

HUTCHINSON MINE
SCALE 1"=500'
SURVEY DATE 4-27-73



Saut