


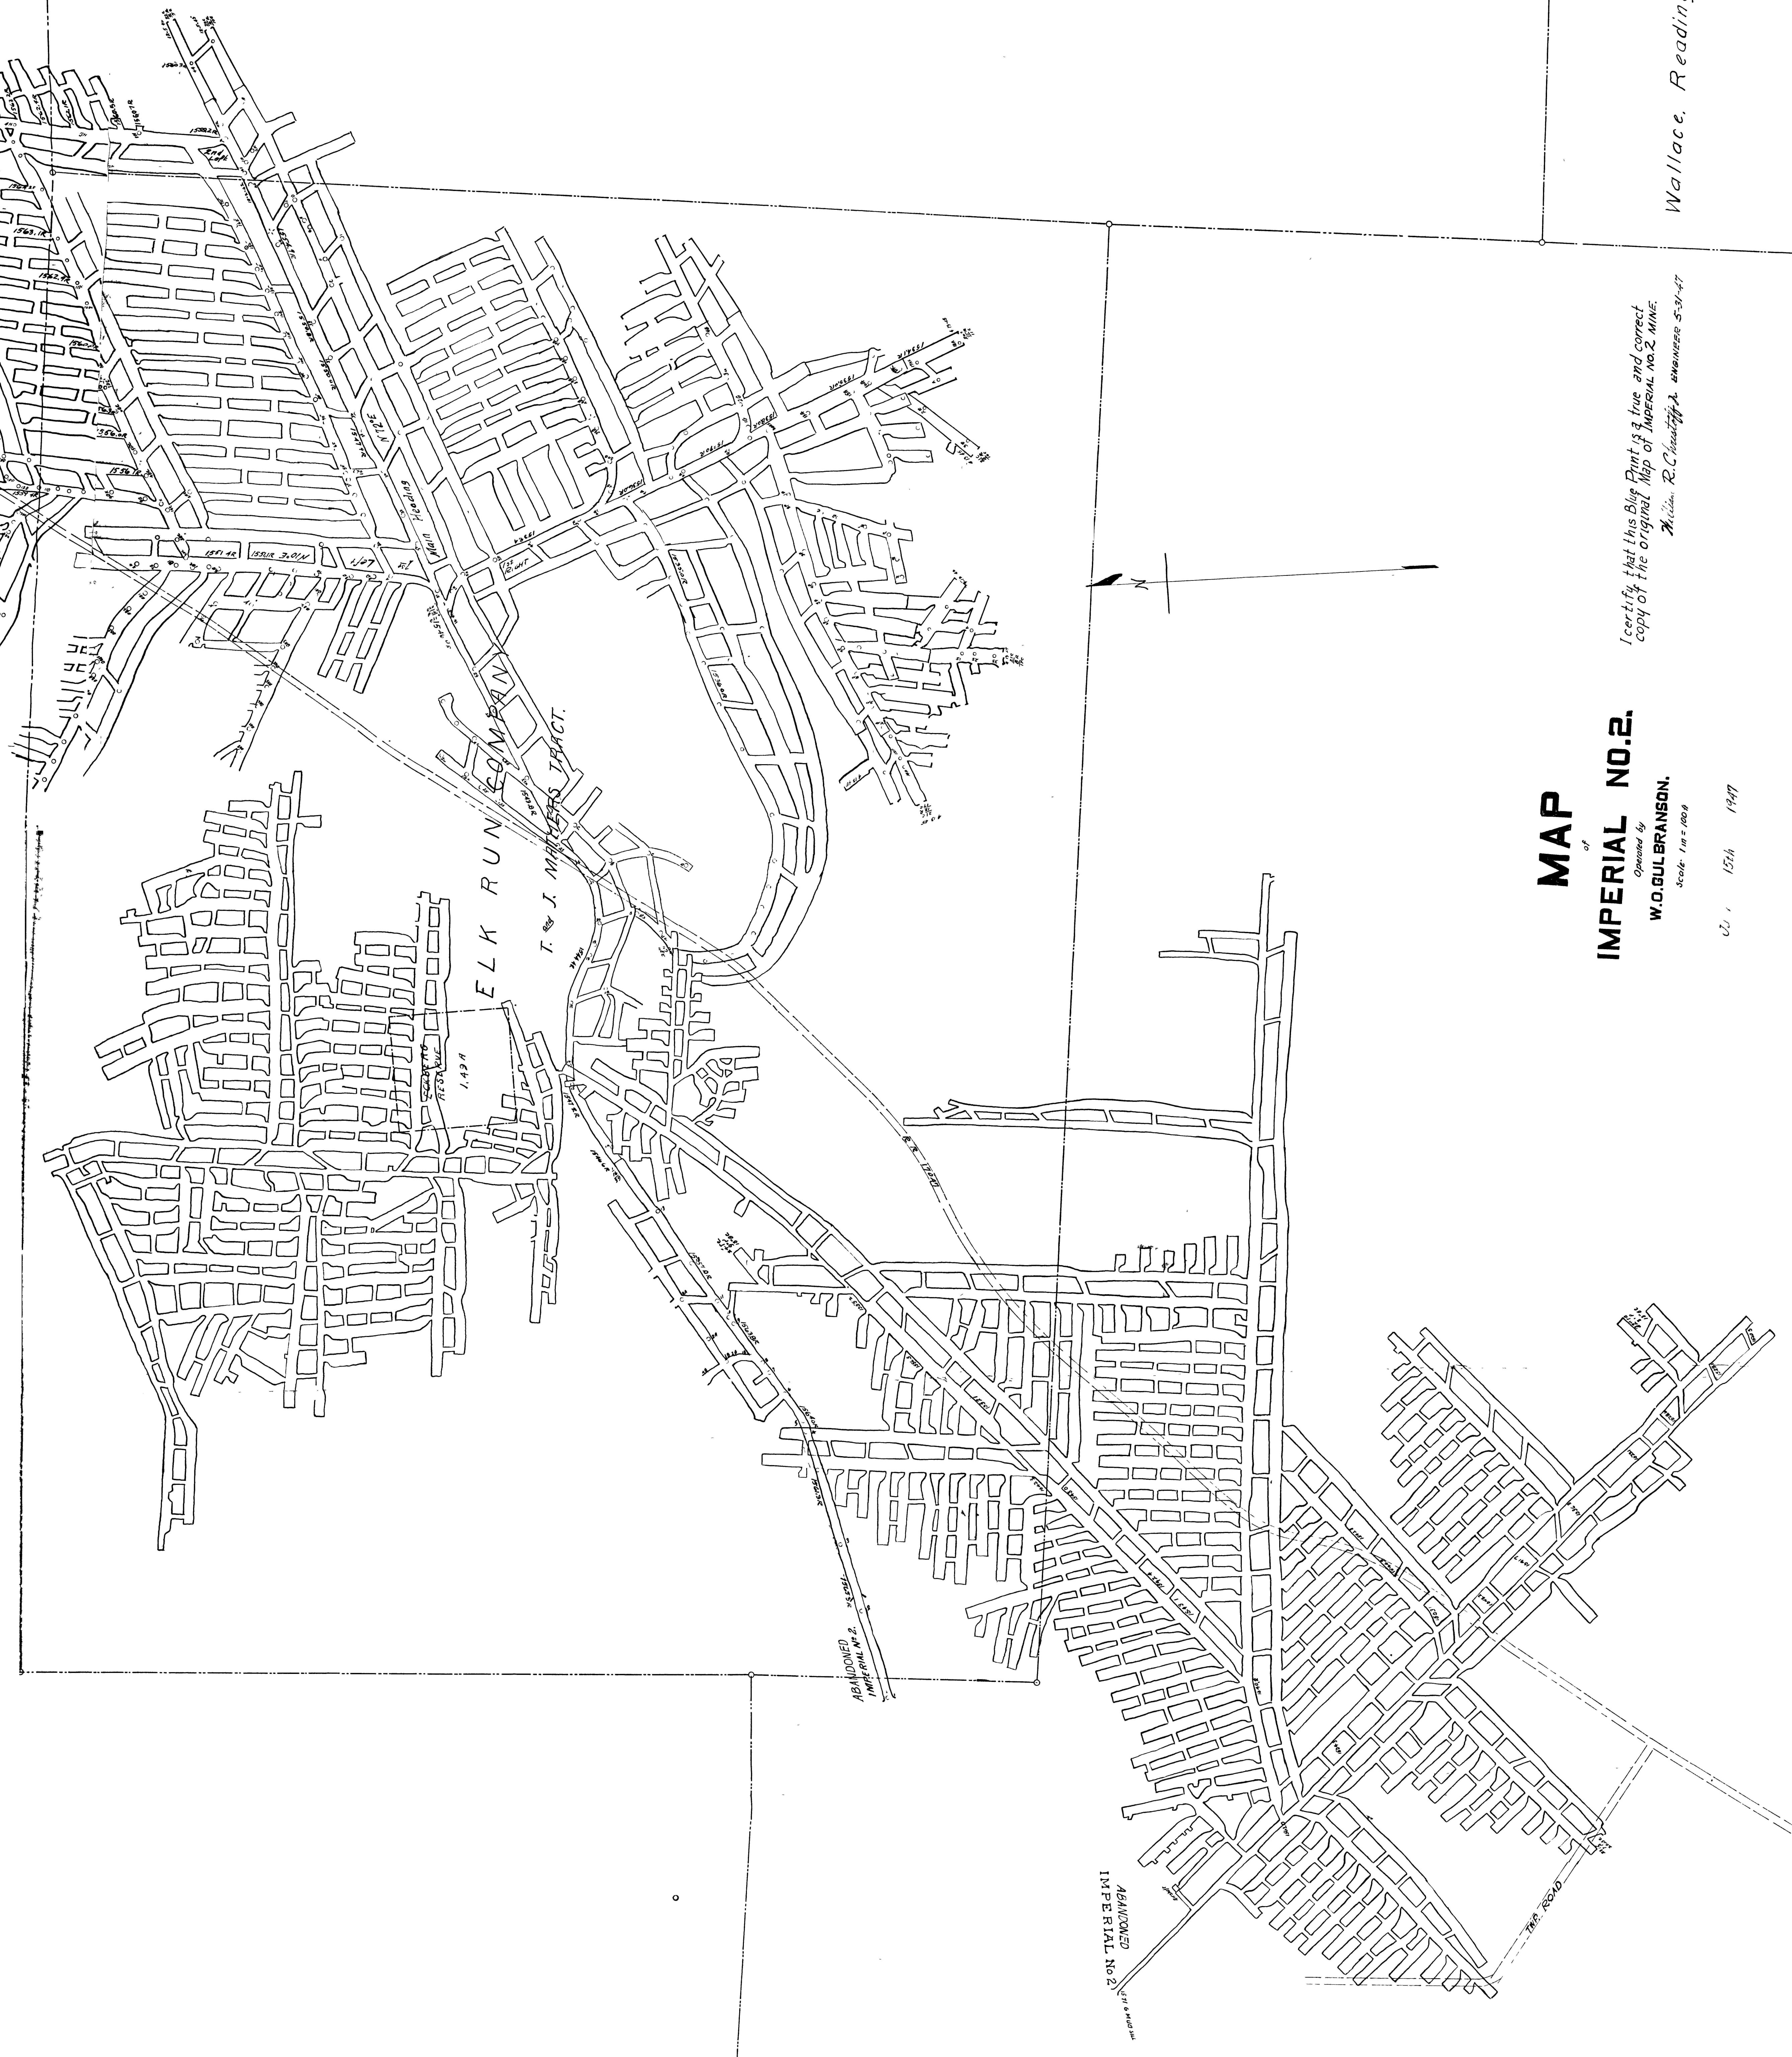

MAP
of
IMPERIAL NO. 2.
W.D. GILBRANSON,
Scale 1 in = 100 ft

I certify that this Big Print is a true and correct copy of the original Map of Imperial No. 2 Mine.

CU 1 15th 1947

Wallace, Readings & Richey

Wallace, Readings & Richey