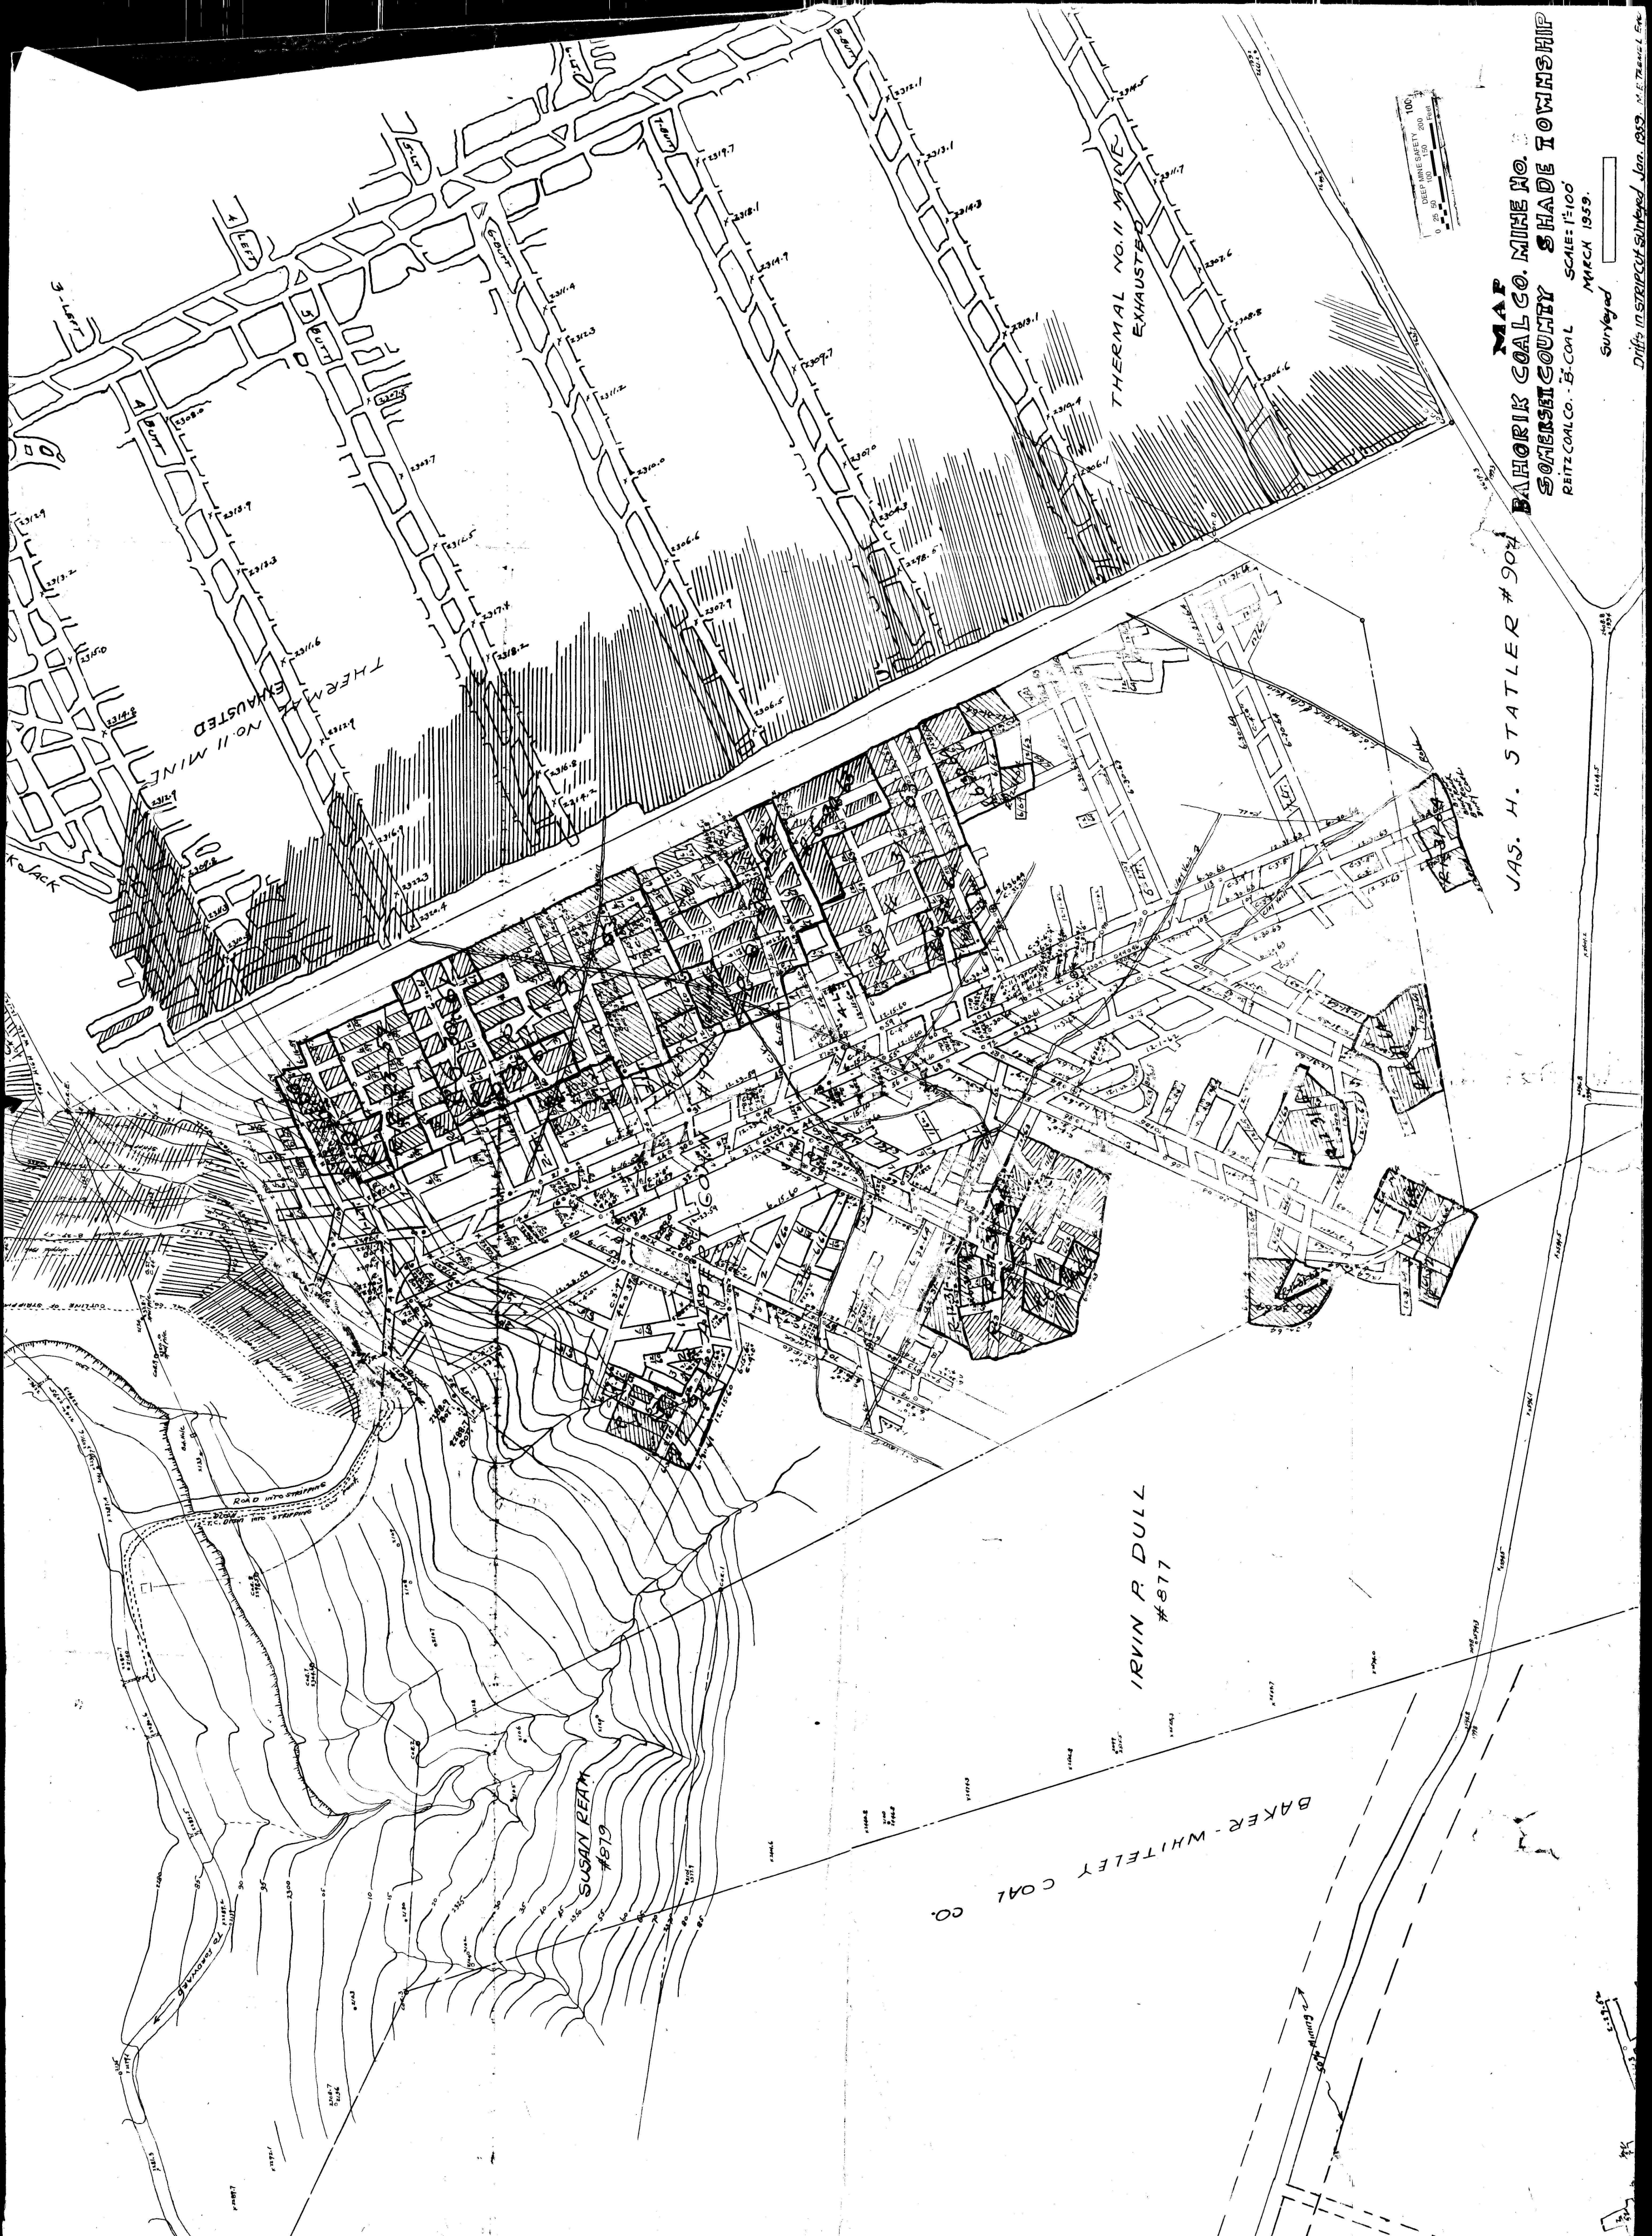


MAP
BAHORIK COAL CO. MINE NO. 11
SOMERSET COUNTY SHADE TOWNSHIP
REITZ COAL CO. - B-COAL
SCALE: 1"=100'
MARCH 1959.
Surveyed
Drifts in STRIP CUT Surveyed Jan. 1959. M.E. TRIMMEL, Eng.

IRVIN R. DULL
#577

SUSAN REAY
#579

BAKER-WHITELEY COAL CO.

JAS. H. STATLER #904