



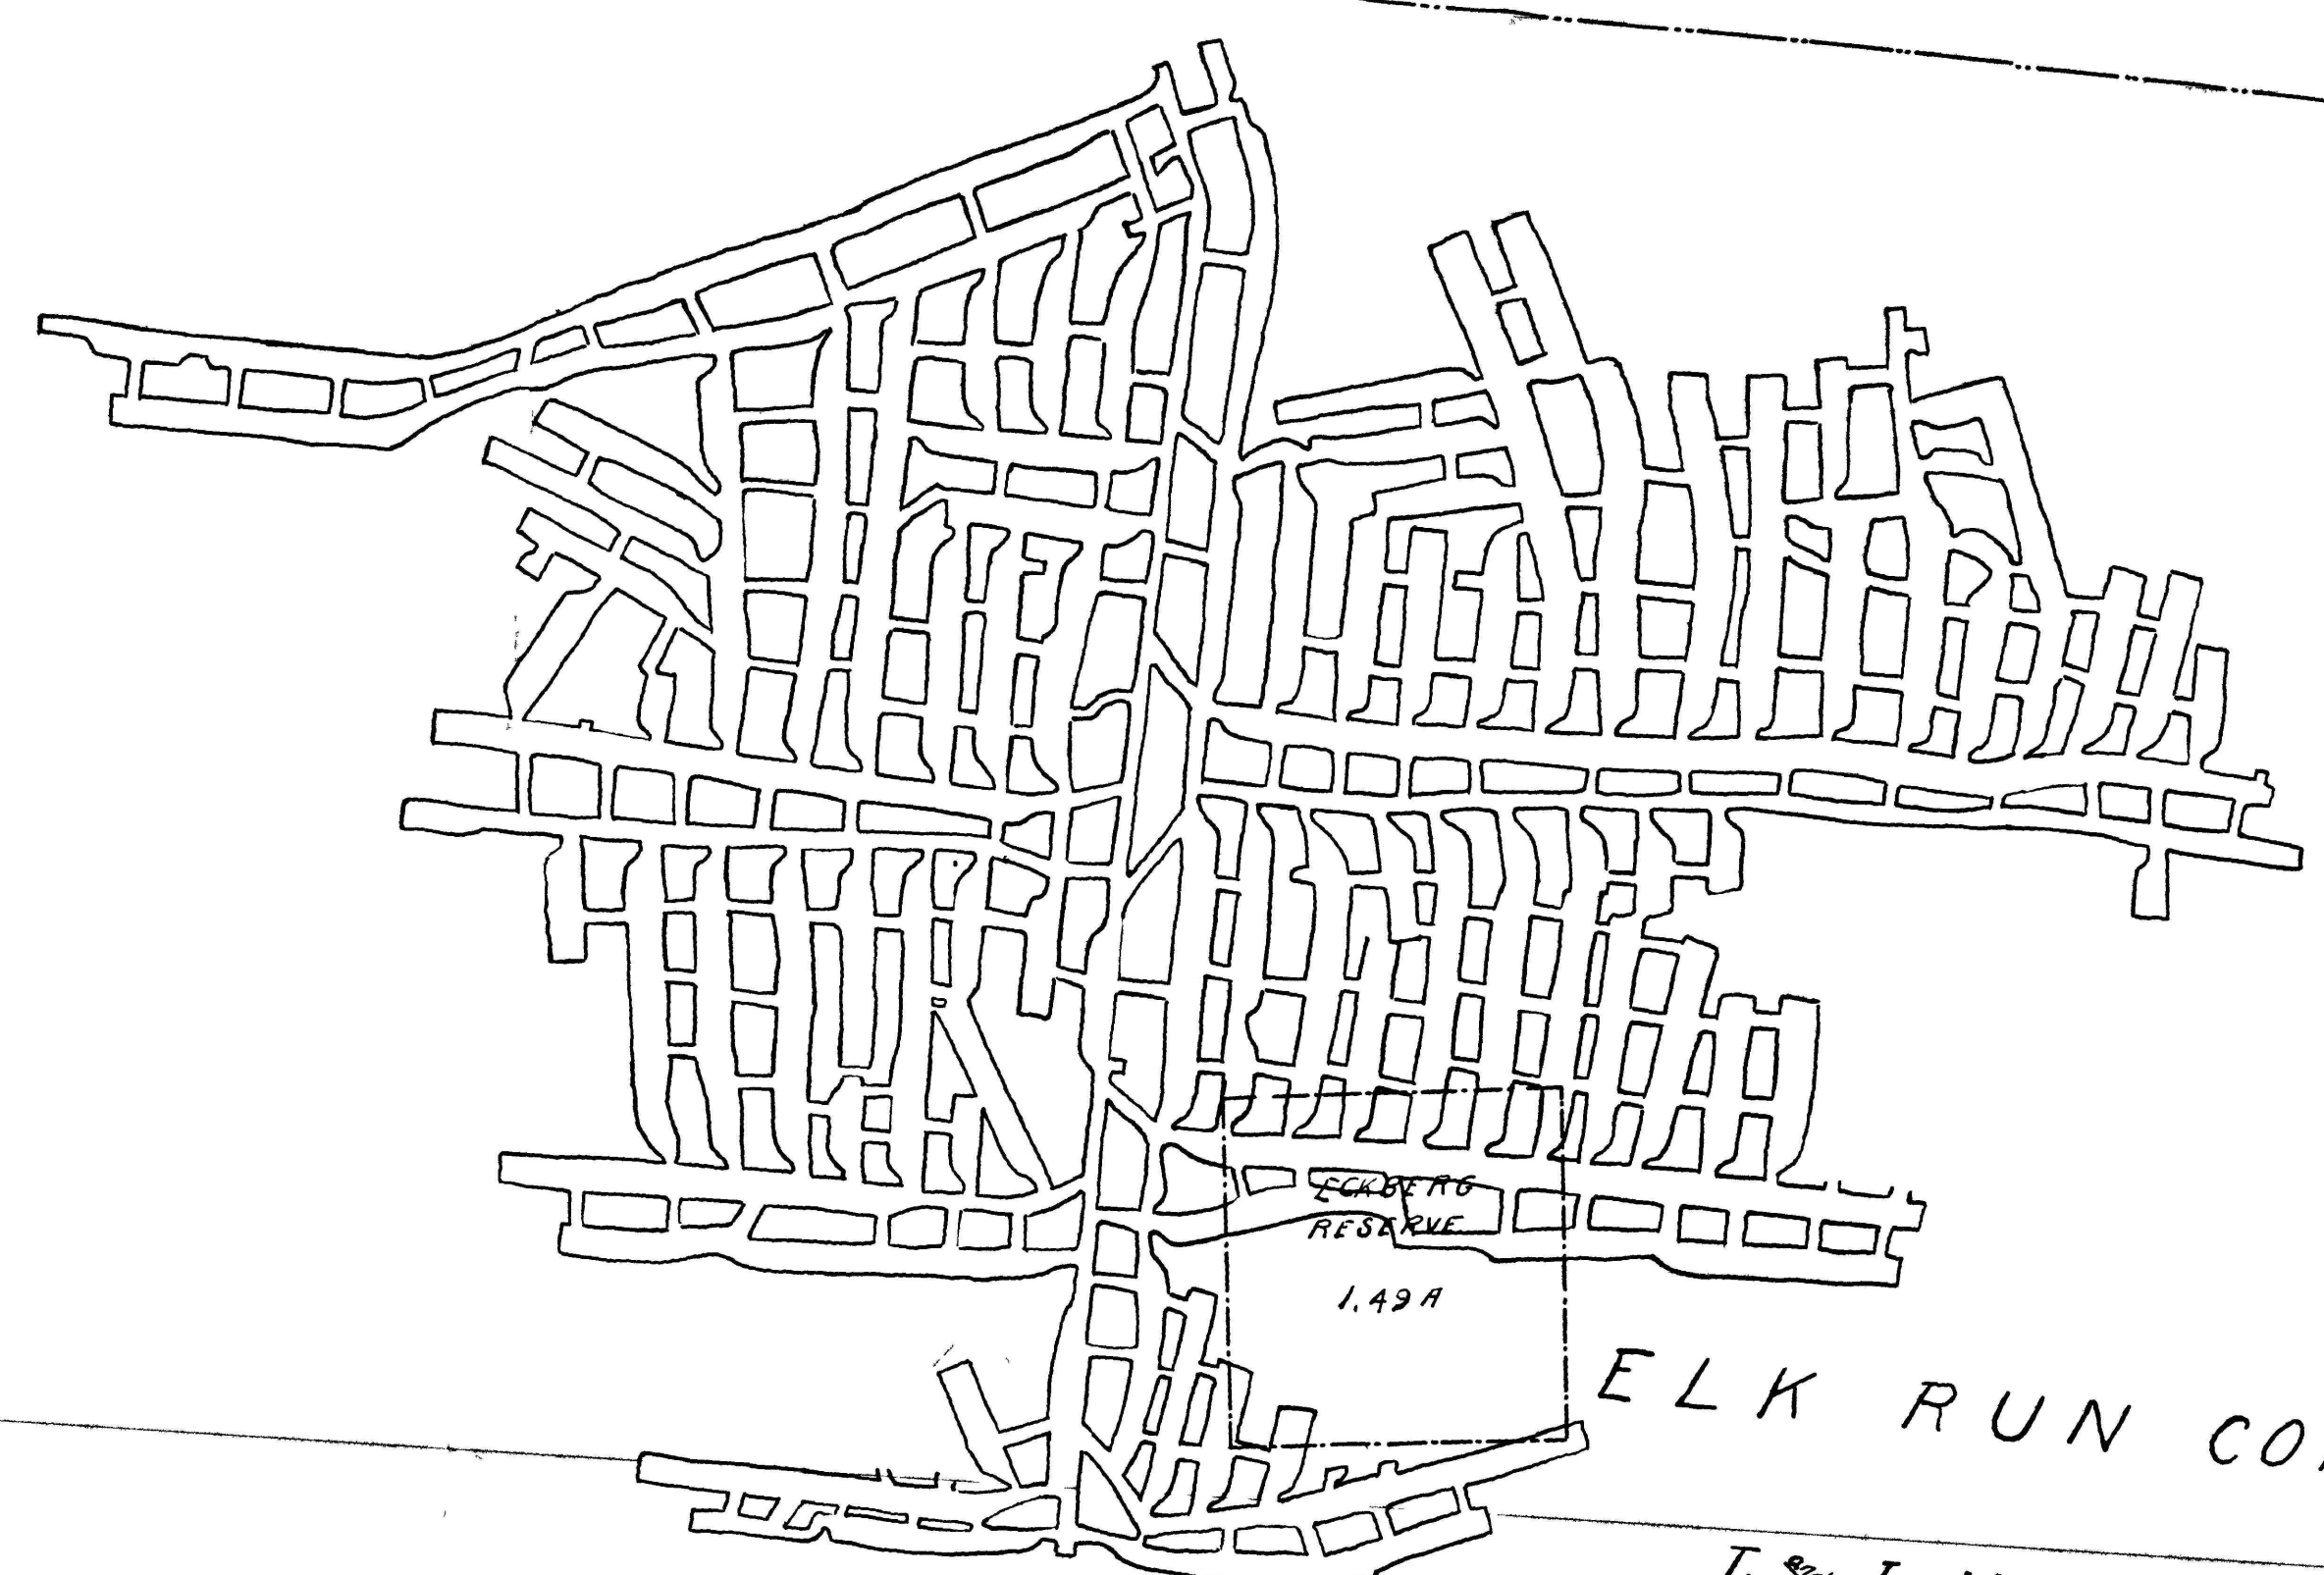

ELK RUN COMPANY
T. & J. MATHERS TRACT.

IMPERIAL NO. 2

IMPERIAL NO. 2

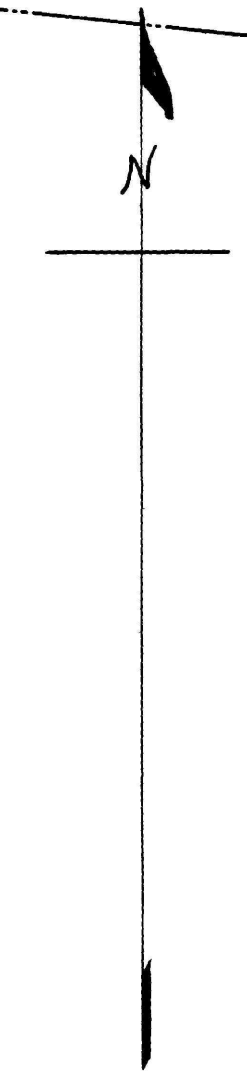

Wallace, Reading & Richey.

MAP
OF
IMPERIAL NO. 2.
Operated by
W.D. GULBRANSON.
Scale 1 in = 100 ft.

Wallace, Reading & Richey