


UNITED STATES
DEPARTMENT OF THE INTERIOR
GEOLOGICAL SURVEY

STATE OF PENNSYLVANIA
REPRESENTED BY THE
DEPARTMENT OF INTERNAL AFFAIRS
TOPOGRAPHIC AND GEOLOGIC SURVEY

PENNSYLVANIA
BERLIN QUADRANGLE

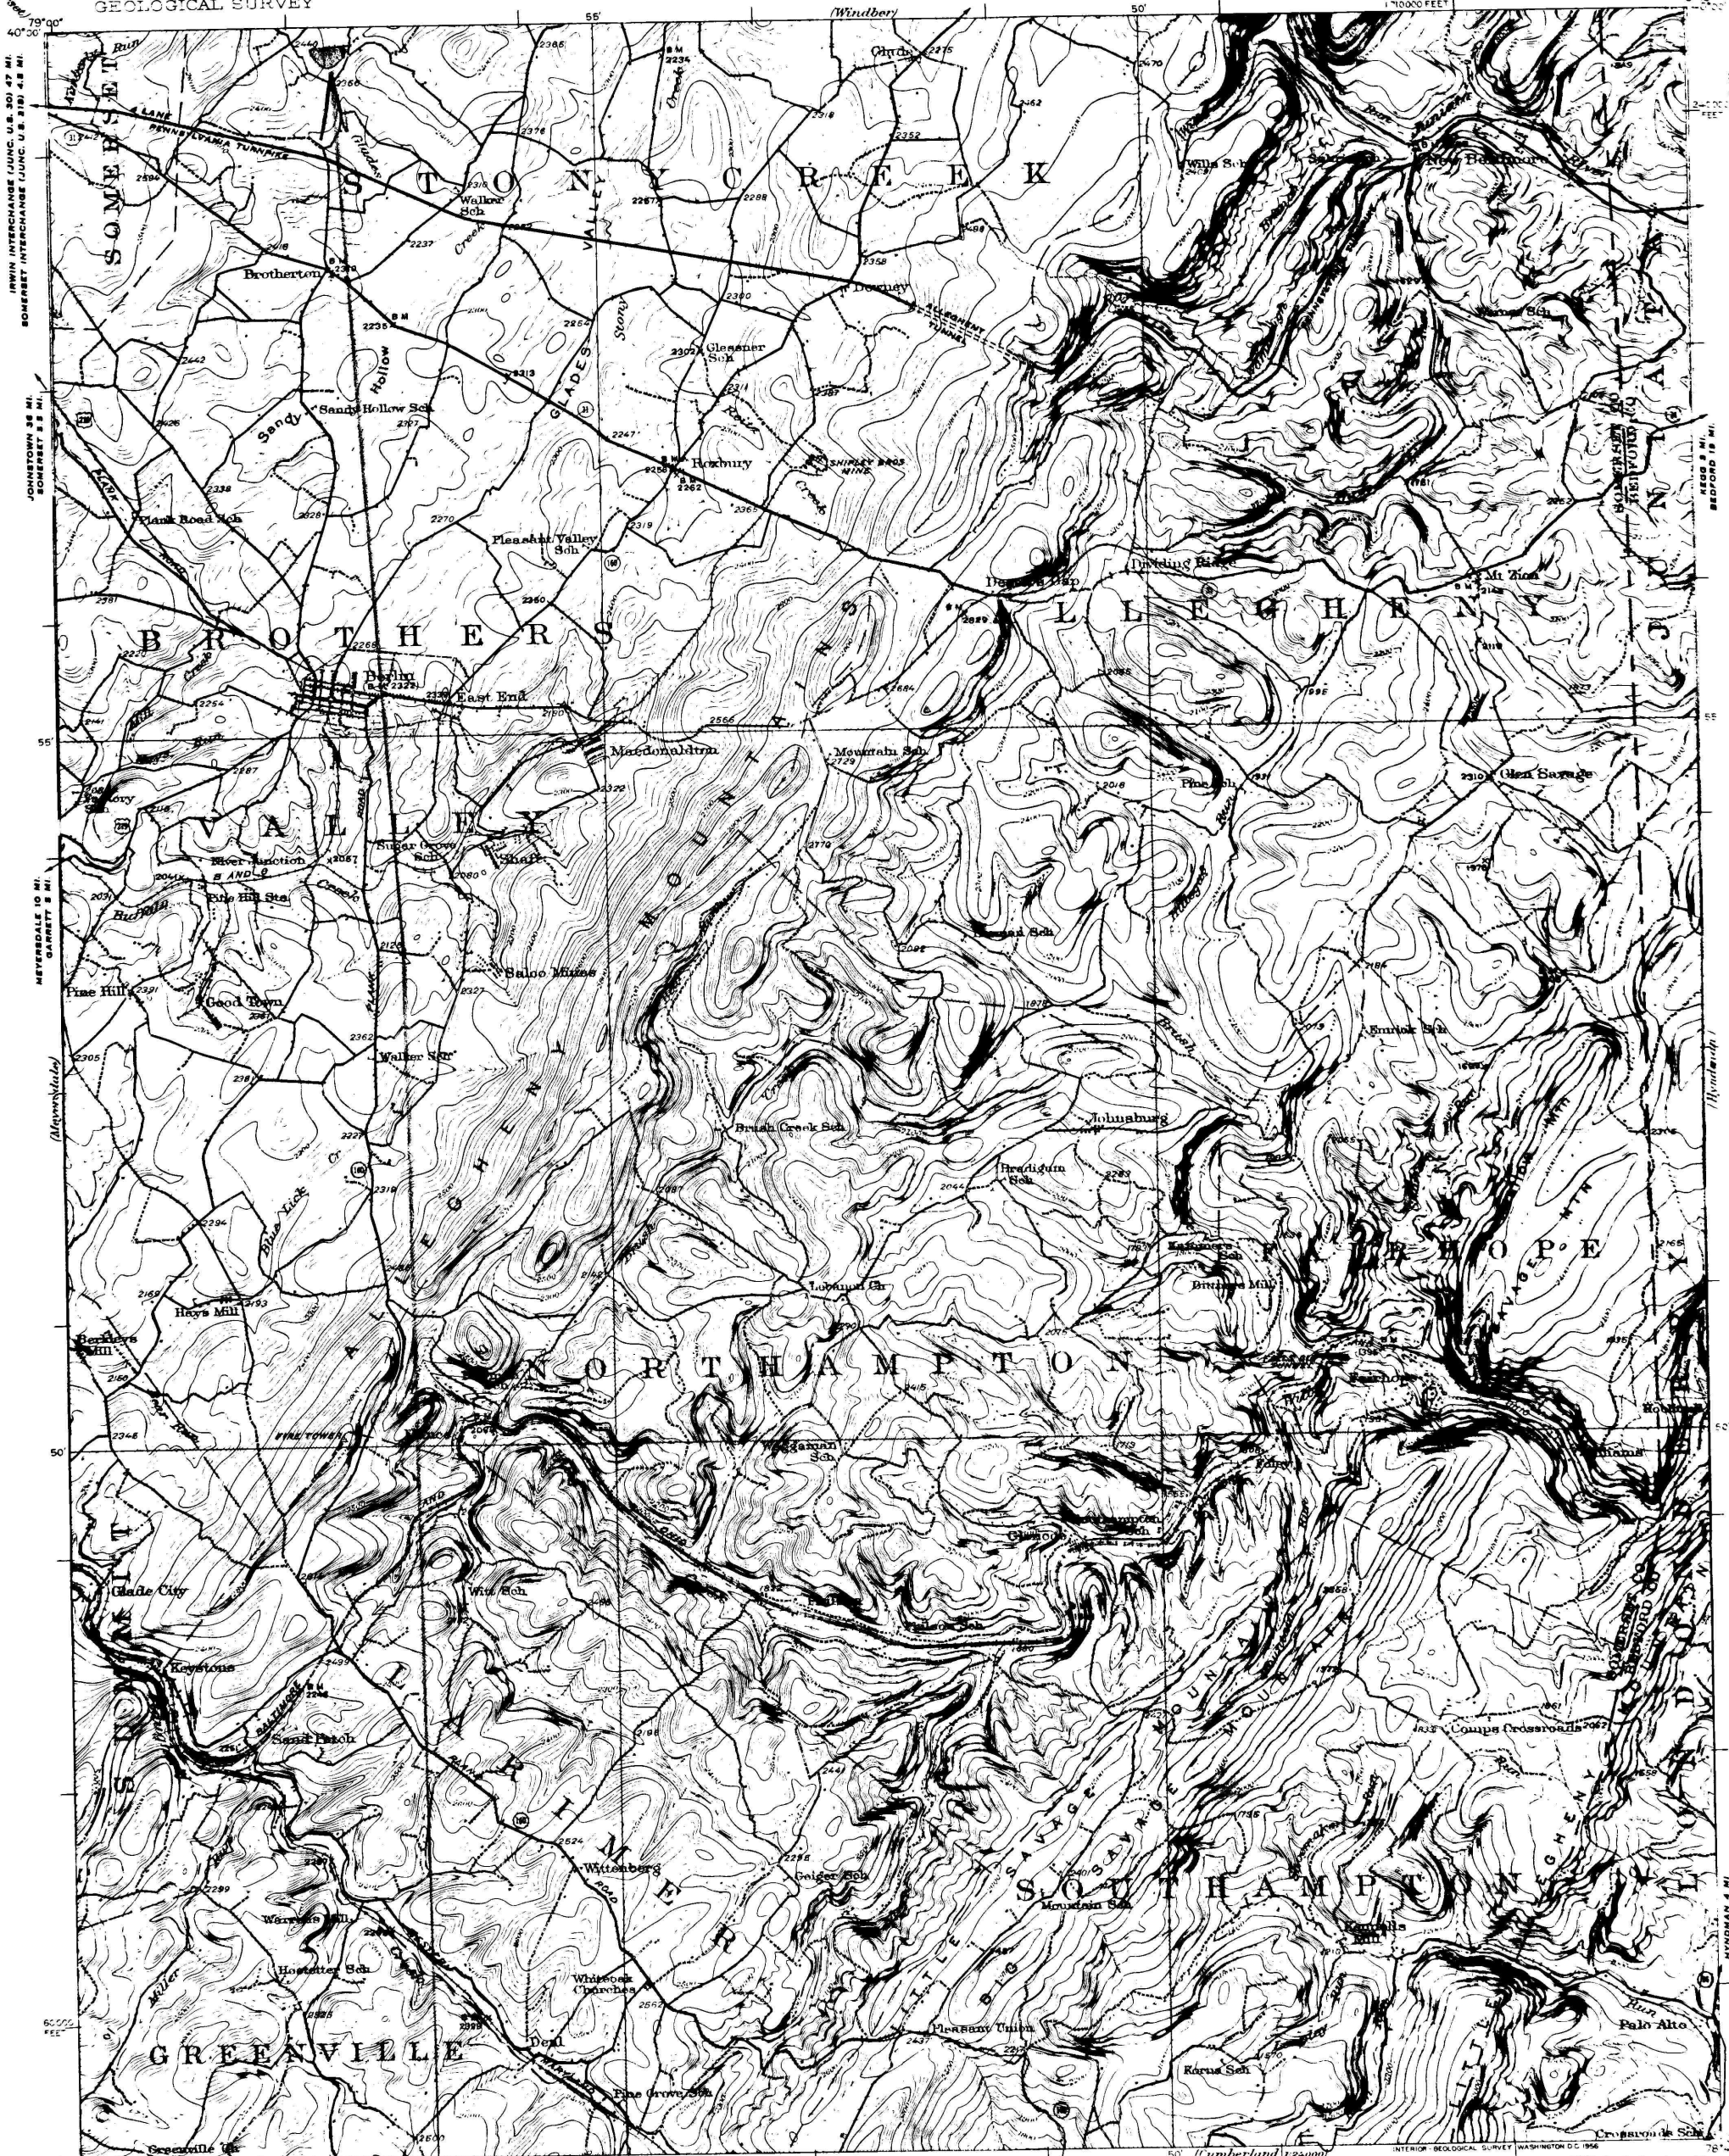

Topography by J.F. McBeth, M.A. Poudubush,
H.A. Bess, and Matt Jaurin
Surveyed in 1923

THOMAS LUCE
WALTER KOWALESKI

MINE No. 4
SEPT. 2, 1966
V.E. ERICKSON R.P.E. #7074

STONYCREEK TWP.
SOMERSET COUNTY

PERMIT NUMBER 571

"D" OR LOWER FREEPORT SEAM

FIELD COPY

FOR SALE BY U.S. GEOLOGICAL SURVEY, WASHINGTON 25, D.C.
A FOLDER DESCRIBING TOPOGRAPHIC MAPS AND SYMBOLS IS AVAILABLE ON REQUEST

Heavy duty
Medium duty

