


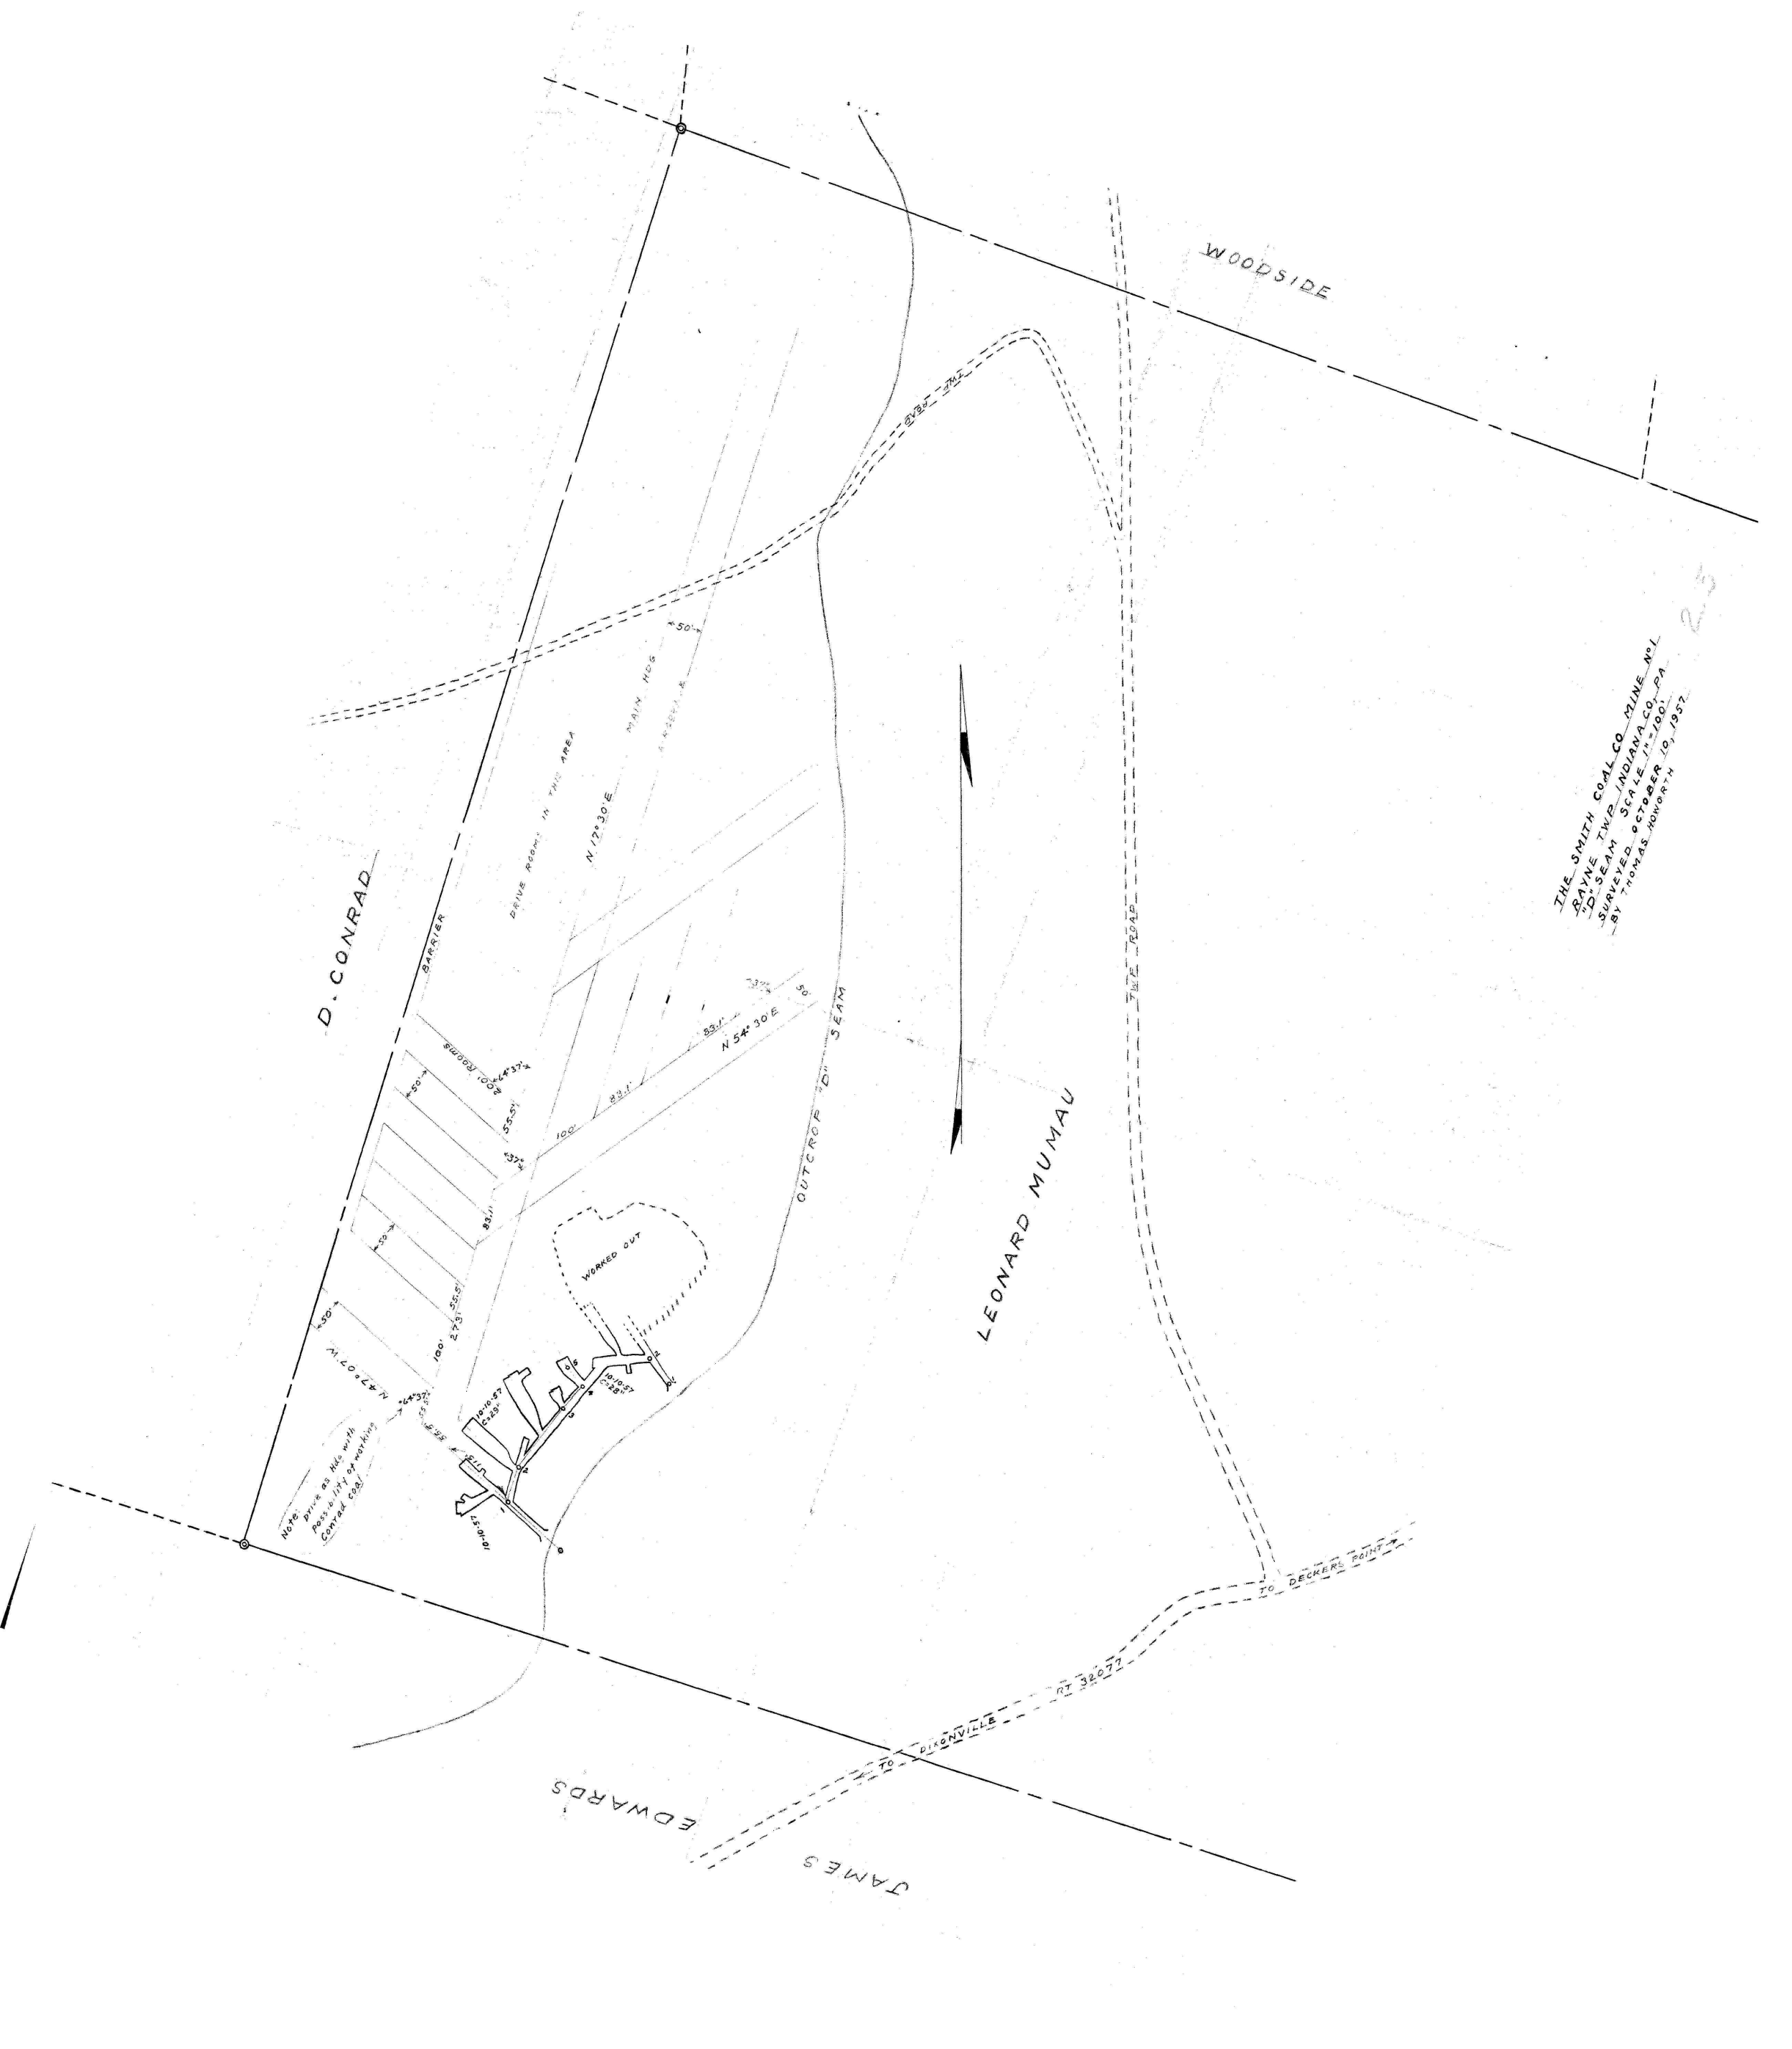

THE SMITH COAL CO. MINE No. 1,  
DAYNE TWP., INDIANA CO., PA.  
D. SEAM SCALE 1"=100'.  
SURVEYED OCTOBER 10, 1957.  
BY THOMAS HOWARTH