


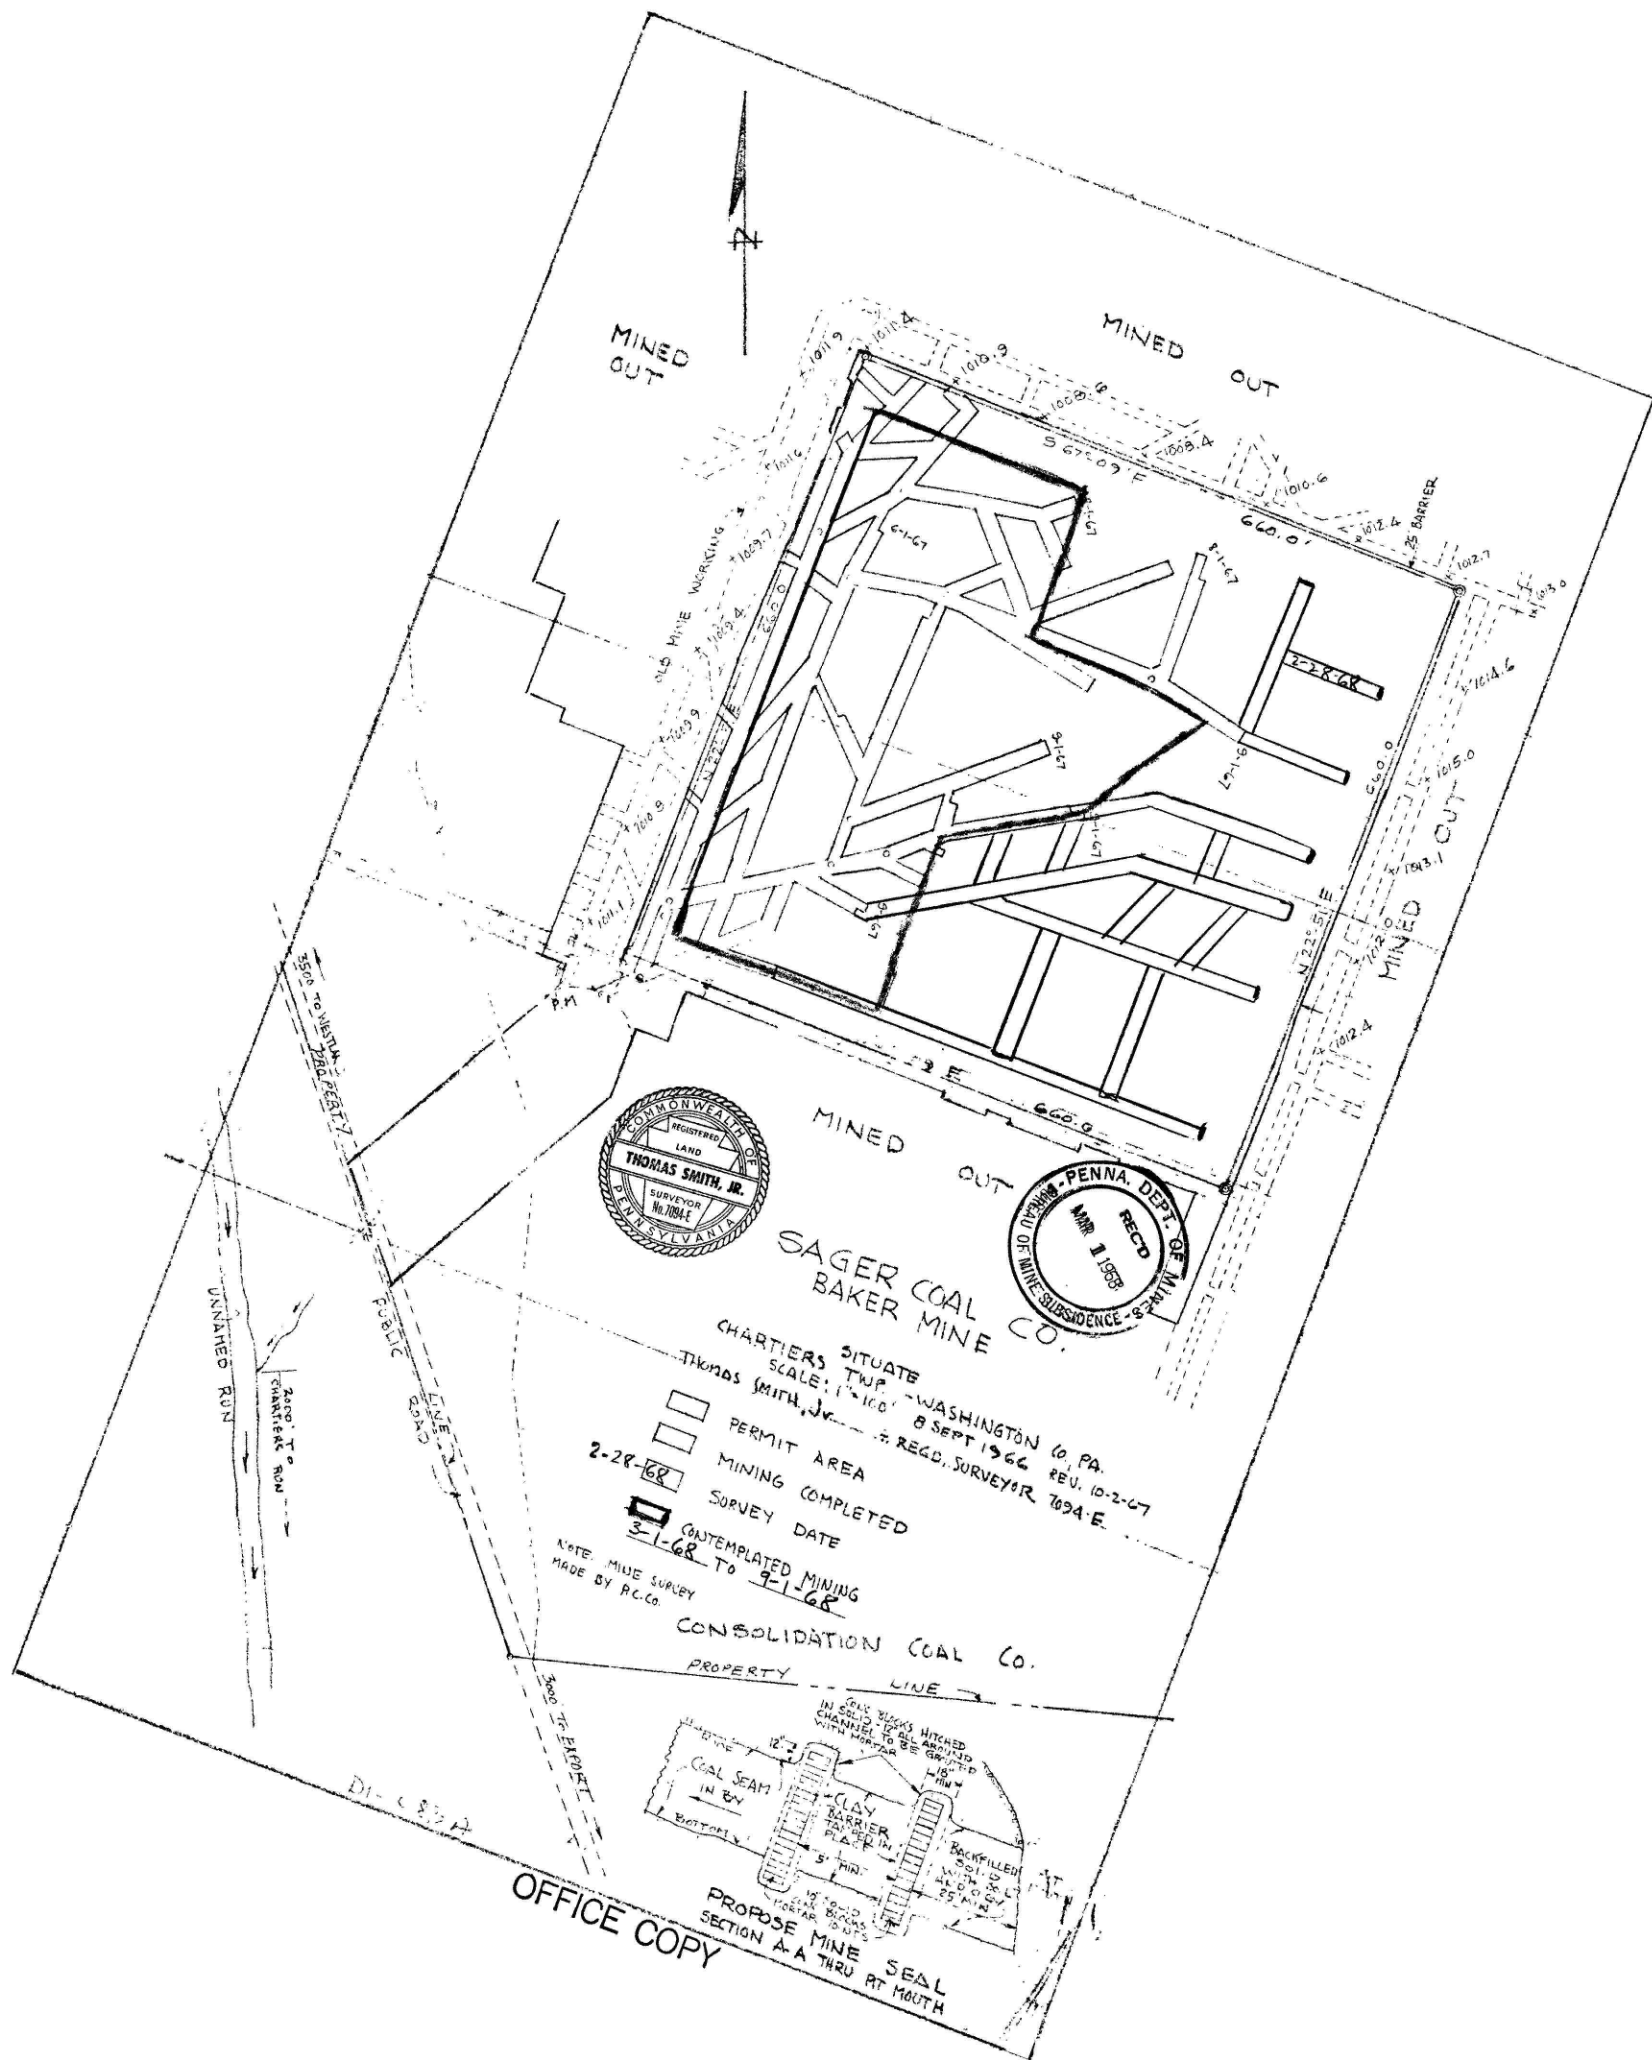

OFFICE COPY