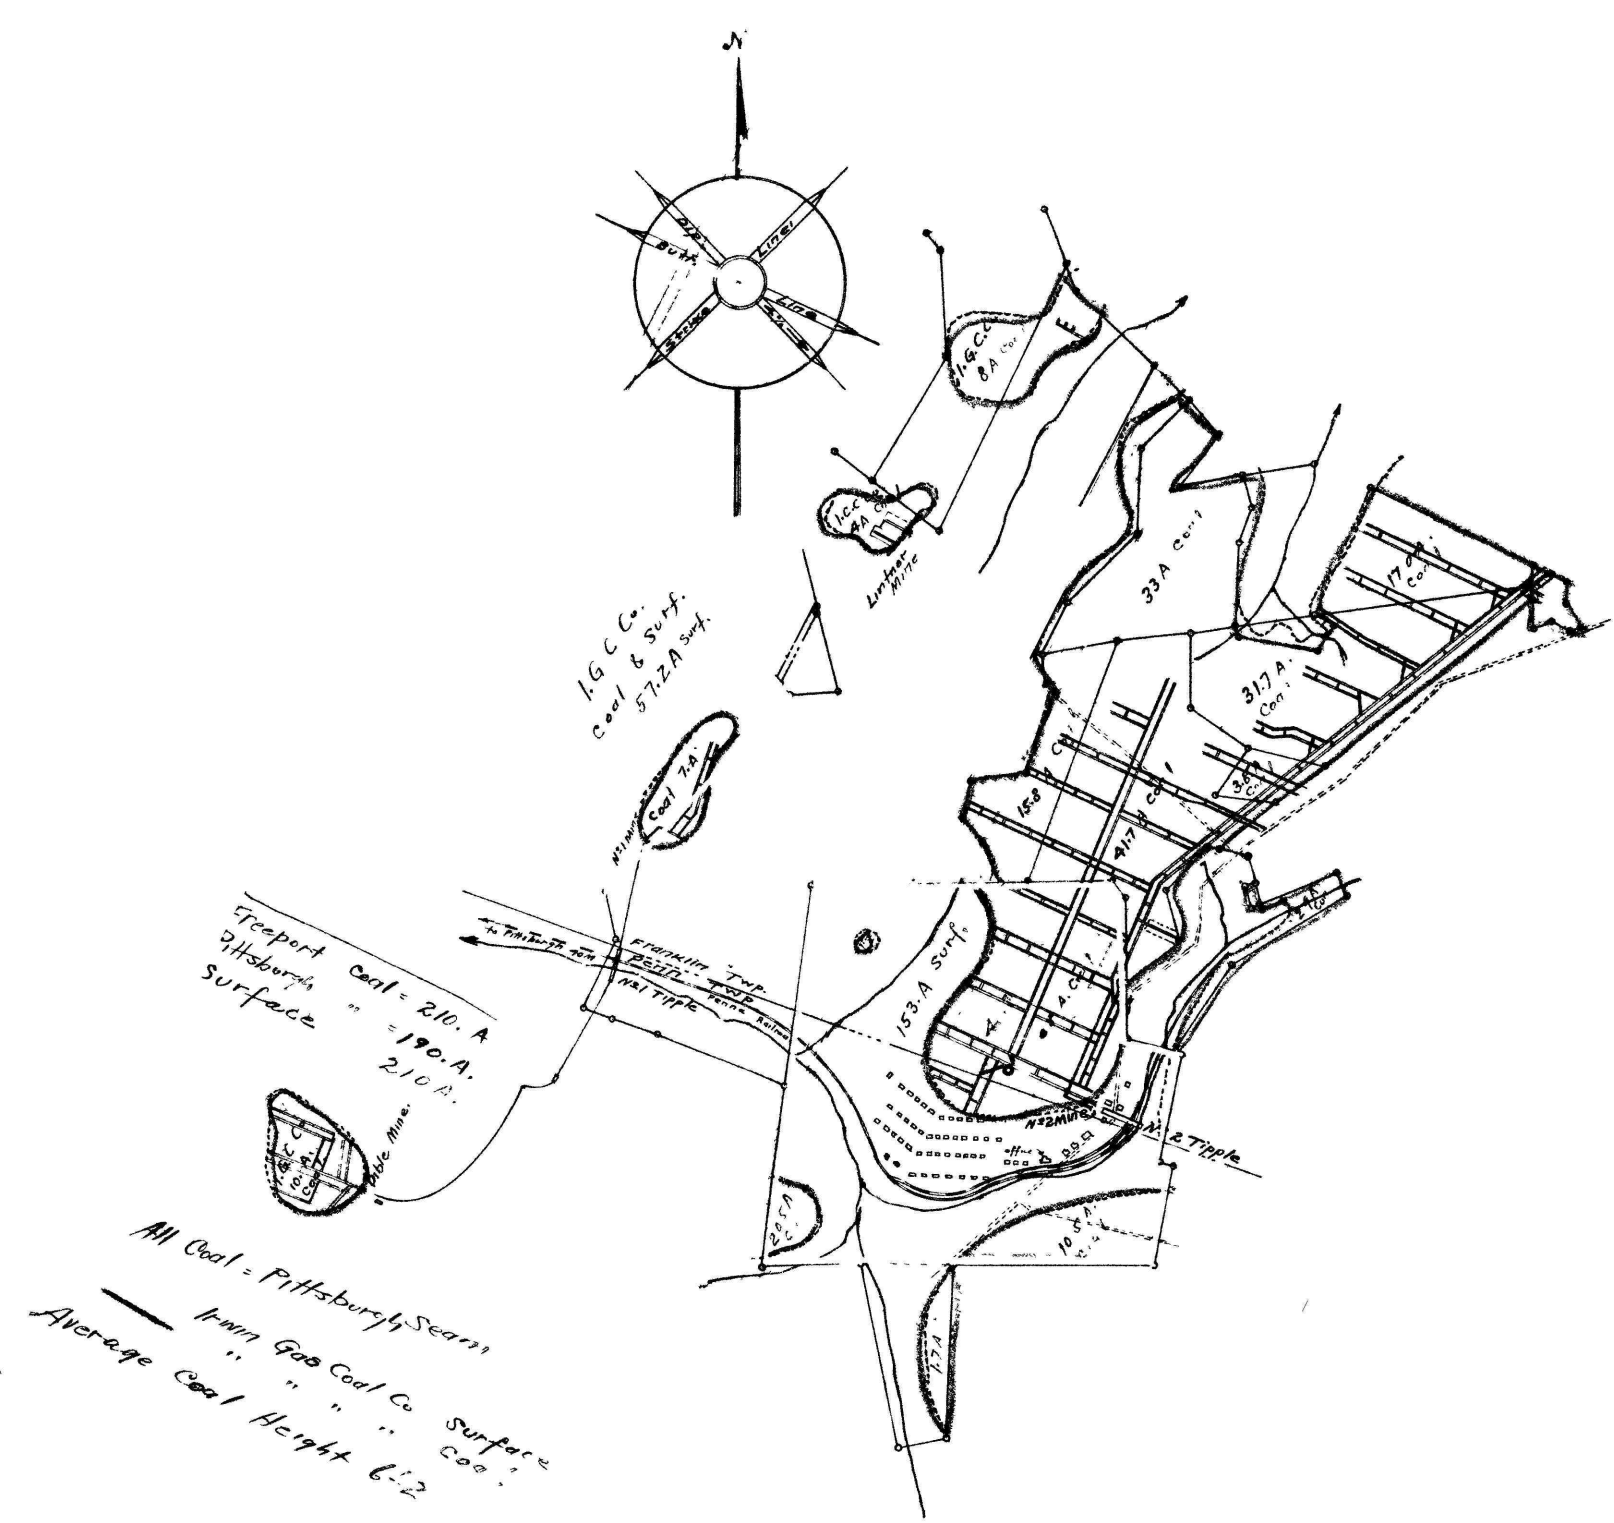

Penn & Irwin No 2 Mine.
Franklin Gas Coal Company
Engineering Townships Westmoreland Co. Pa
Scale 1" = 1000' Department Greensburg Pa.
R.A Ramsay Eng.
March 2nd 1920