


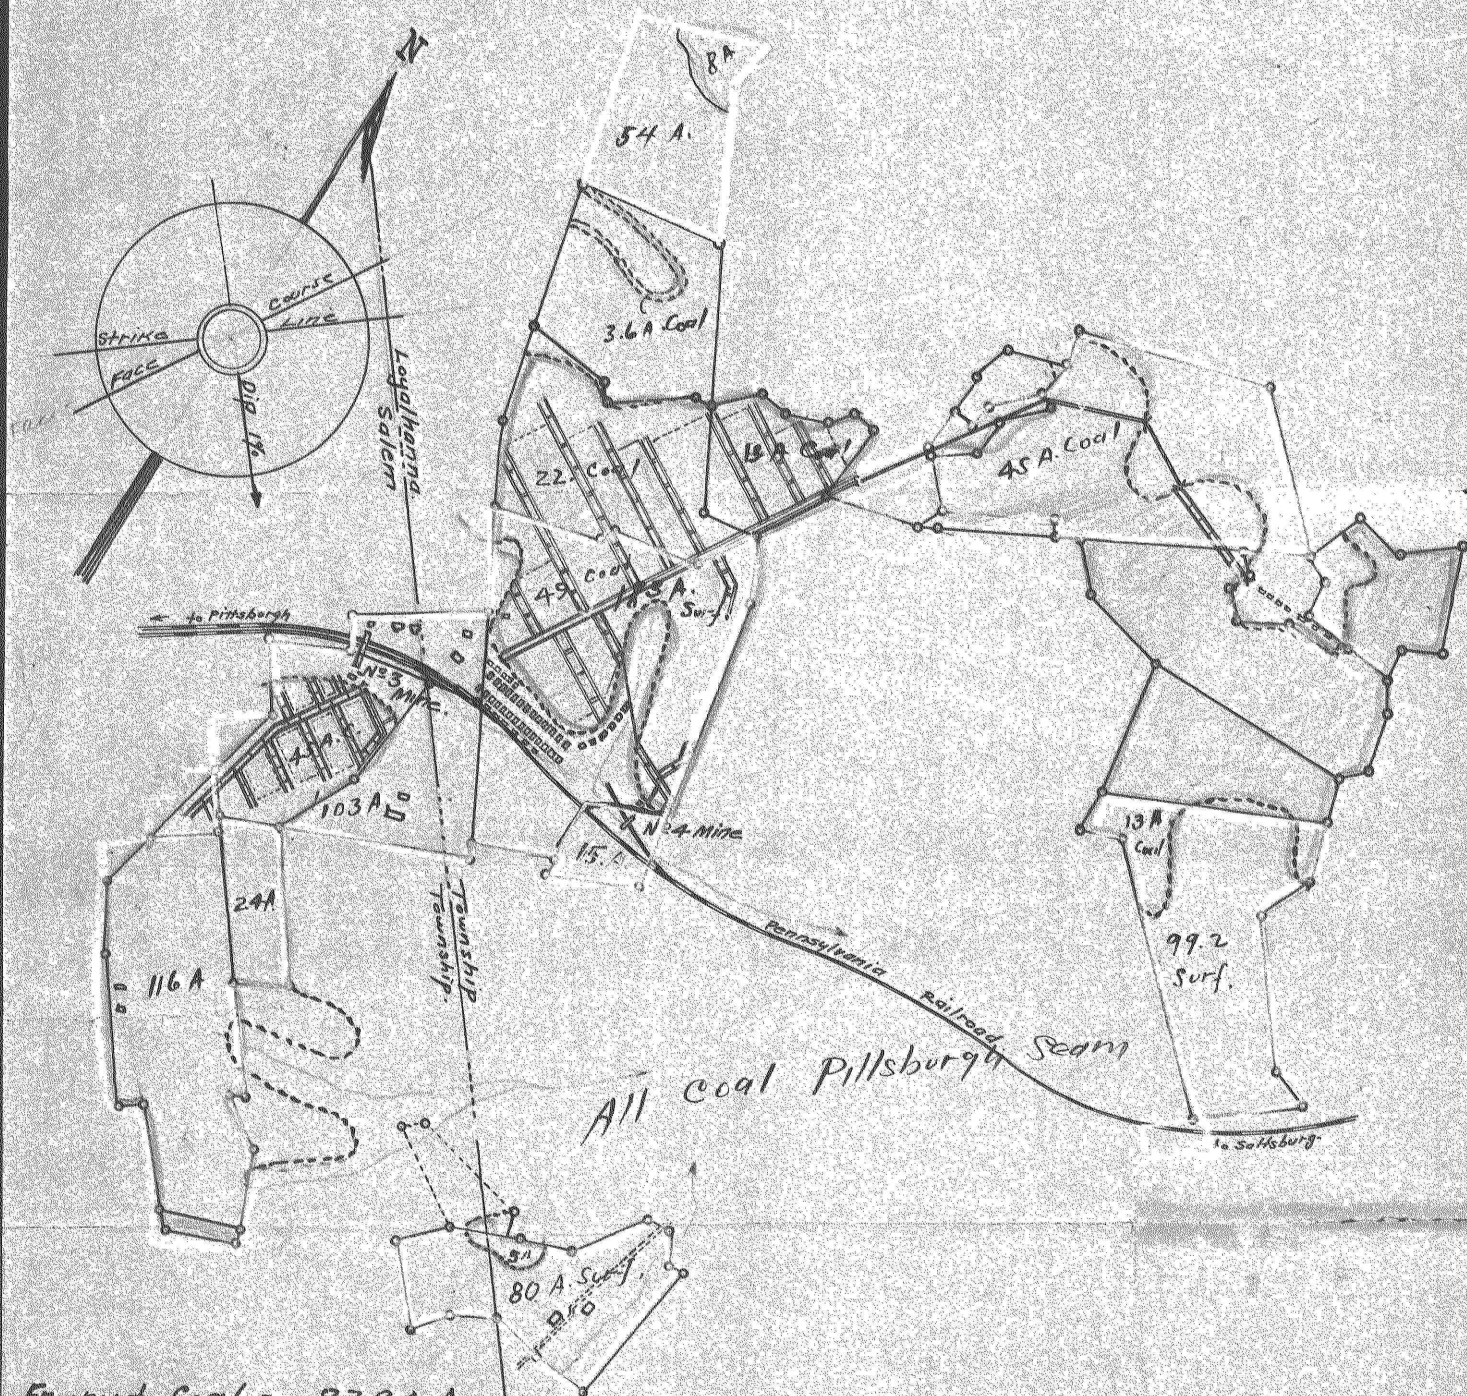

Freeport Coal = 879.0 A.
 Pittsburgh " = 430.0 A.
 Surface = 905.0 A.

Irwin Gas Coal Co Surface
 " " " " Coal
 Average Coal Height 6'-10"

N3 & 4 Mines
Irwin Gas Coal Company.
Salem & Loyalhanna Twp. Westmd. Co. Pa.
Engineering Department, Greensburg Pa.
Scale 1"=2000' R.A. Ramsay Eng. March 2nd 1920.