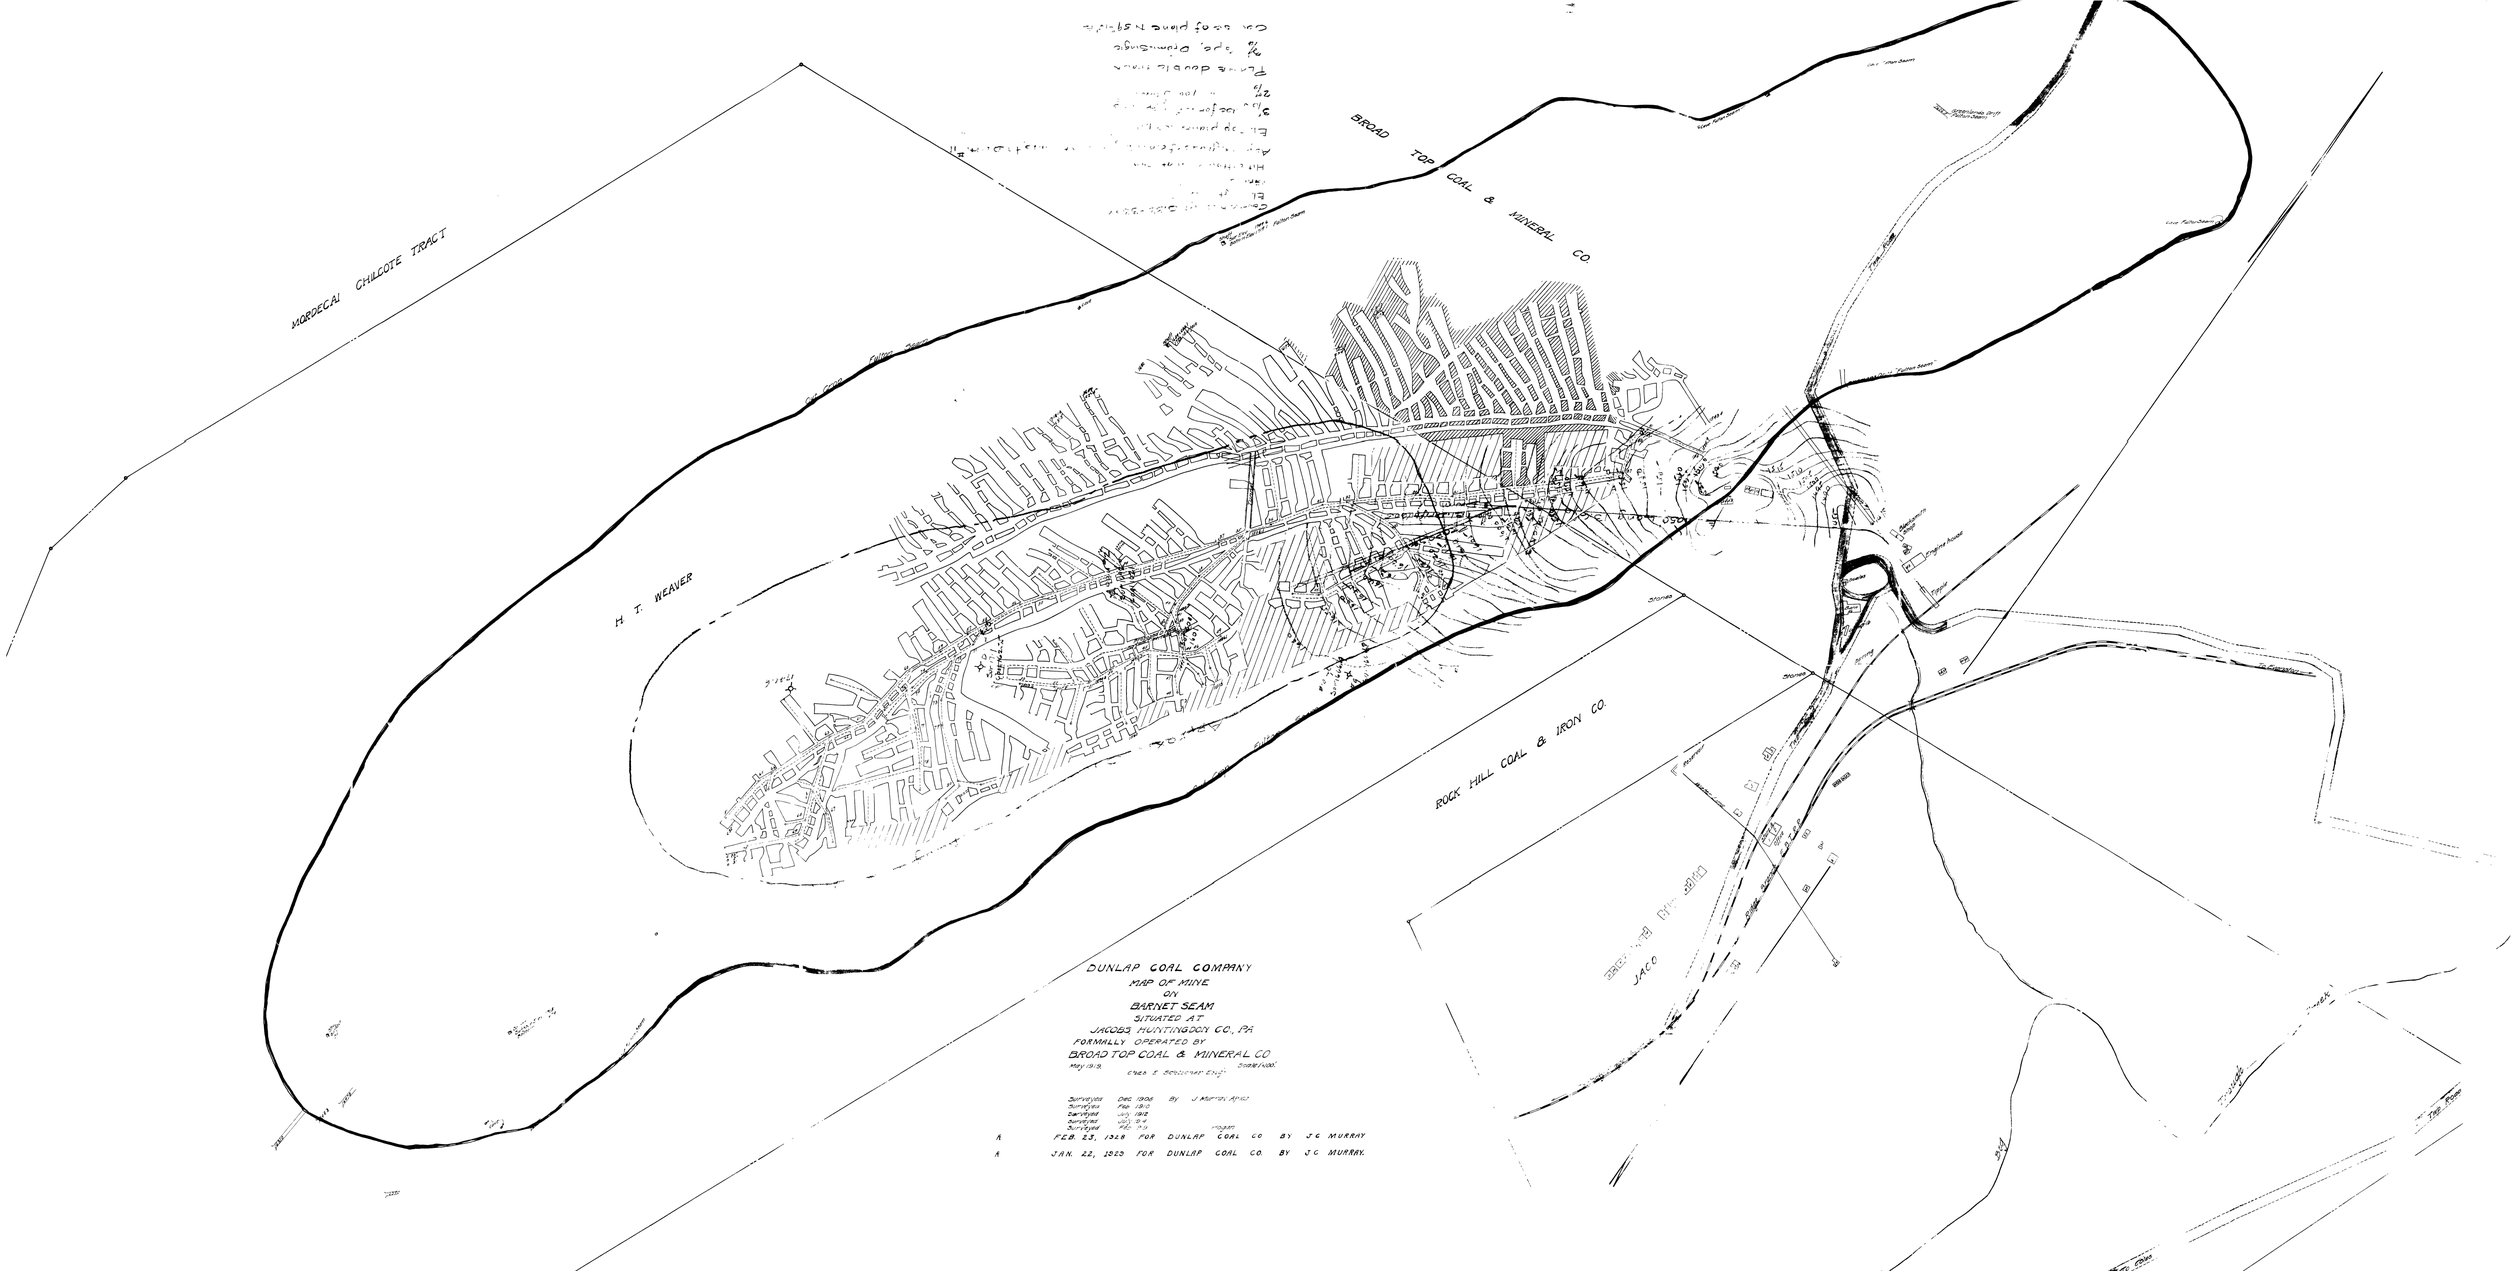
MORDECAI CHILCOTE TRACT
BROAD TOP COAL & MINERAL CO.
H. T. WEAVER
ROCK HILL COAL & IRON CO.
DUNLAP COAL COMPANY
MAP OF MINE
ON
BARNET SEAM
SITUATED AT
JACOBS, HUNTINGDON CO., PA.
FORMALLY OPERATED BY
BROAD TOP COAL & MINERAL CO.
May 1918
Scale 1:600
Surveyed Dec 1906 By J. Murray, Agent
Surveyed Feb 1910
Surveyed July 1912
Surveyed July 1914
Surveyed Feb 1919
A FEB. 23, 1928 FOR DUNLAP COAL CO BY J.C. MURRAY
A JAN. 22, 1929 FOR DUNLAP COAL CO. BY J.C. MURRAY