


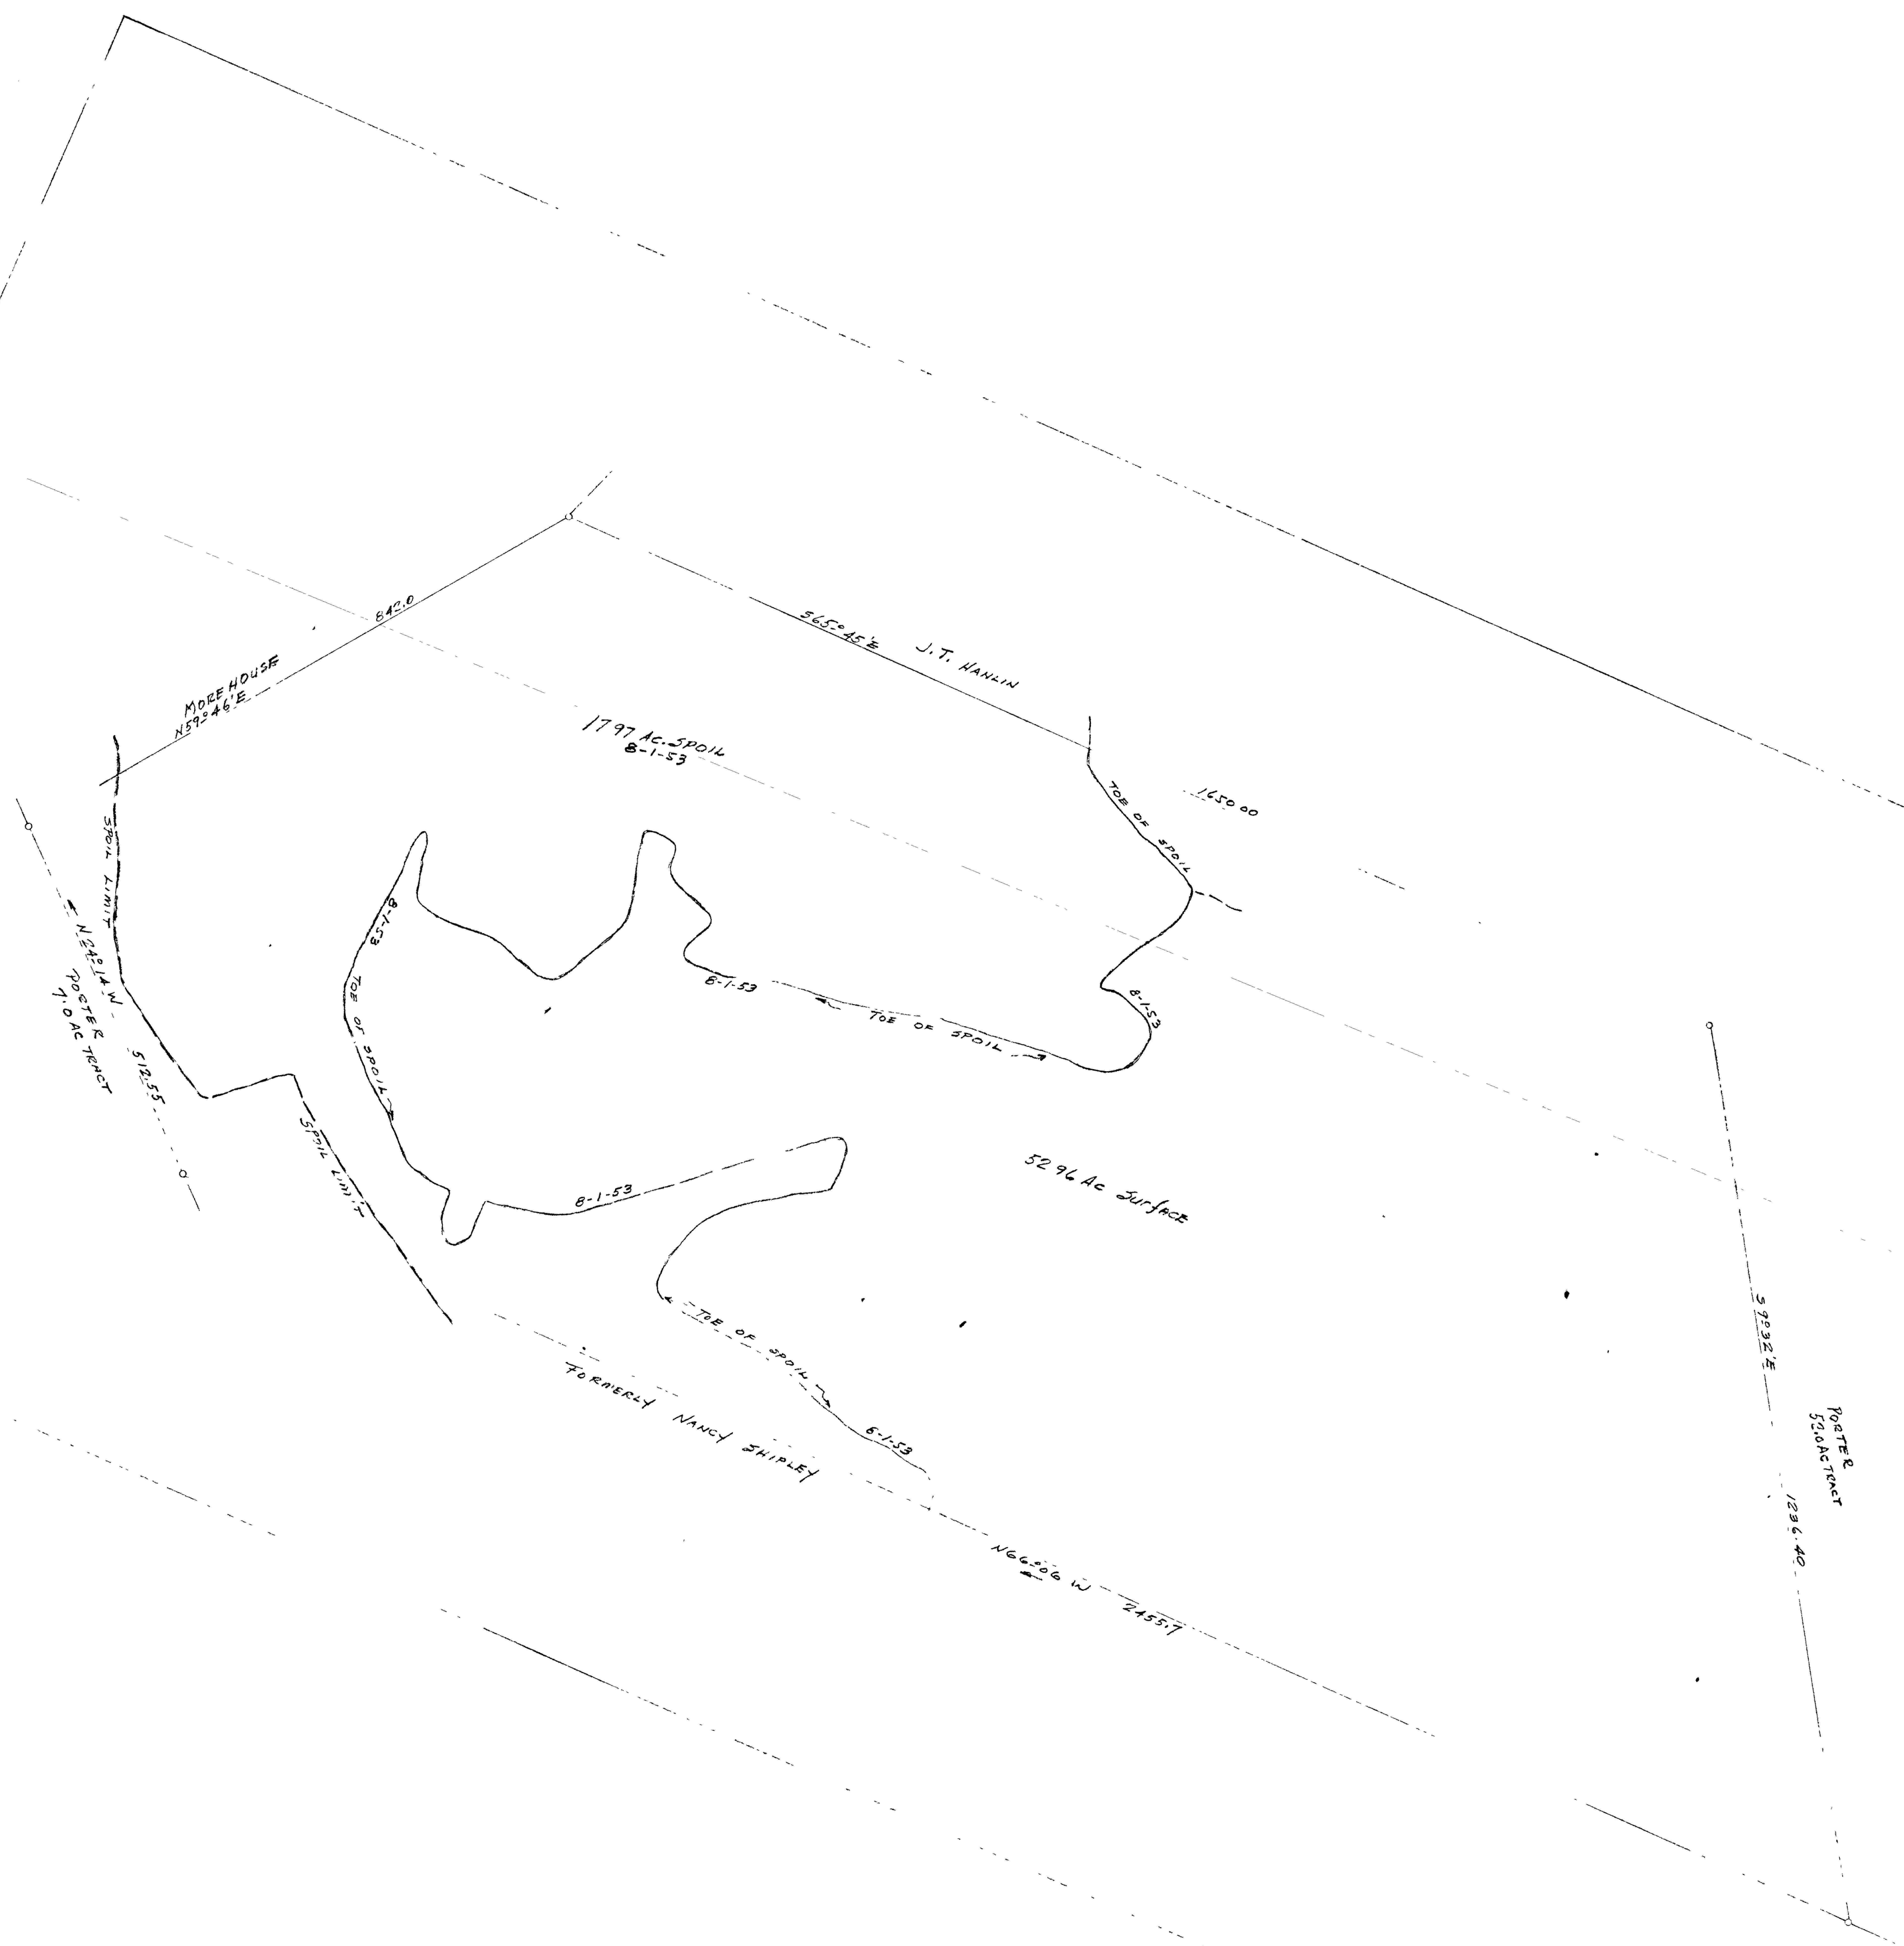

PORTER FARM  
SHOWING  
SPOIL AREA  
SITUATED  
HANGOVER TWP. WASH. CO. PENNA  
1 1/2 100'  
AUG. 1953  
GEN'L ENG CO  
WEIRTON W.VA

195

GEN'L ENG  
WERTON W. VA

Frank K. D.