


J V THOMPSON COAL

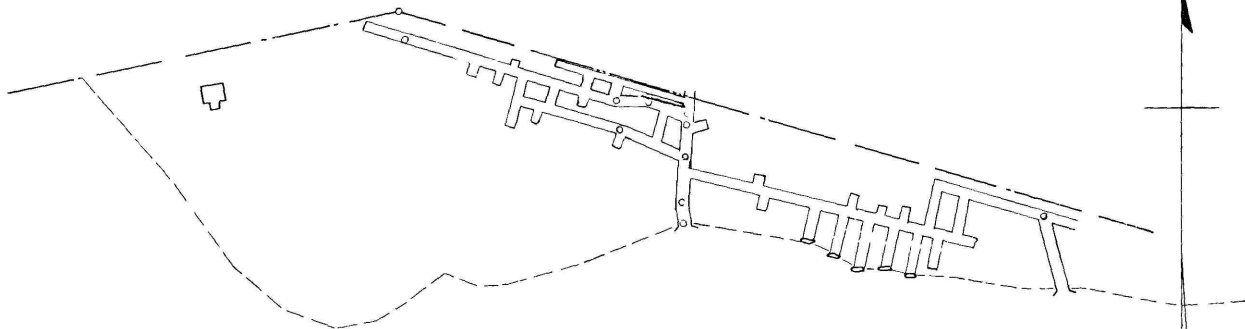

JENNINGS COAL CO

SPRINGHILL TWP FAYETTE CO PA

SCALE 1 100

H B GANS