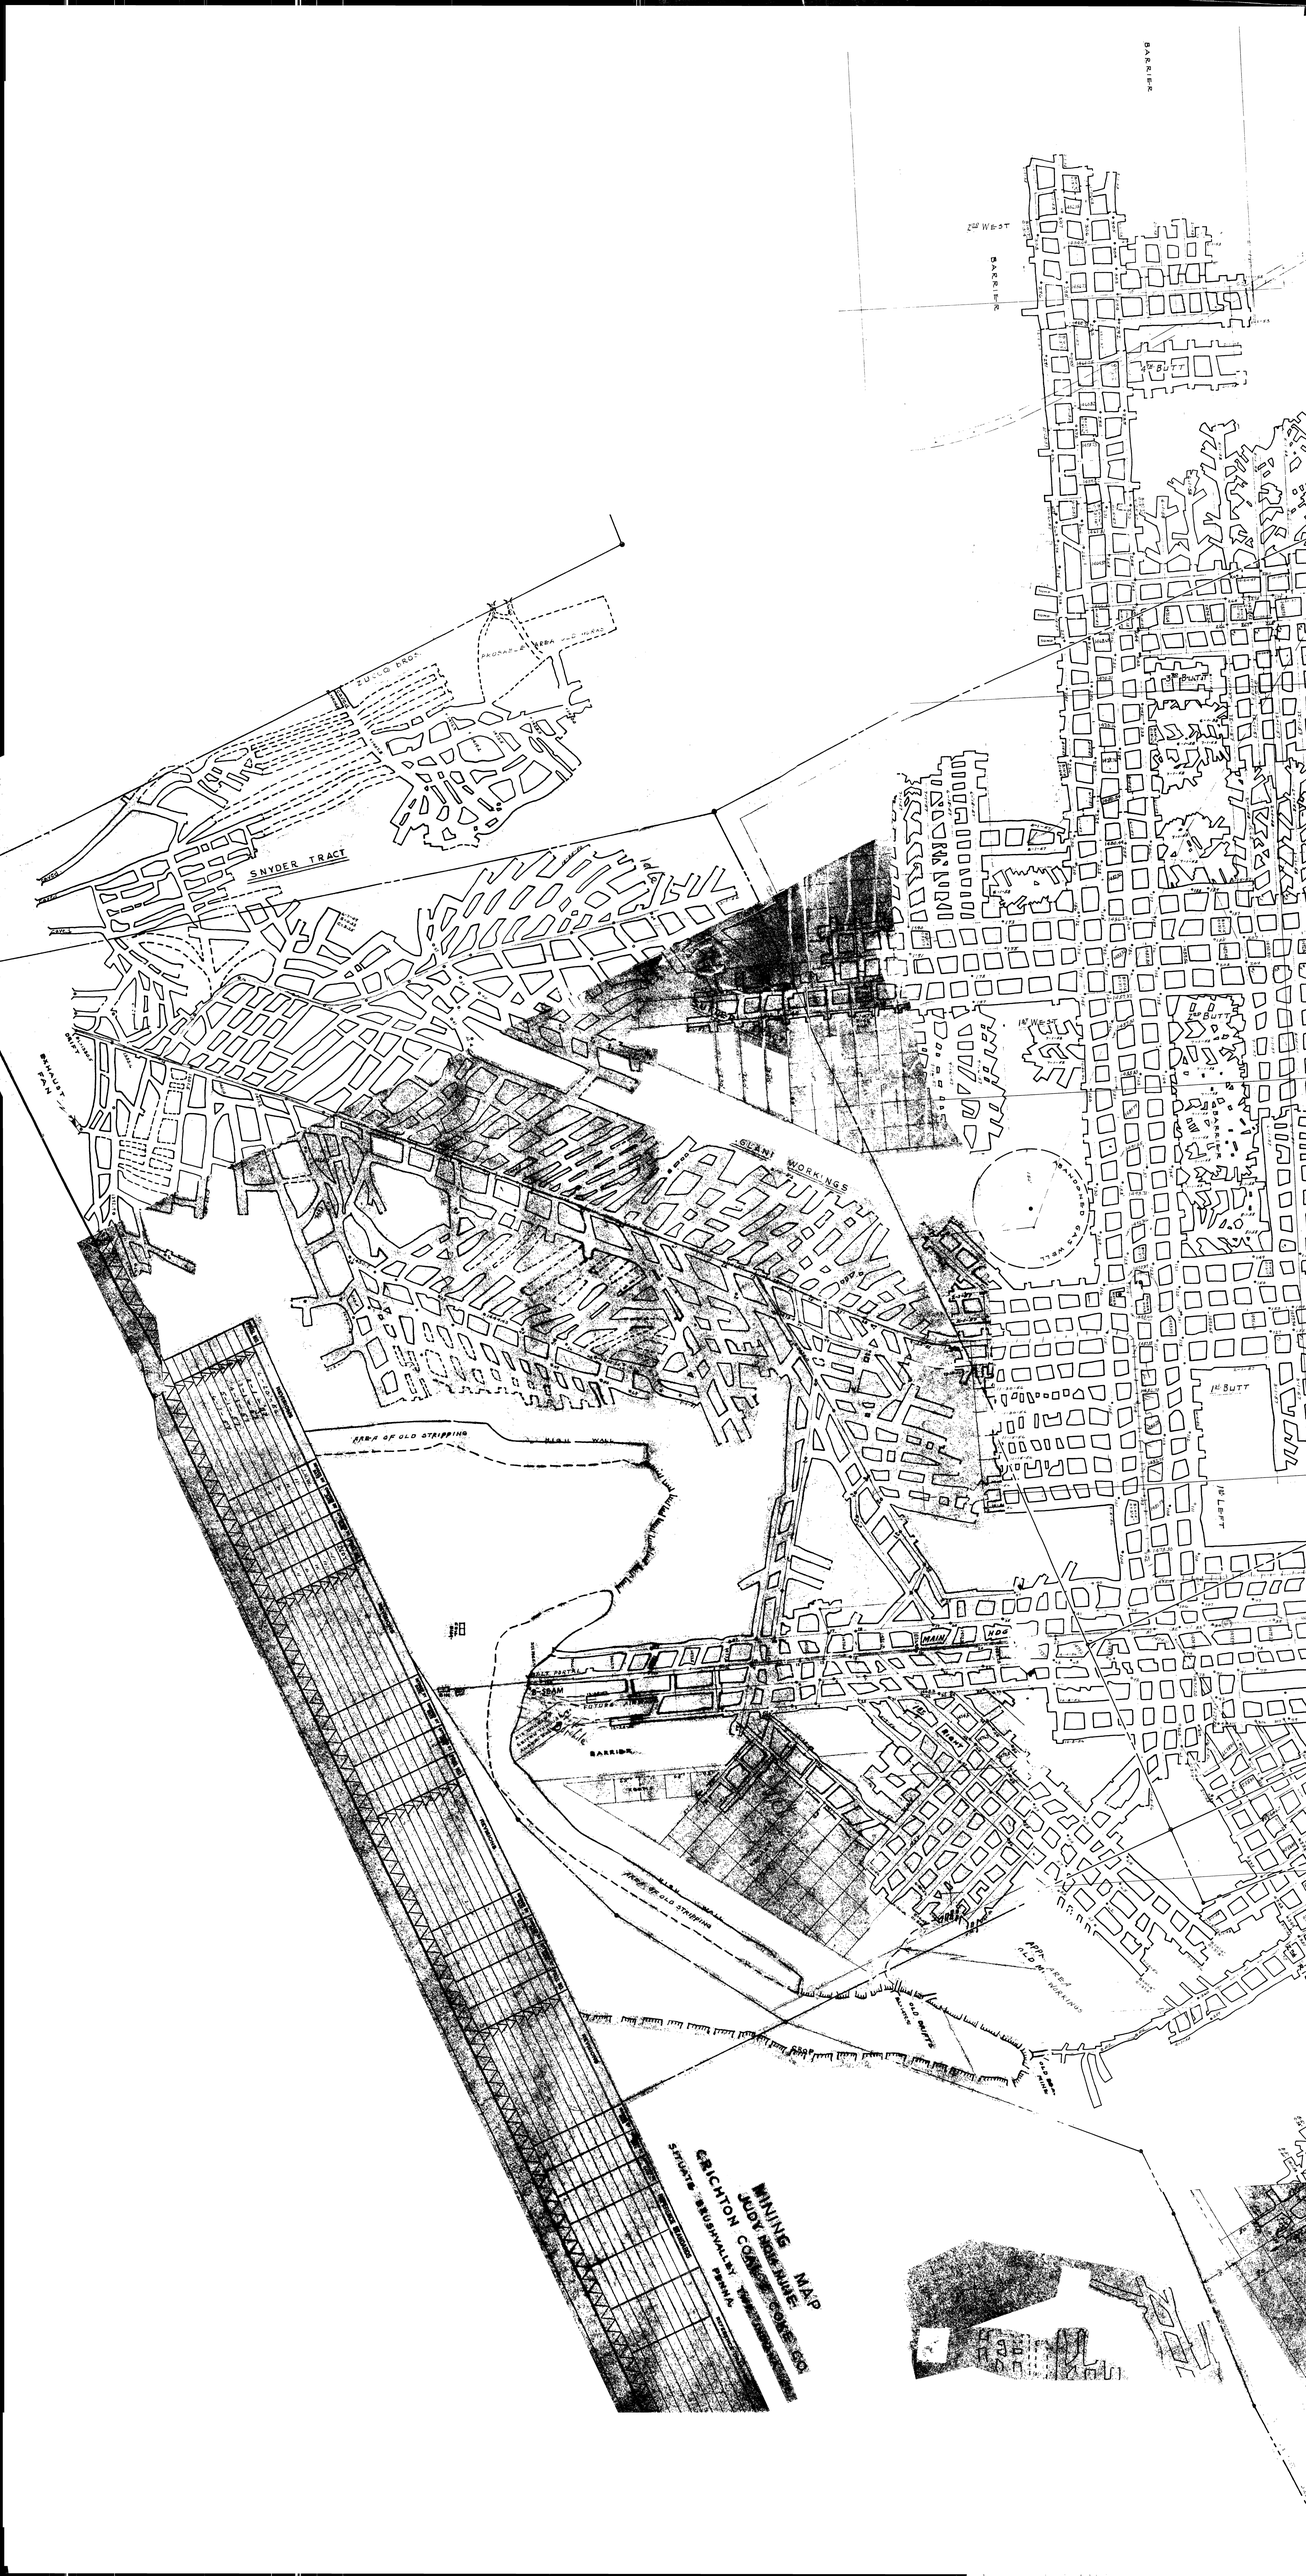
BARRIER
1st WEST
BARRIER
SNYDER TRACT
SLANT WORKINGS
AREA OF OLD STRIPPING
MAIN
BARRIER
AREA OF OLD STRIPPING
1st BUTT
1st LEFT
MINING MAP
GRIGHTON COAL CO.