


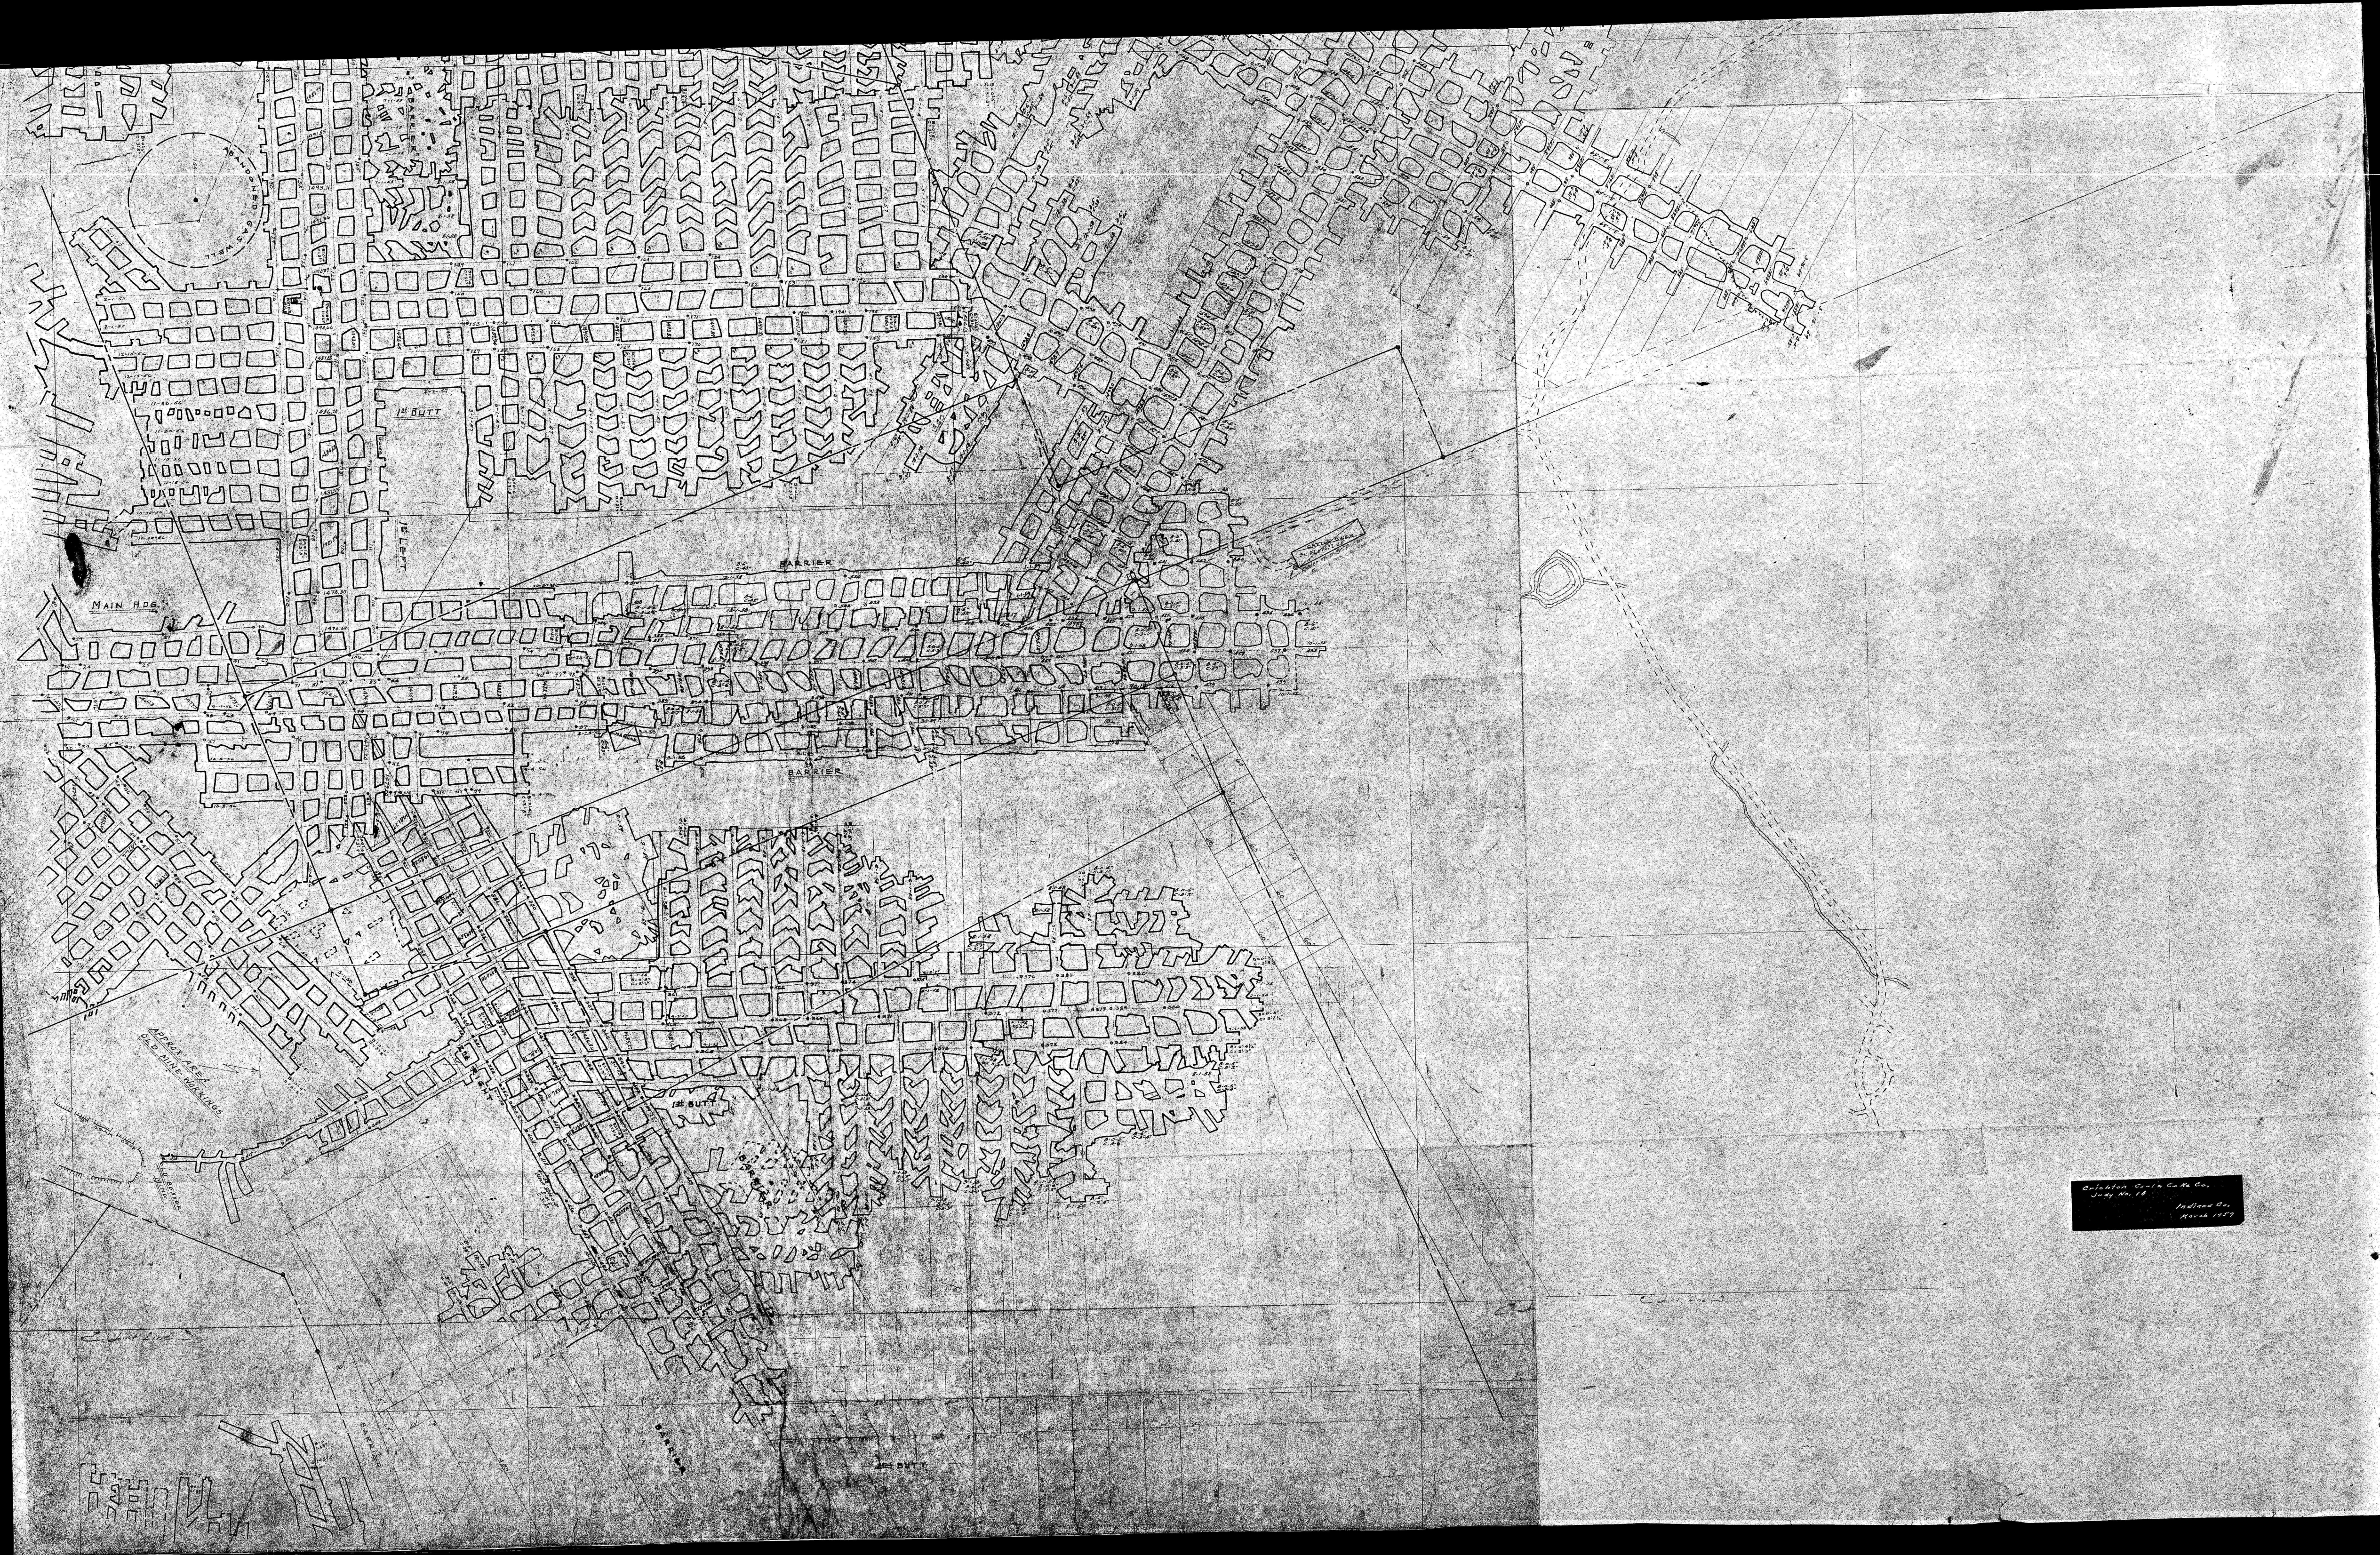

July, No. 18
Indiana Co.
March 1957