


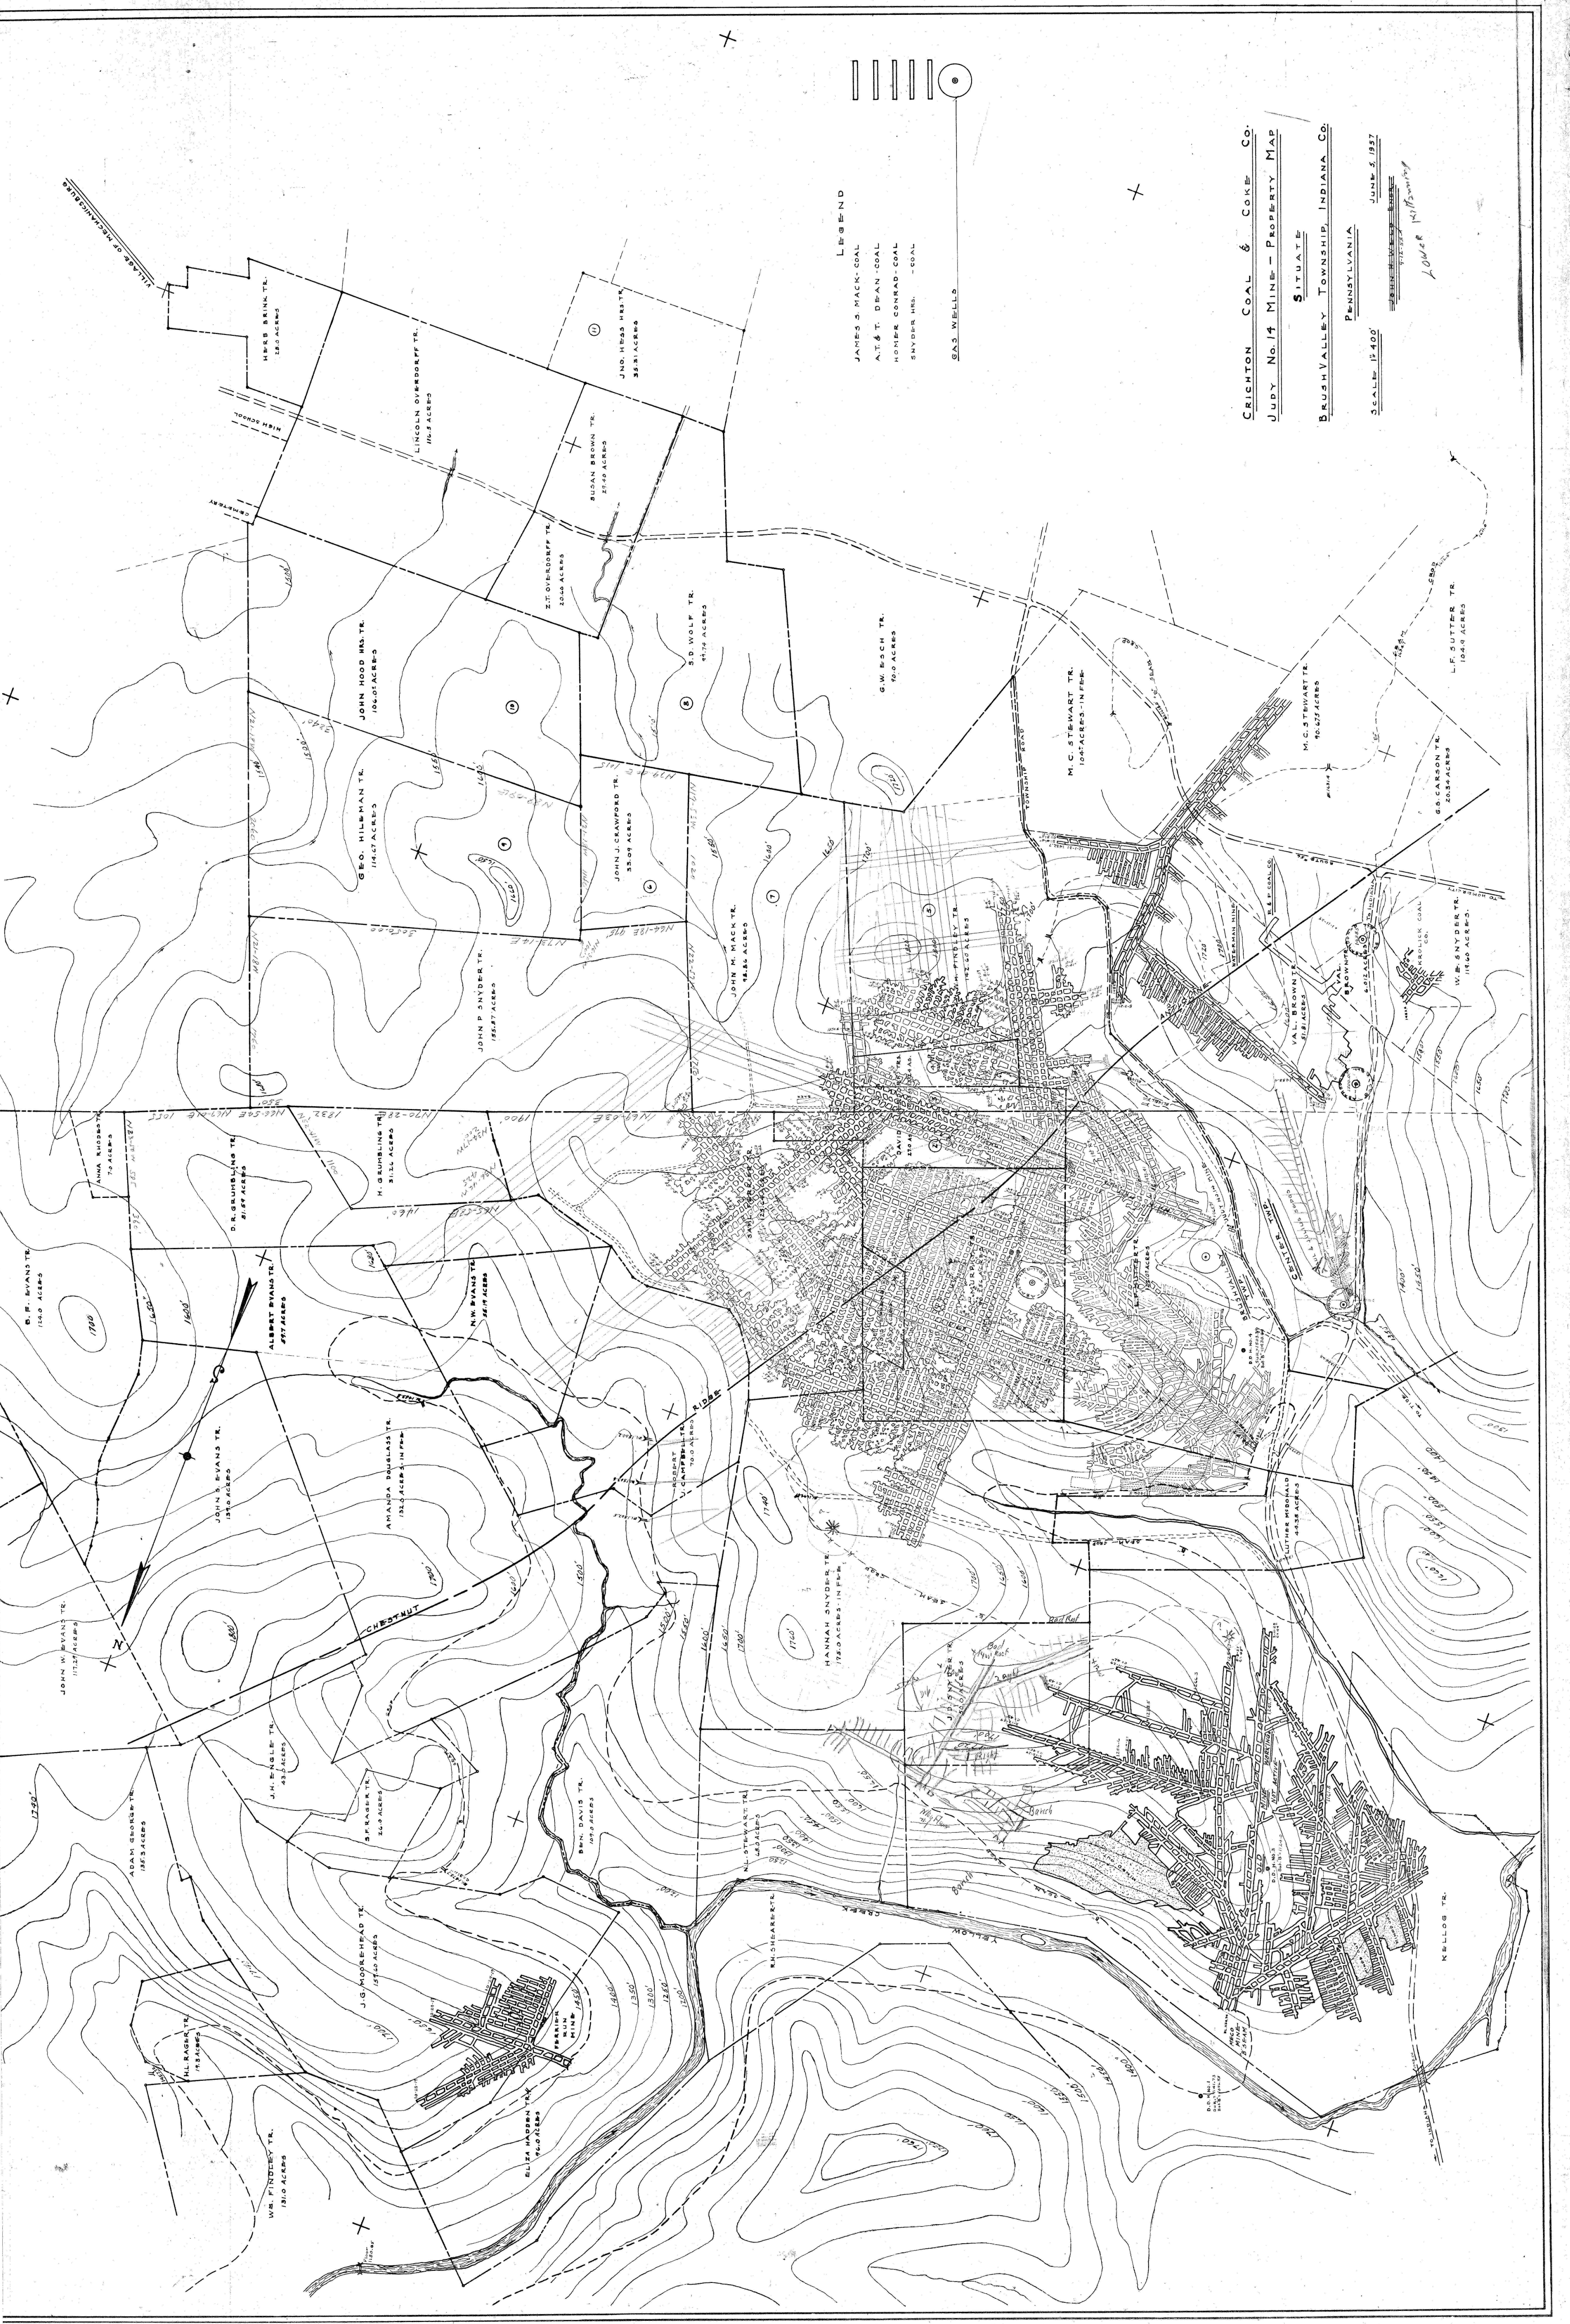

LEGEND

JAMES S. MACK - COAL

A.T. & T. DEAN - COAL

HOMER CONRAD - COAL

SNYDER HED. - COAL

GAS WELLS

CRICHTON COAL & COKE CO.

JUDY No. 14 MINE - PROPERTY MAP

SITUATE

BRUSH VALLEY TOWNSHIP, INDIANA CO.

PENNSYLVANIA

SCALE 1" = 400'

JUNE 5, 1937

JOHN W. EVANS

JOHN W. EVANS