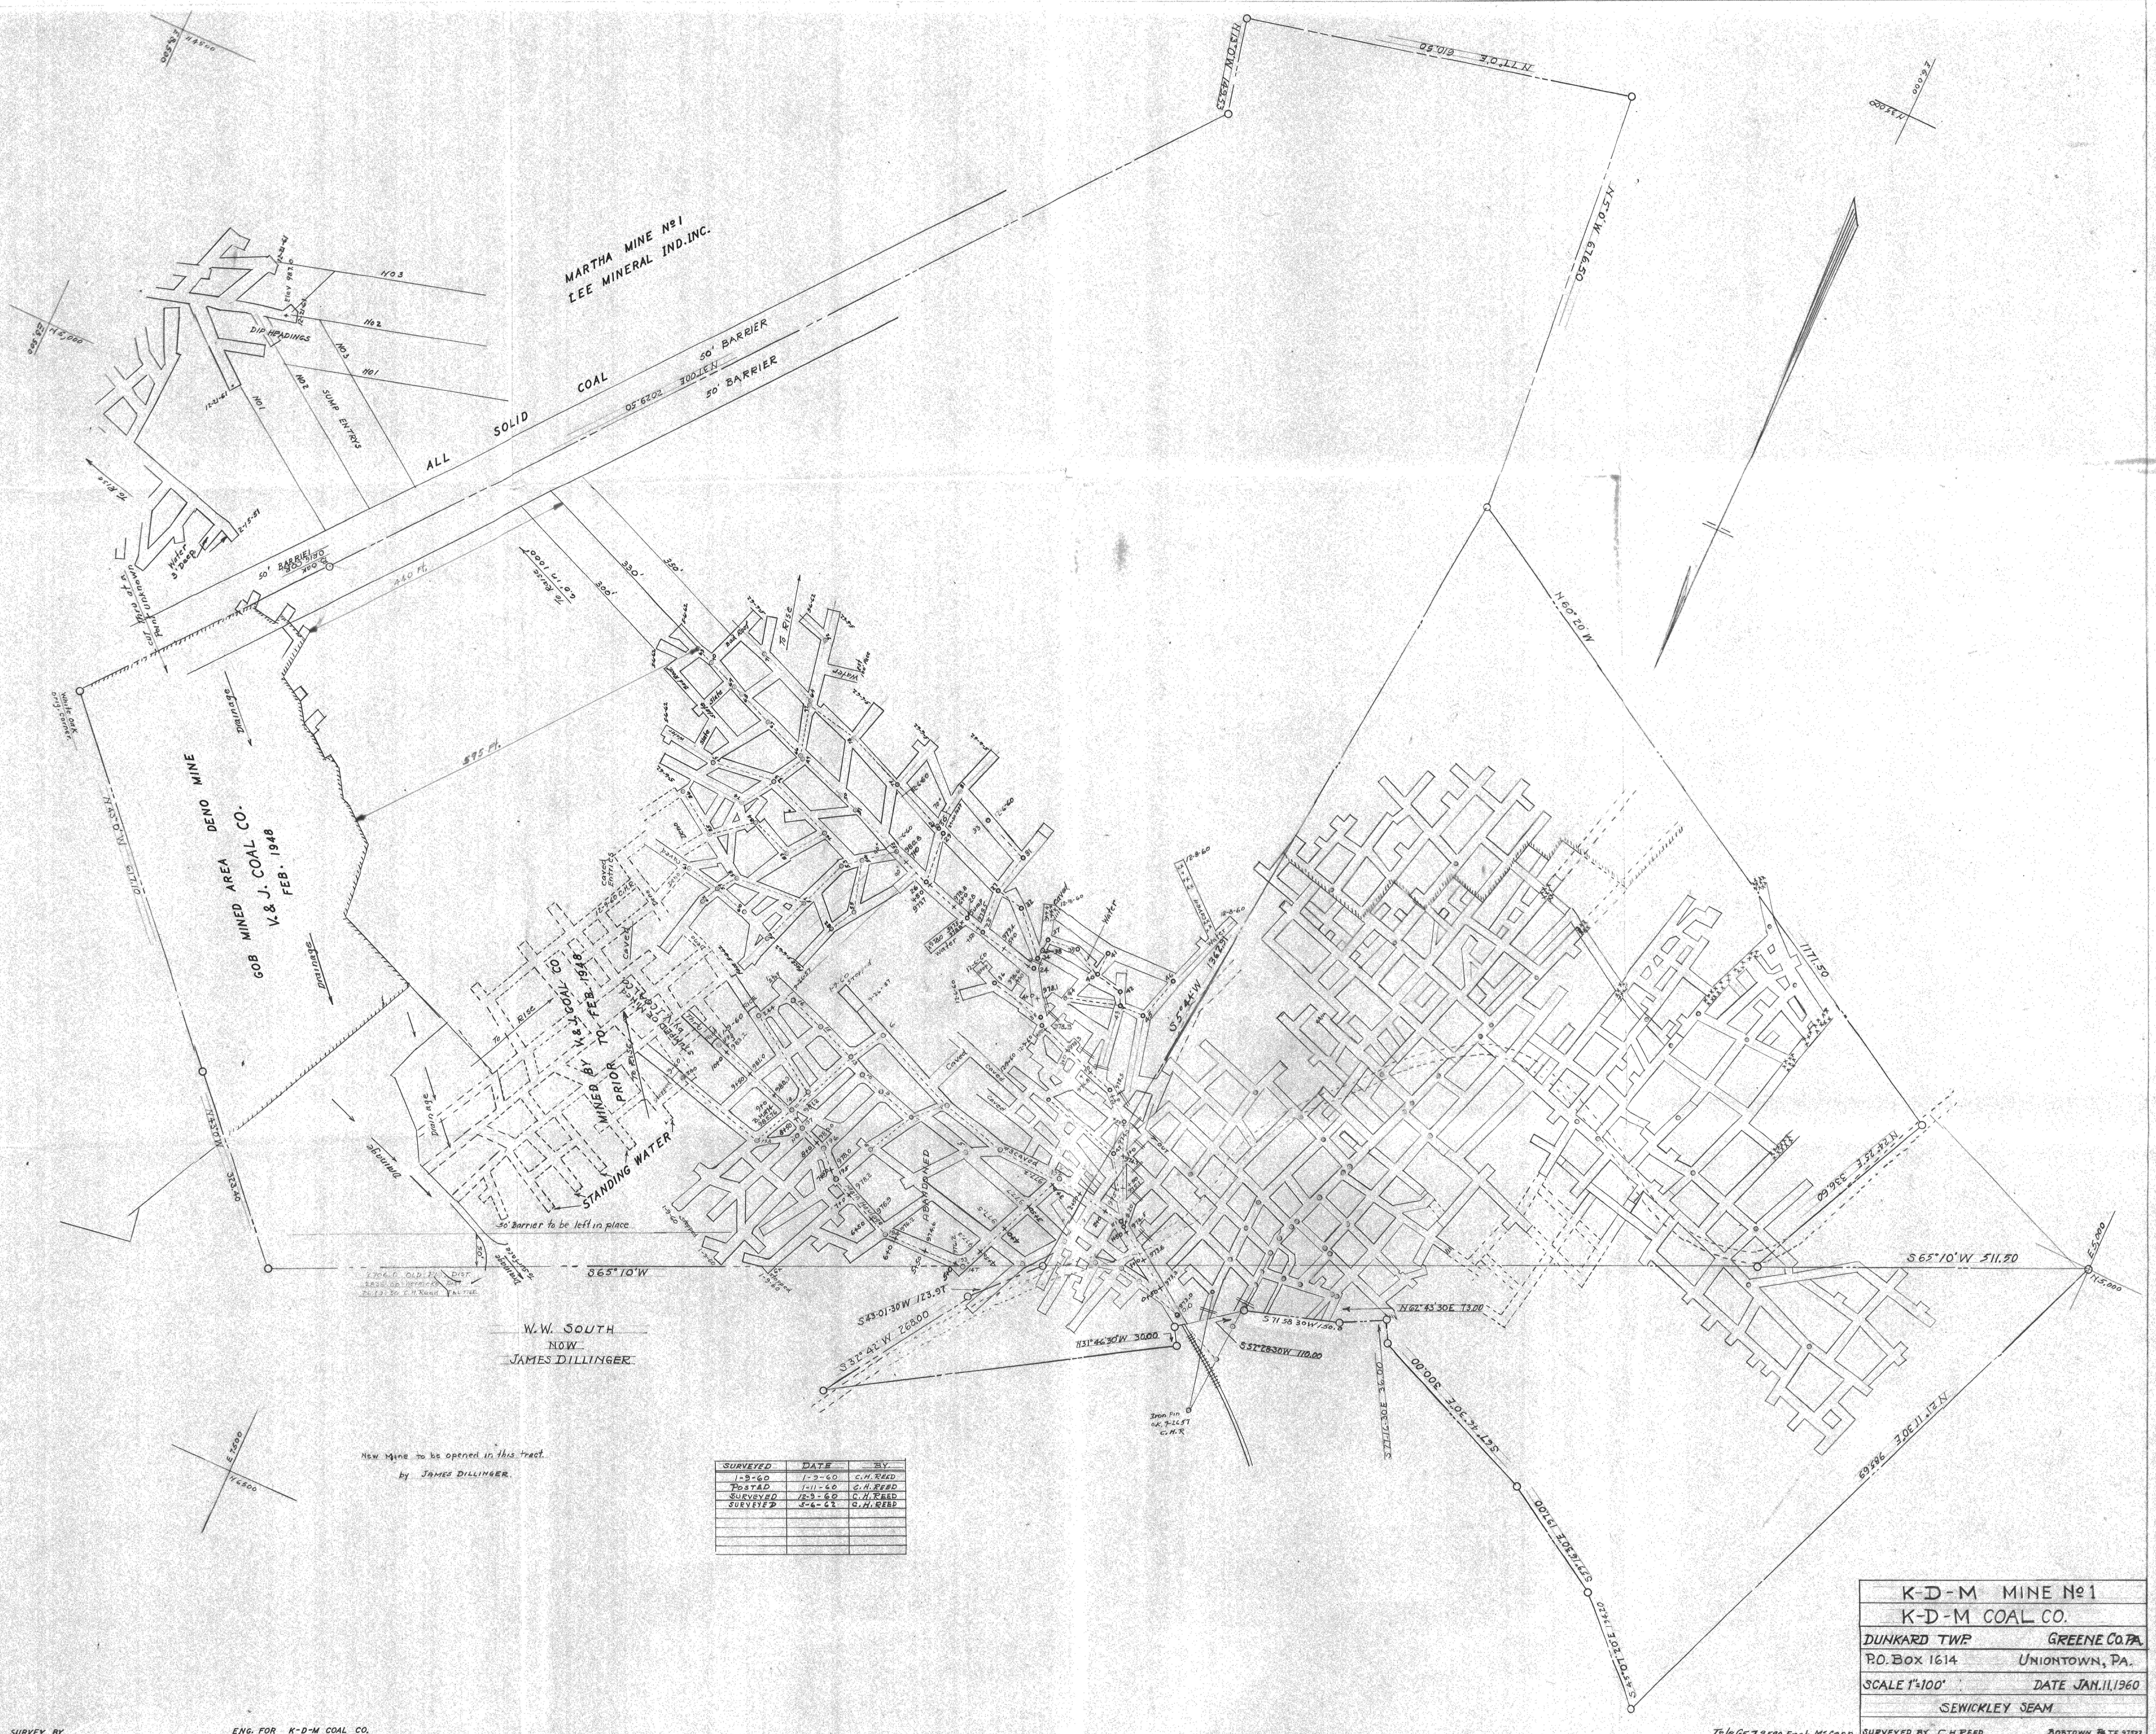

W.W. SOUTH
NOW
JAMES DILLINGER

New Mine to be opened in this tract.
by JAMES DILLINGER.

SURVEYED	DATE	BY.
1-9-60	1-9-60	C.H. REED
POSTED	1-11-60	C.H. REED
SURVEYED	12-9-60	C.H. REED
SURVEYED	5-6-62	C.H. REED

K-D-M MINE No 1
K-D-M COAL CO.

DUNKARD TWP. GREENE CO. PA.
P.O. BOX 1614 UNIONTOWN, PA.
SCALE 1"=100' DATE JAN. 11, 1960
SEWICKLEY SEAM

SURVEYED BY C.H. REED BOBTOWN, PA TE.9-3522

Tele GE. 7 9590 Frank Mc Cann

SURVEY BY ENG. FOR K-D-M COAL CO.