


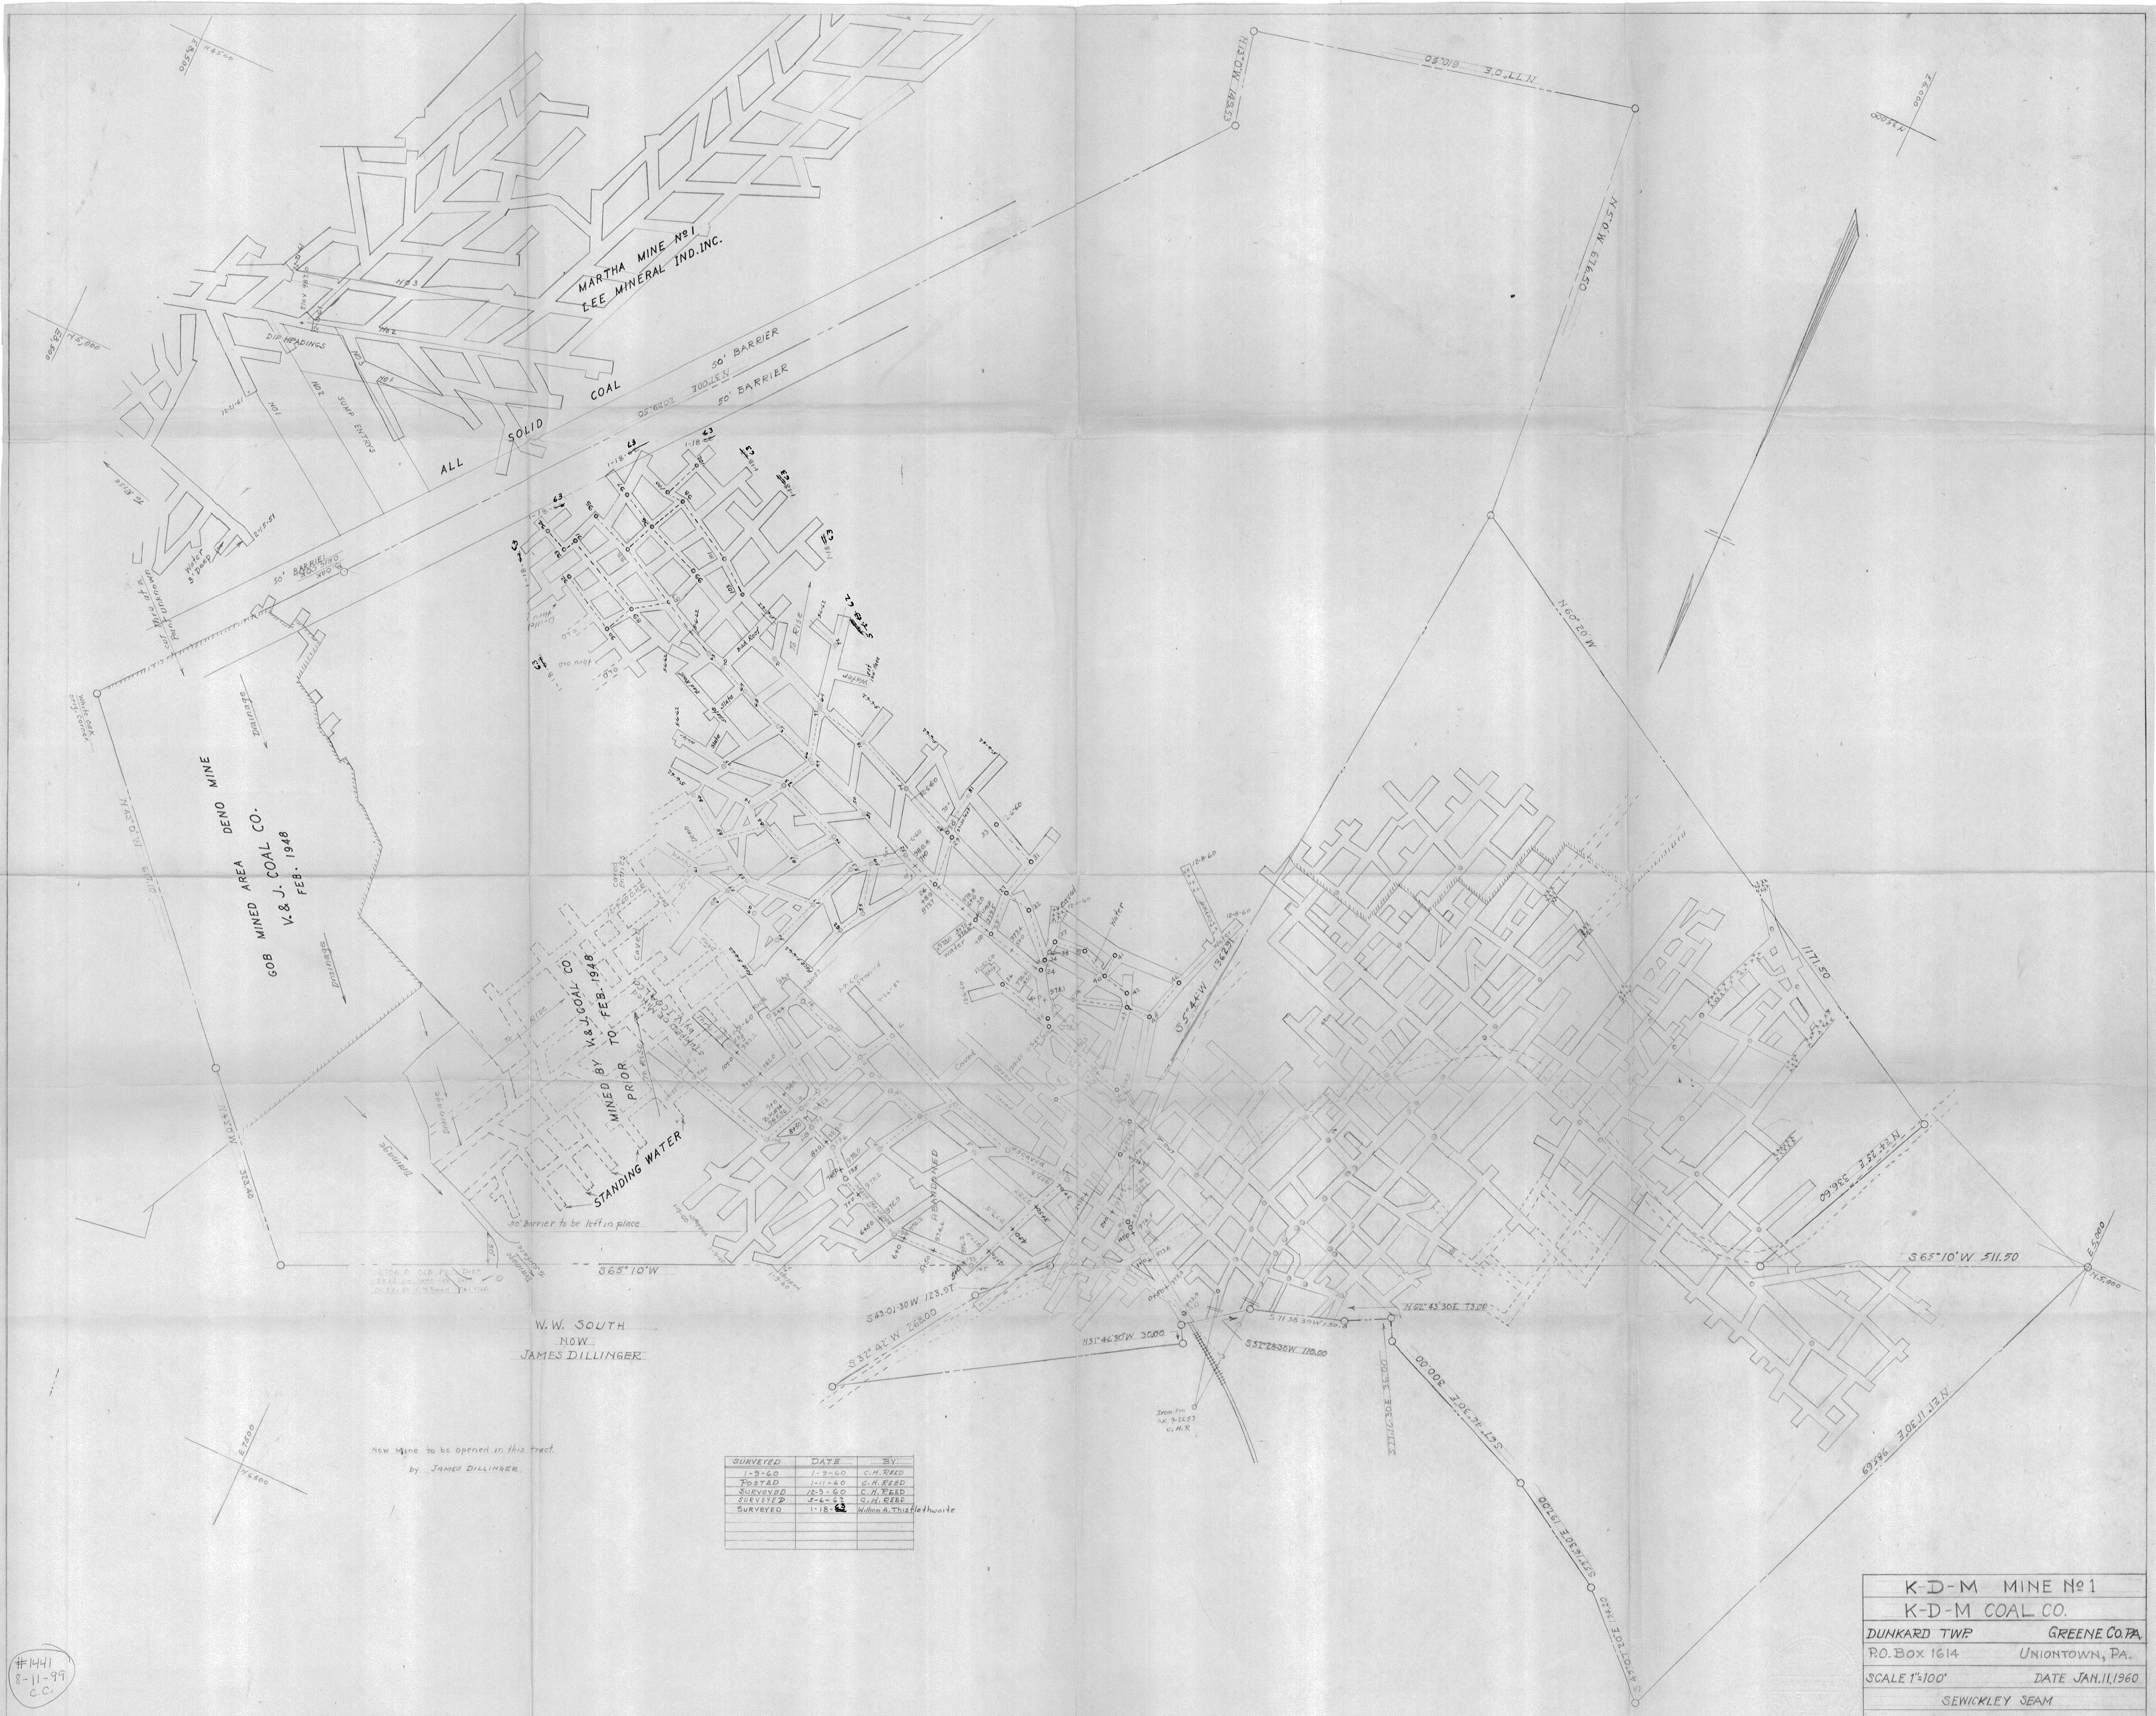

MARTHA MINE No. 1
LEE MINERAL IND. INC.

GOB MINED AREA
DENO MINE
V. & J. COAL CO.
FEB. 1948

W.W. SOUTH
NOW
JAMES DILLINGER

Now Mine to be opened in this tract.
by JAMES DILLINGER.

SURVEYED	DATE	BY
1-3-60	1-3-60	C.H. REED
POSTED	1-11-60	C.H. REED
SURVEYED	1-3-60	C.H. REED
SURVEYED	5-6-63	C.H. REED
SURVEYED	1-18-63	William A. Thistlethwaite

K-D-M MINE No. 1
K-D-M COAL CO.
DUNKARD TWP GREENE CO. PA.
P.O. BOX 1614 UNIONTOWN, PA.
SCALE 1"=100' DATE JAN. 11, 1960
SEWICKLEY SEAM
SURVEYED BY C.H. REED BOSTOWN, PA. 17122

#1441
8-11-99
C.C.

SURVEY BY ENG. FOR K-D-M COAL CO.

Table 79570 Frank M. Carr