


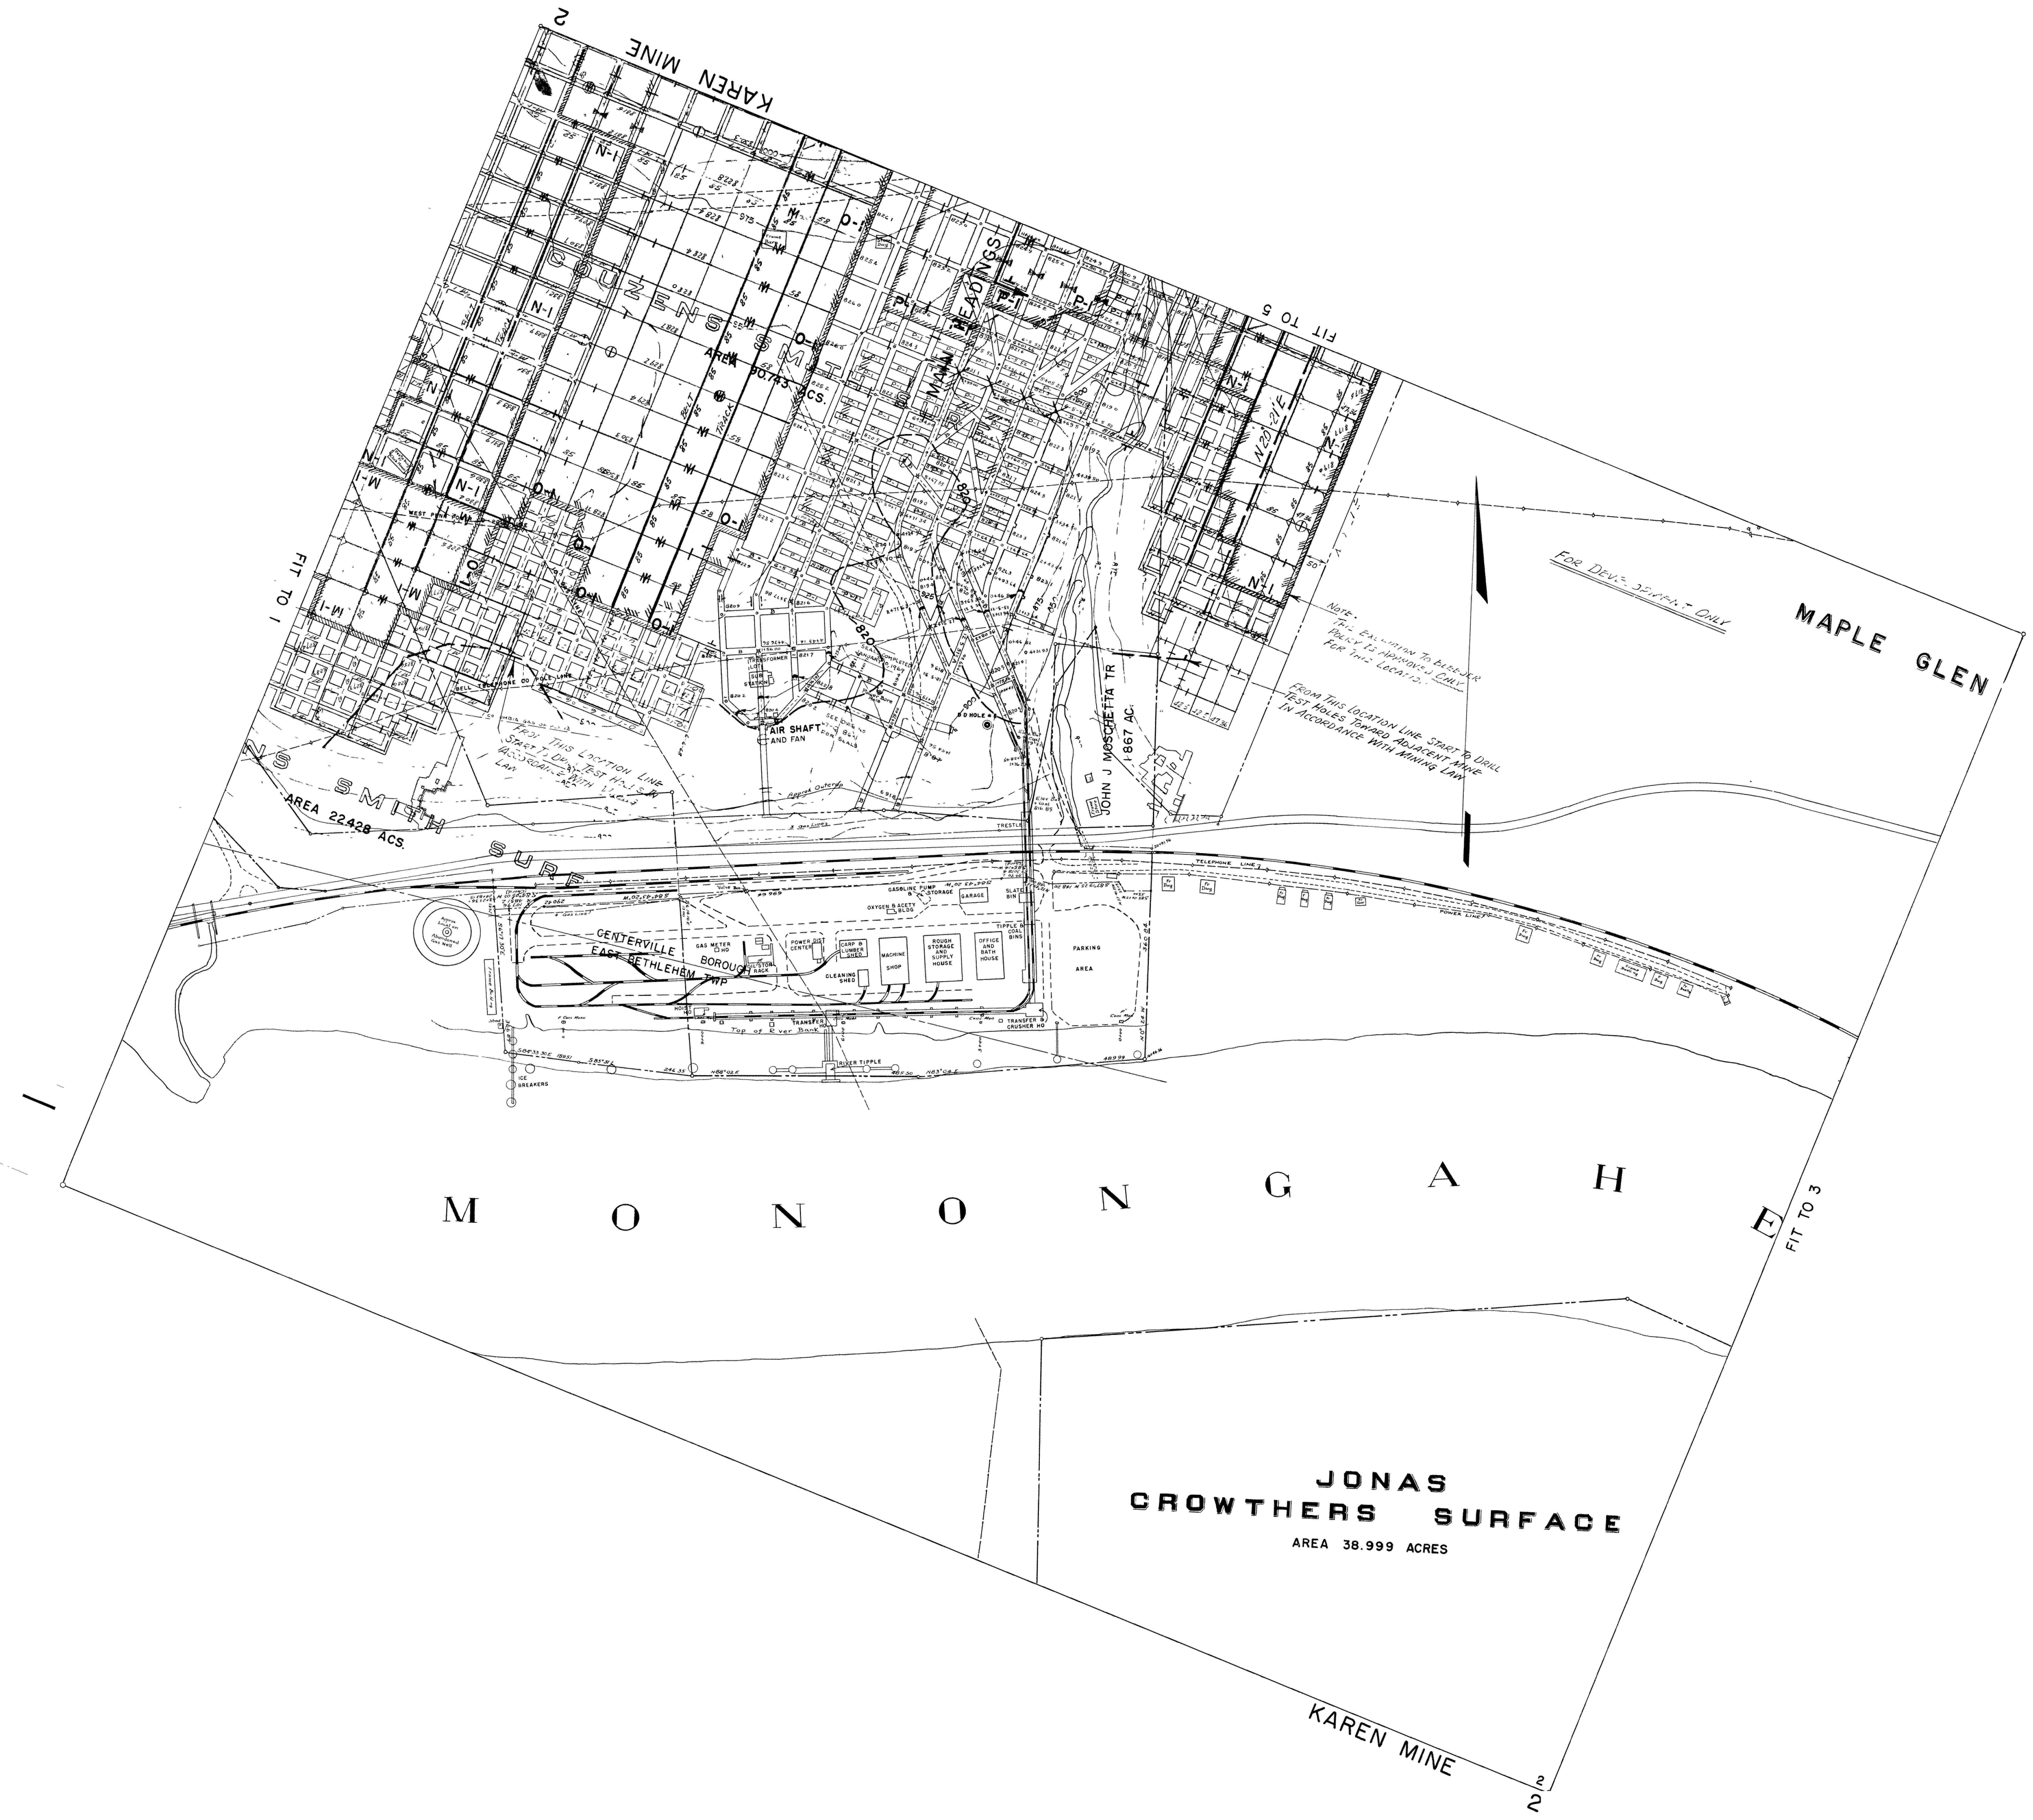

**JONAS
CROWTHERS SURFACE**
AREA 38.999 ACRES

KAREN MINE

MAPLE GLEN

MONONGAHE

AREA 22428 ACS

GENTERVILLE BOROUGH
EAST BETHLEHEM TWP

JOHN J MOSCETTA TR
1867 AC

KAREN MINE

for this location.

From this location line start to drill
test holes toward adjacent mine
in accordance with mining law

FOR DEVELOPMENT ONLY

FIT TO 3

FIT TO 1

FIT TO 2