


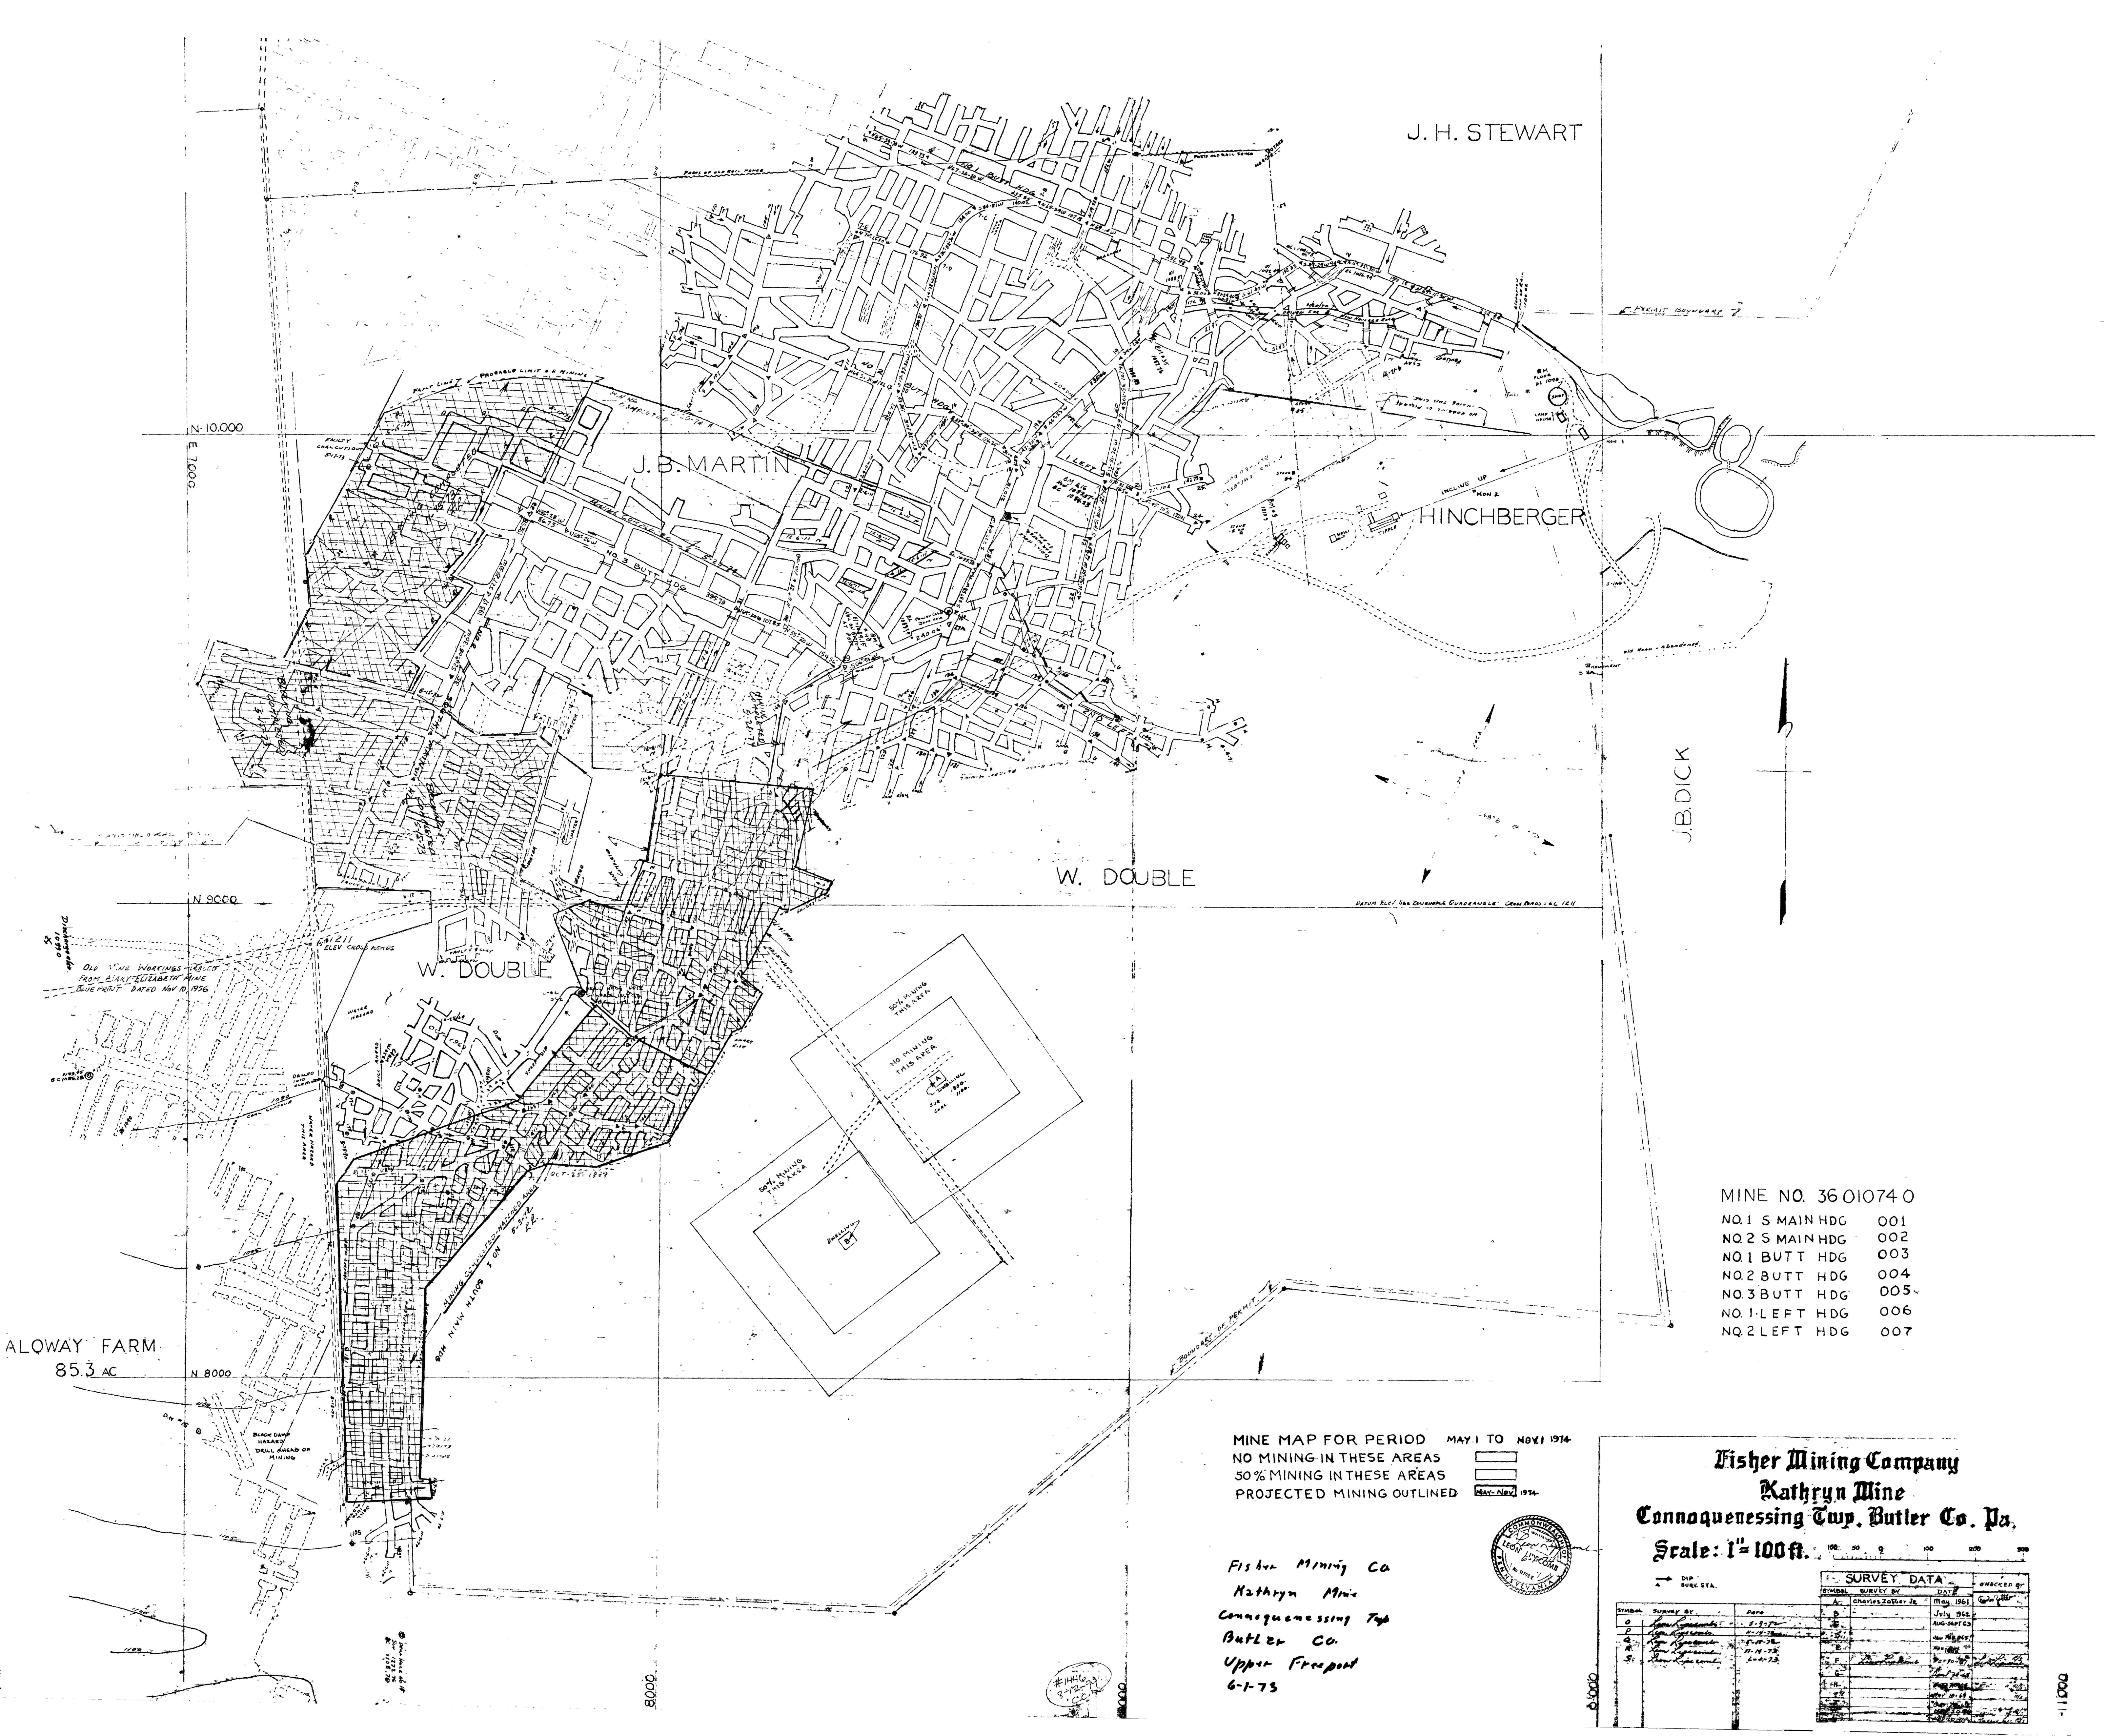

J.H. STEWART

J.B. MARTIN

HINCHBERGER

J.B. DICK

W. DOUBLE

W. DOUBLE

- MINE NO. 36 01074 0
- NQ.1 S MAIN HDG 001
 - NQ.2 S MAIN HDG 002
 - NQ.1 BUTT HDG 003
 - NQ.2 BUTT HDG 004
 - NQ.3 BUTT HDG 005
 - NQ.1 LEFT HDG 006
 - NQ.2 LEFT HDG 007

MINE MAP FOR PERIOD MAY 1 TO NOV 1 1974
NO MINING IN THESE AREAS
50% MINING IN THESE AREAS
PROJECTED MINING OUTLINED

Fisher Mining Co
Kathryn Mine
Connoquenessing Twp
Butler Co.
Upper Freeport
6-1-73



Fisher Mining Company
Kathryn Mine
Connoquenessing Twp. Butler Co. Pa.
Scale: 1"=100 ft.

SURVEY DATA				CHECKED BY	
SYMBOL	SURVEY BY	DATE	SYMBOL	SURVEY BY	DATE
0	Leon J. Stewart	5-1-74	1	Charles J. Stewart	7-1-74
