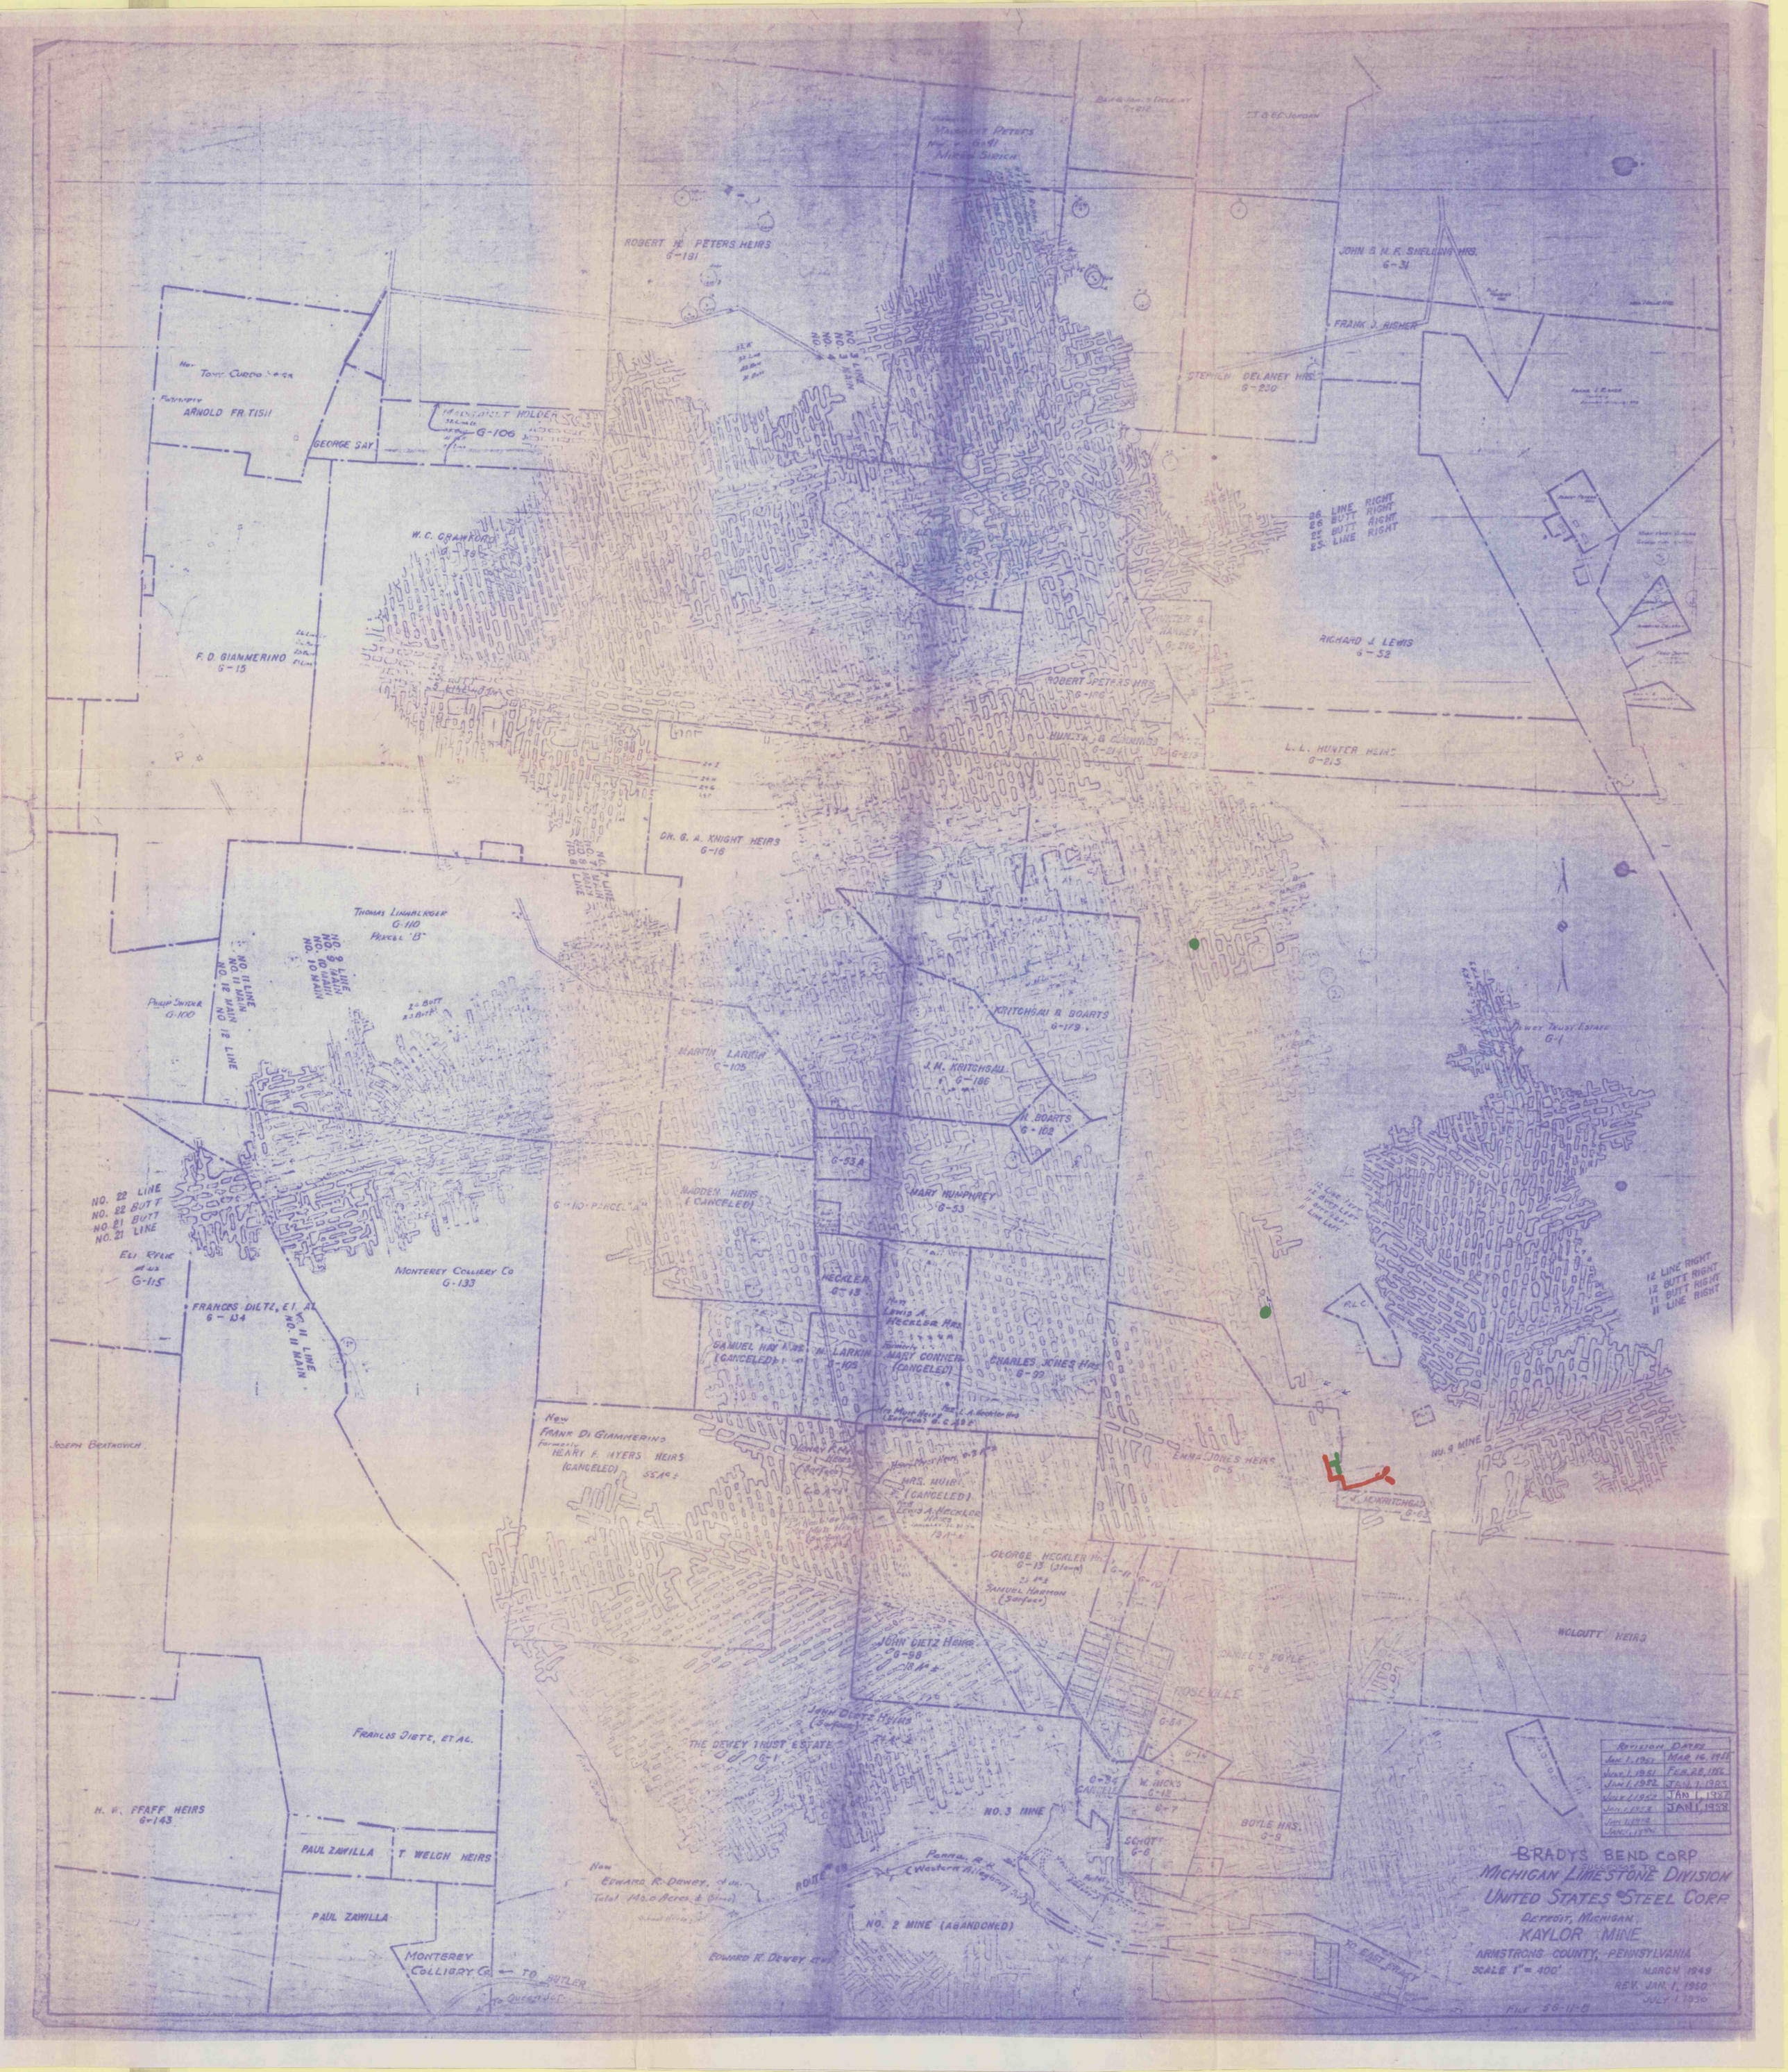
ROBERT H. PETERS HEIRS
G-131
JOHN & M. F. SHELLING HRS.
G-31
FRANK J. FISHER
STEPHEN DELANEY HRS.
G-230
ARNOLD FR. TISH
GEORGE SAY
G-106
W. C. CRAWFORD
F. D. GIANMERINO
G-15
26 LINE RIGHT
26 BUTT RIGHT
25 BUTT RIGHT
25 LINE RIGHT
RICHARD J. LEWIS
G-52
ROBERT PETERS HRS.
G-106
L. L. HUNTER HEIRS
G-213
DR. G. A. KNIGHT HEIRS
G-16
THOMAS LINWALKER
G-110
PARCEL "B"
PHILIP SNYDER
G-100
KRITCHGAU & BOARTS
G-179
MARTIN LARKIN
G-105
J. M. KRITCHGAU
G-186
H. BOARTS
G-102
G-53 A
MADDEN HEIRS
(CANCELED)
MARY HUMPHREY
G-53
22 LINE
22 BUTT
21 BUTT
21 LINE
ELI RELIC
G-115
MONTEREY COLLIERY CO
G-133
FRANCES DIETZ, ET. AL
G-134
HECKLER
G-13
LEWIS A. HECKLER HRS.
SAMUEL HAY HRS.
(CANCELED)
M. LARKIN
G-105
MARY CONNER
(CANCELED)
CHARLES JONES HRS.
G-99
12 LINE RIGHT
12 BUTT RIGHT
11 BUTT RIGHT
11 LINE RIGHT
JOSEPH BRATKOVICH
FRANK DI GIAMMERINO
HENRY F. MYERS HEIRS
(CANCELED)
HRS. MUIR
(CANCELED)
EMMA JONES HEIRS
G-5
NO. 9 MINE
GEORGE HECKLER HRS.
G-13 (Stone)
SAMUEL HARMON
(Surface)
WOLCUTT HEIRS
JOHN DIETZ HEIRS
G-98
DANIEL BOYLE
G-8
ROSEVILLE
FRANCIS DIETZ, ET AL.
THE DEWEY TRUST ESTATE
G-1
H. W. PFAFF HEIRS
G-143
W. HICKS
G-12
SCHOTT
G-6
BOYLE HRS.
G-8
NO. 3 MINE
PAUL ZAWILLA
T. WELCH HEIRS
PAUL ZAWILLA
Now
EDWARD R. DEWEY, et ux.
Total 140.0 Acres ± (Stone)
ROUTE #28
Penna. R.R.
(Western Allegheny Jct.)
NO. 2 MINE (ABANDONED)
EDWARD R. DEWEY, et ux.
MONTEREY COLLIERY CO. ← TO BUTLER
TO QUEEN ST.
TO EAST PITTSBURGH
REVISION DATES
JAN. 1, 1951 MAR. 16, 1951
JUNE 1, 1951 FEB. 28, 1956
JAN. 1, 1952 JAN. 1, 1953
JULY 1, 1952 JAN. 1, 1957
JAN. 1, 1953 JAN. 1, 1958
BRADYS BEND CORP
SUCCESSOR TO
MICHIGAN LIMESTONE DIVISION
UNITED STATES STEEL CORP
DETROIT, MICHIGAN
KAYLOR MINE
ARMSTRONG COUNTY, PENNSYLVANIA
SCALE 1" = 400'
MARCH 1949
REV. JAN. 1, 1950
JULY 1, 1950
FILE 56-1-8