


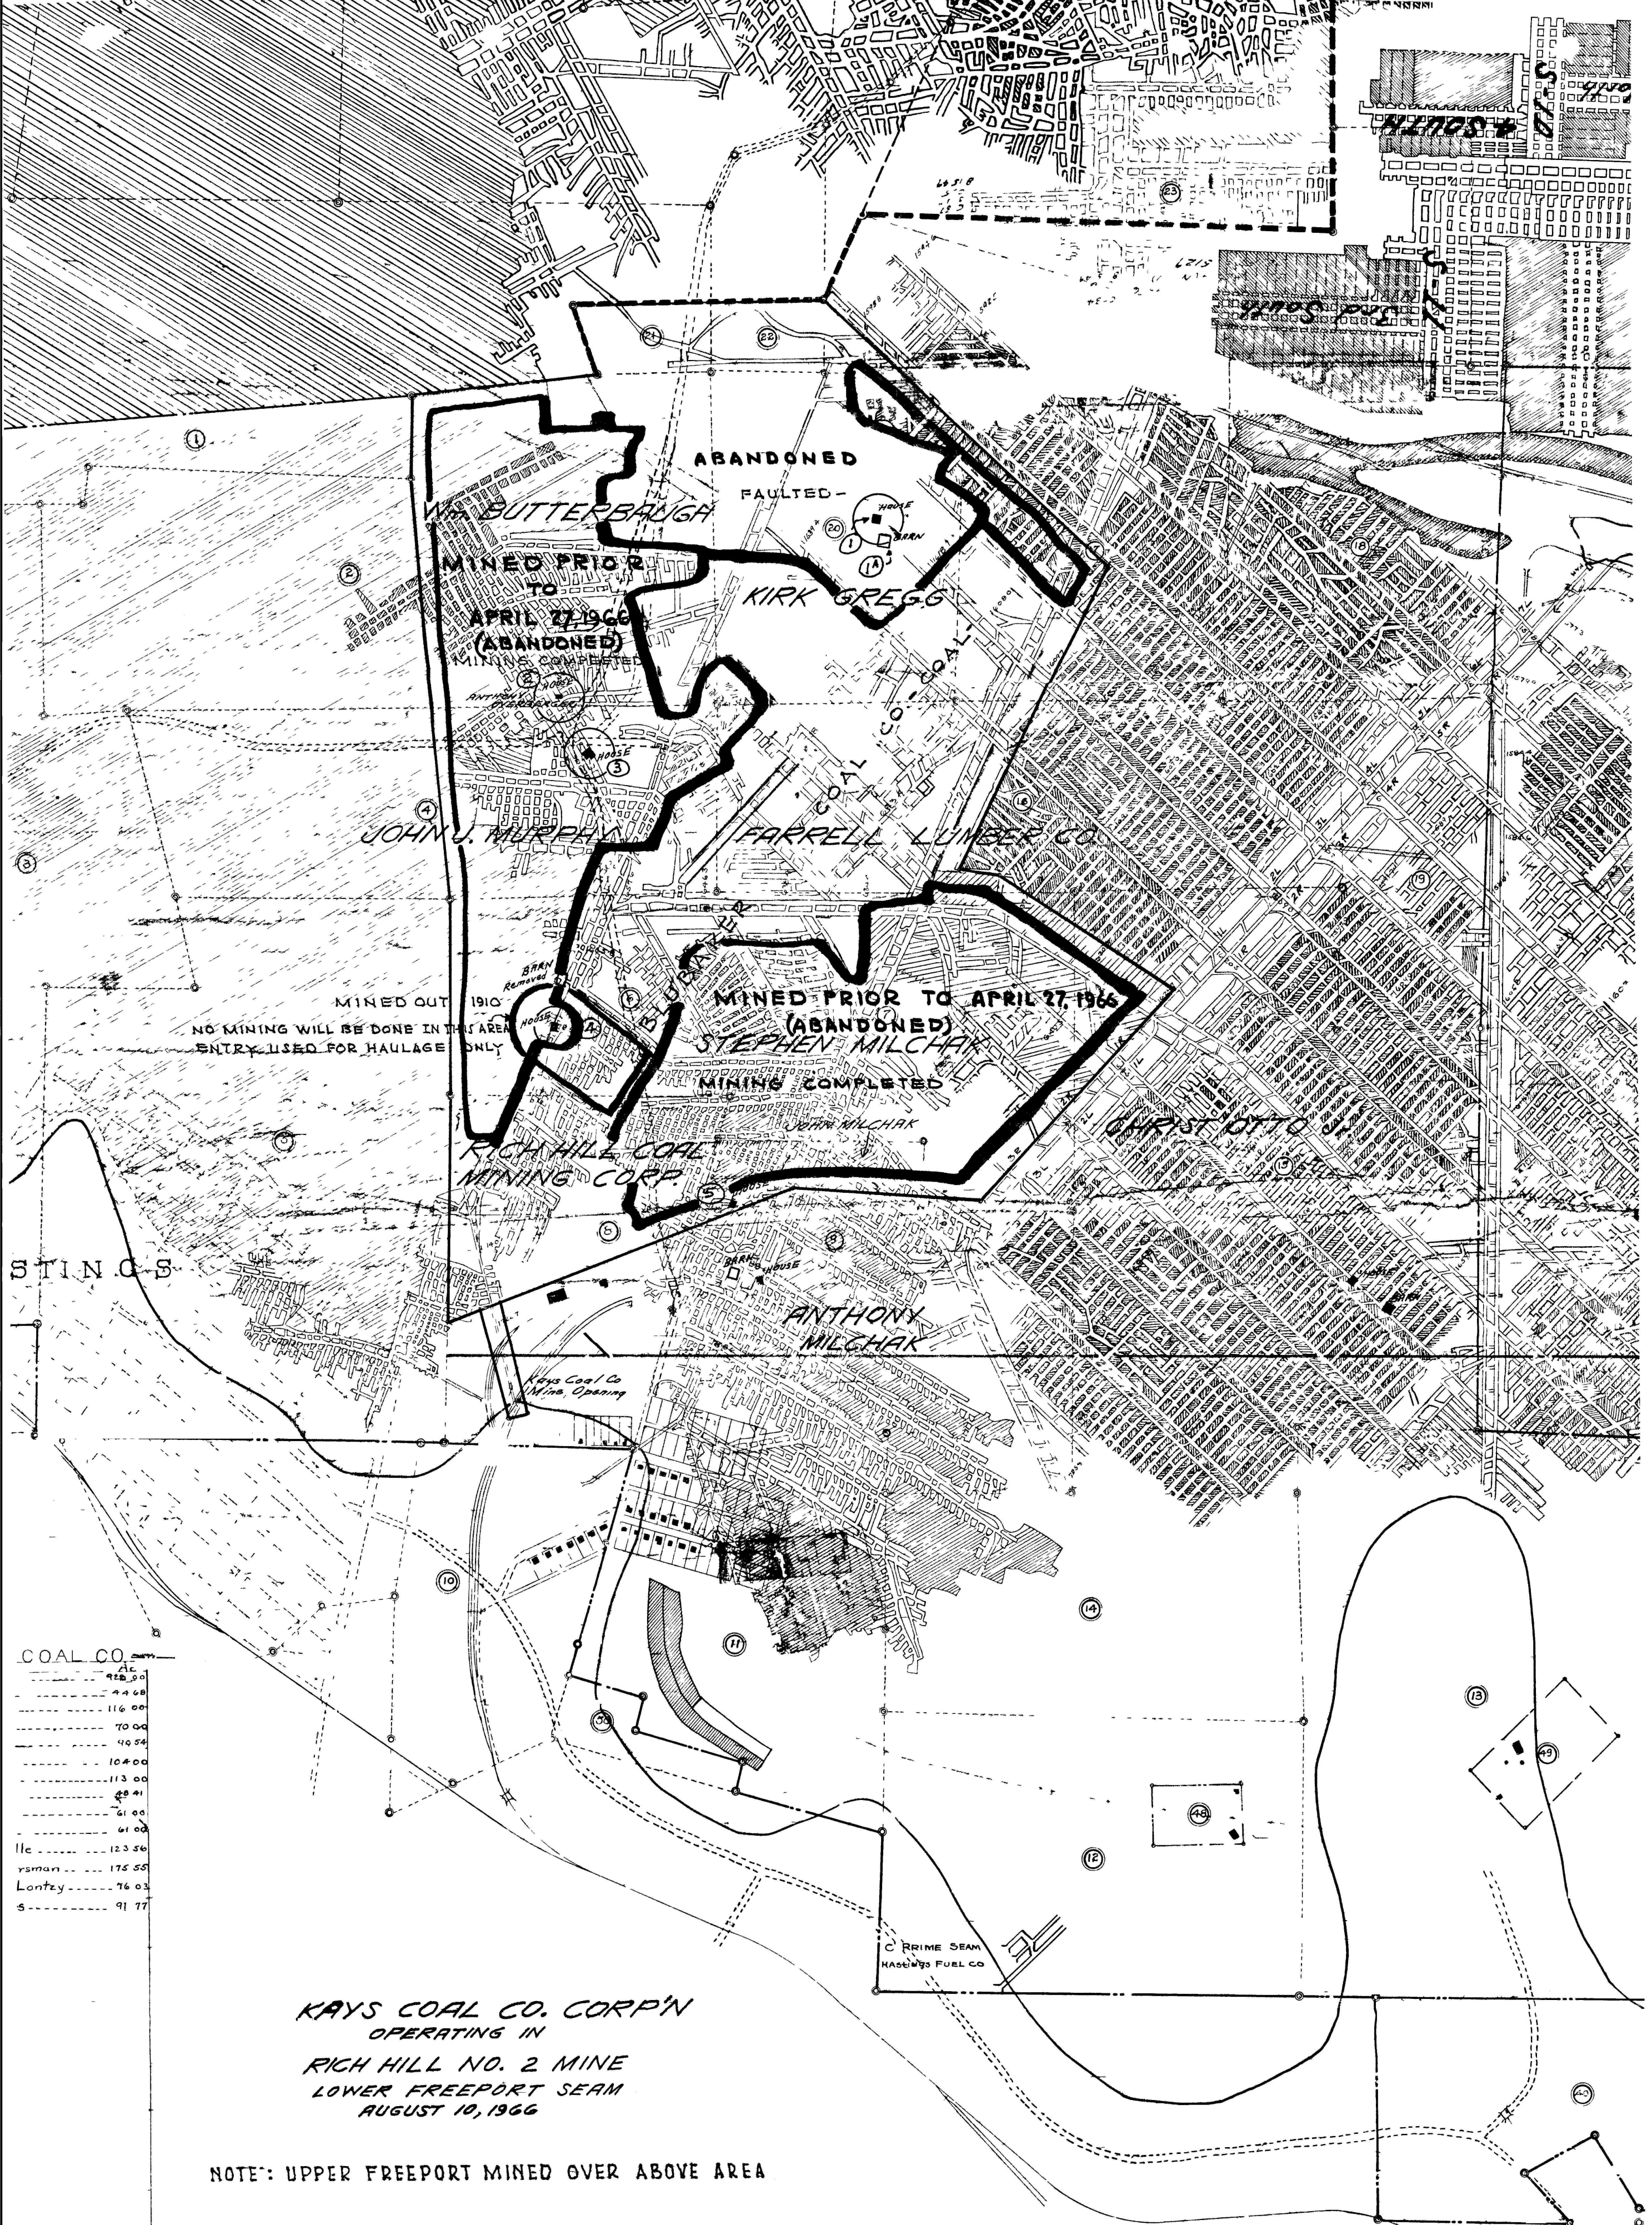

COAL CO.	FEET
412.00	412.00
44.68	44.68
116.00	116.00
70.00	70.00
40.54	40.54
104.00	104.00
113.00	113.00
69.41	69.41
61.88	61.88
61.00	61.00
112	112
123.56	123.56
175.55	175.55
76.03	76.03
91.77	91.77

KAYS COAL CO. CORP'N
OPERATING IN
RICH HILL NO. 2 MINE
LOWER FREEPORT SEAM
AUGUST 10, 1966

NOTE: UPPER FREEPORT MINED OVER ABOVE AREA

MAP OF
~~RICH HILL NO. 2 MINE~~
OPERATED BY
~~RICH HILL COAL CO.~~
HASTINGS, CAMBRIA CO. PENNA.

SCALE IN FEET
Chas E Schlicher, Engr

WORKINGS SHOWN TO

LEGEND
AREA TO BE MINED OUTLINED IN RED
BOUNDARY OF SURFACE OVERLYING MINE
AREAS IN WHICH MINING IS COMPLETED

I, the undersigned, hereby certify that this map is correct and shows all information, to the best of my knowledge and belief, required by the mining laws of this state, and covers the period ending 6 30 66

Benjamin R. Auer
Engineer

