H.A. KEISLING COAL #1

Collier Twp. Alley. Co. Pa.

Scale 1" = 100' Sept. 1934. O.B. Higley, Engr.

June 19th 20th 1935 O.B. Higley, Engr.

Finished July 1st 1937.

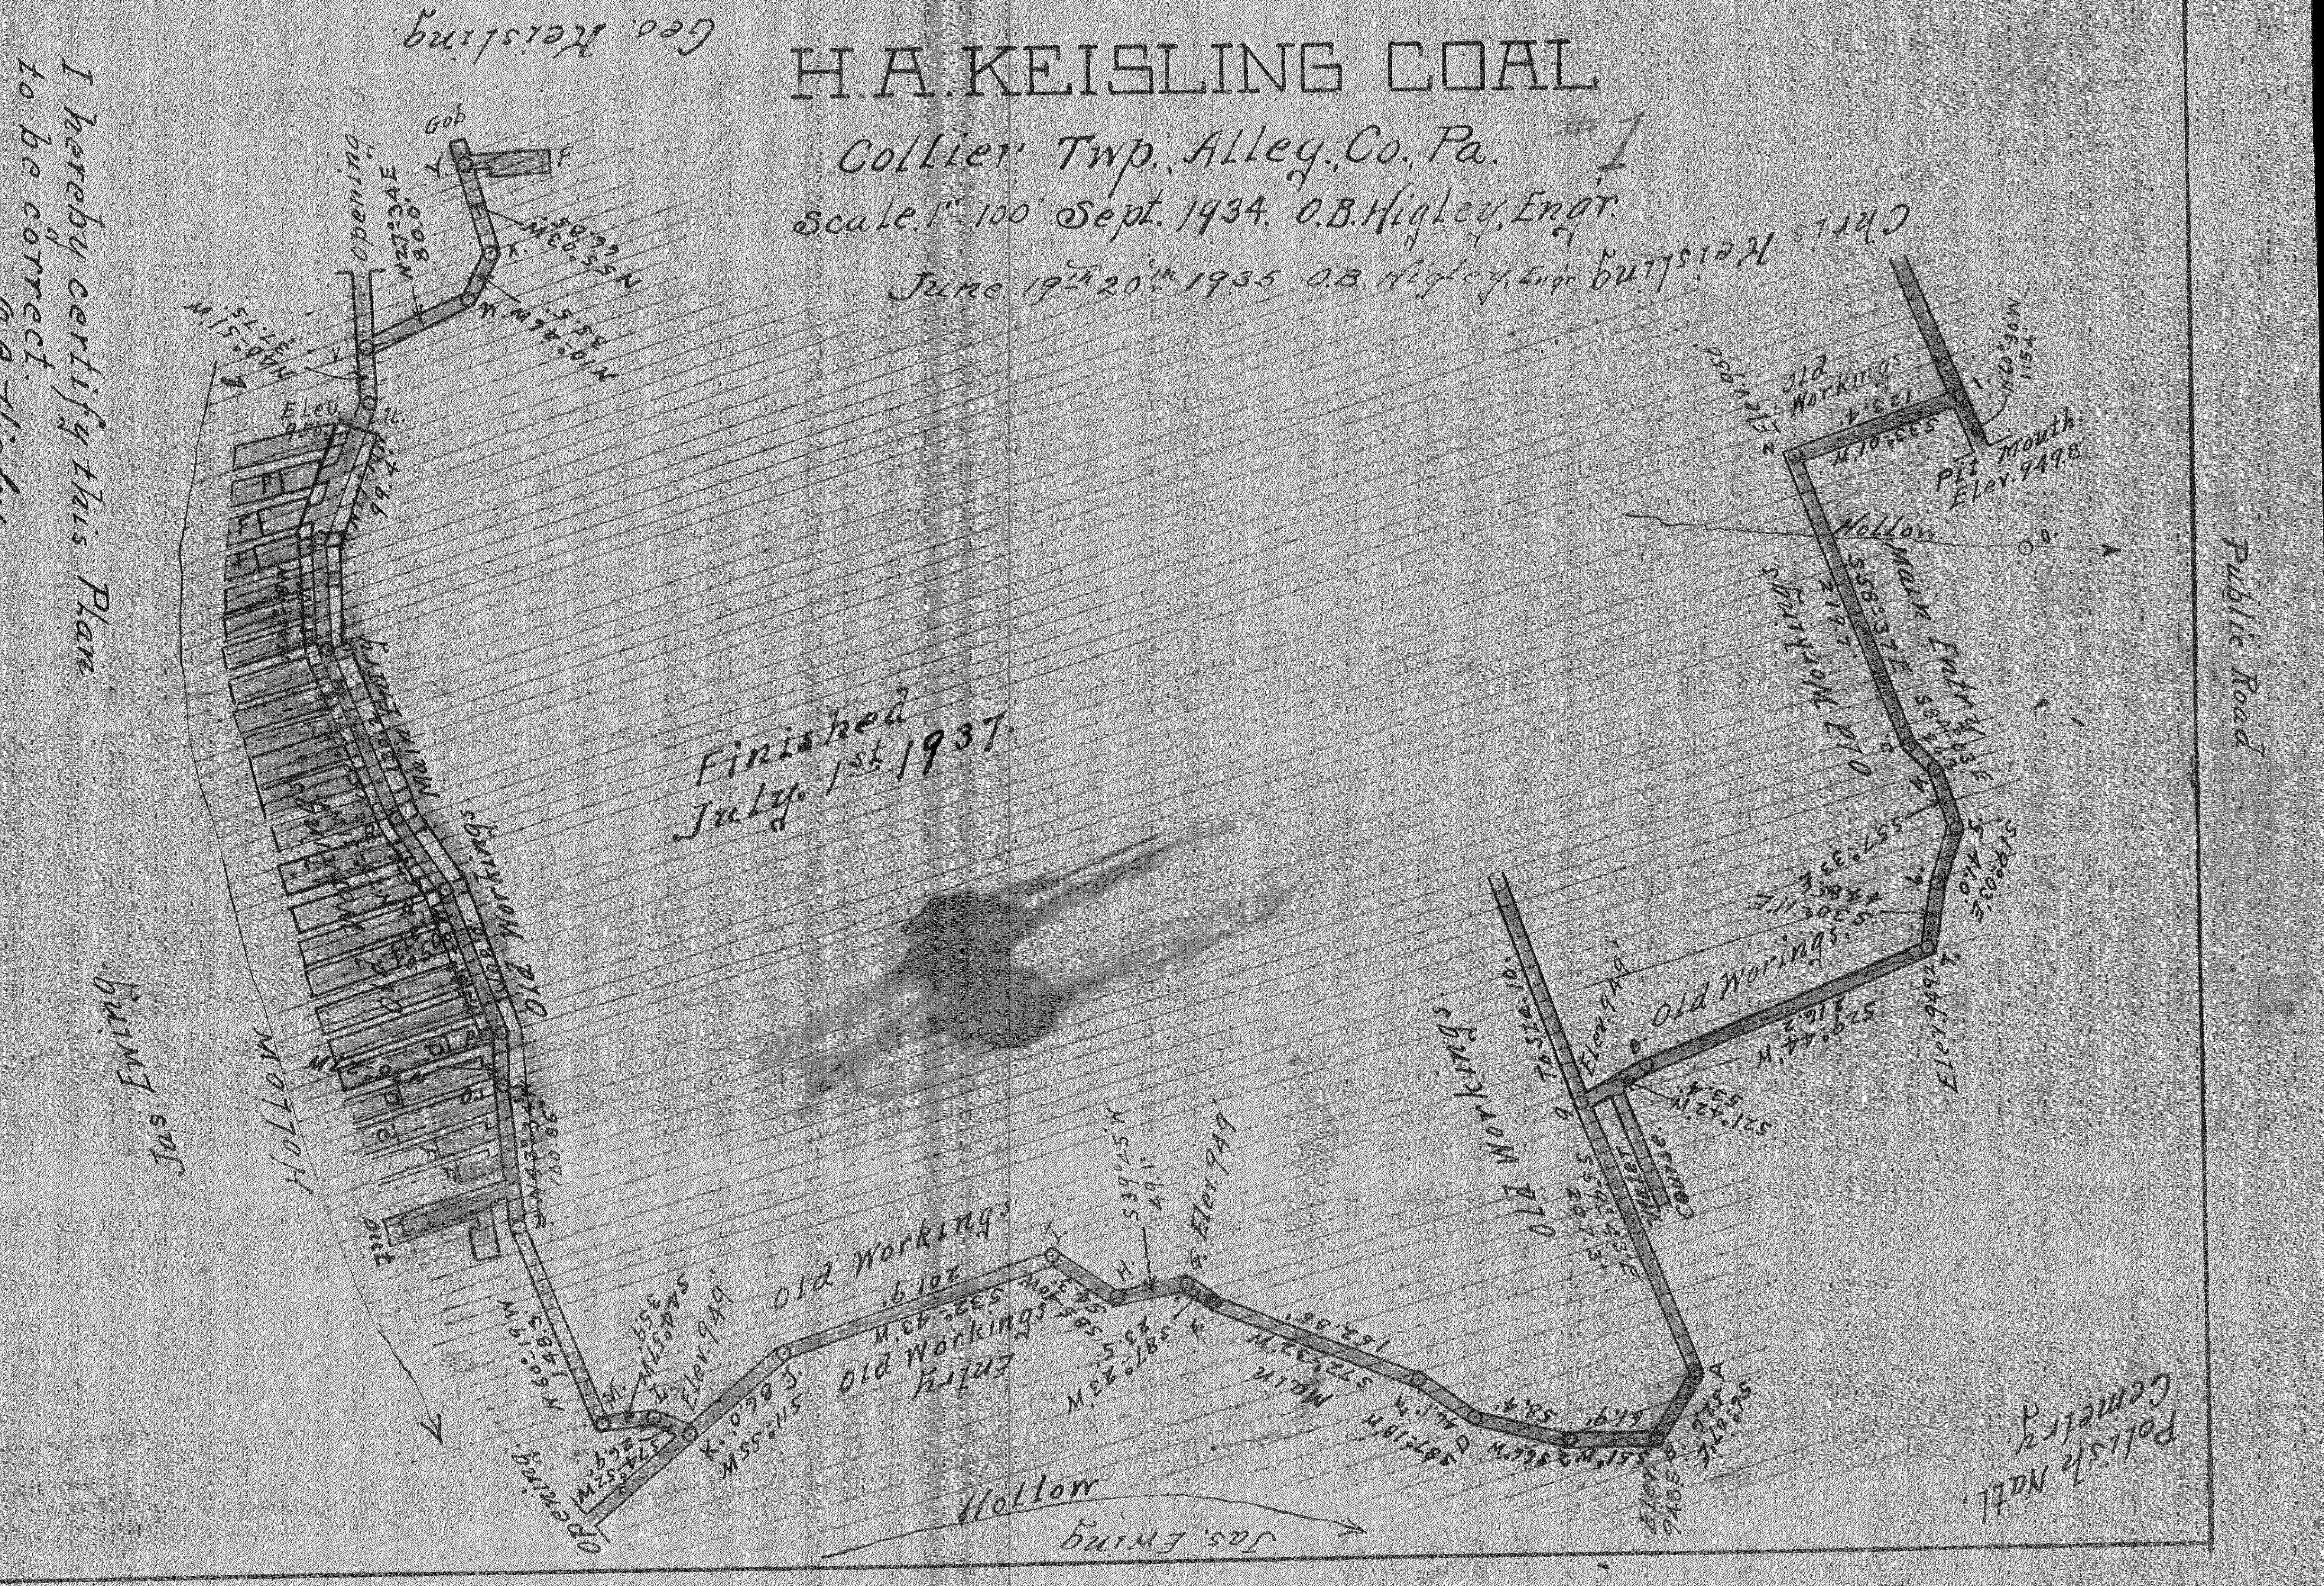

Geo. Keisling
Chris Keisling
Gob
Y.
F.
Opening
N27°34'E 80.0'
N55°03'W 66.85
K.
W.
N10°46'W 35.5
N46°51'W 73.15
Elev. 950
U.
94.4
Main Entry
Old Workings
Jas. Ewing
Hollow
N43°34'W 100.85
N60°19'W 148.3
M.
S45°57'W 35.9
L.
Elev. 949
S74°52'W 26.9
Opening
K.
S11°55'W 98.0
J.
Old Workings
201.9
S32°43'W
Old Workings
Entry
I.
S85°40'W 54.3
H.
S39°25'W 49.1
G. Elev. 949
F.
S87°23'W 23.5
Main
S72°32'W 162.86
E.
S87°18'W 46.1
D
58.4
S56°36'W
61.9
S51°W
B.
S5°17'E 27.5
A
Elev. 948.5
Hollow
Jas. Ewing
Old Workings
To Size 10
Elev. 949
9
8
S55°43'E 207.3
Water Course
S21°42'W 53.4
Old Worings
S29°44'W 216.2
7
Elev. 949.2
6
S30°11'E 48.5
S19°03'E 41.0
5
S57°33'E
4
S84°03'E 26.3
3
Main Entry
S58°37'E 219.7
2
Old Workings
Hollow
0.
Elev. 950
Old Workings
S33°01'W 123.4
1.
N60°30'W 115.4
Pit Mouth Elev. 949.8'
Public Road
Polish Natl. Cemetery

I hereby certify this Plan to be correct.
O.B. Higley.