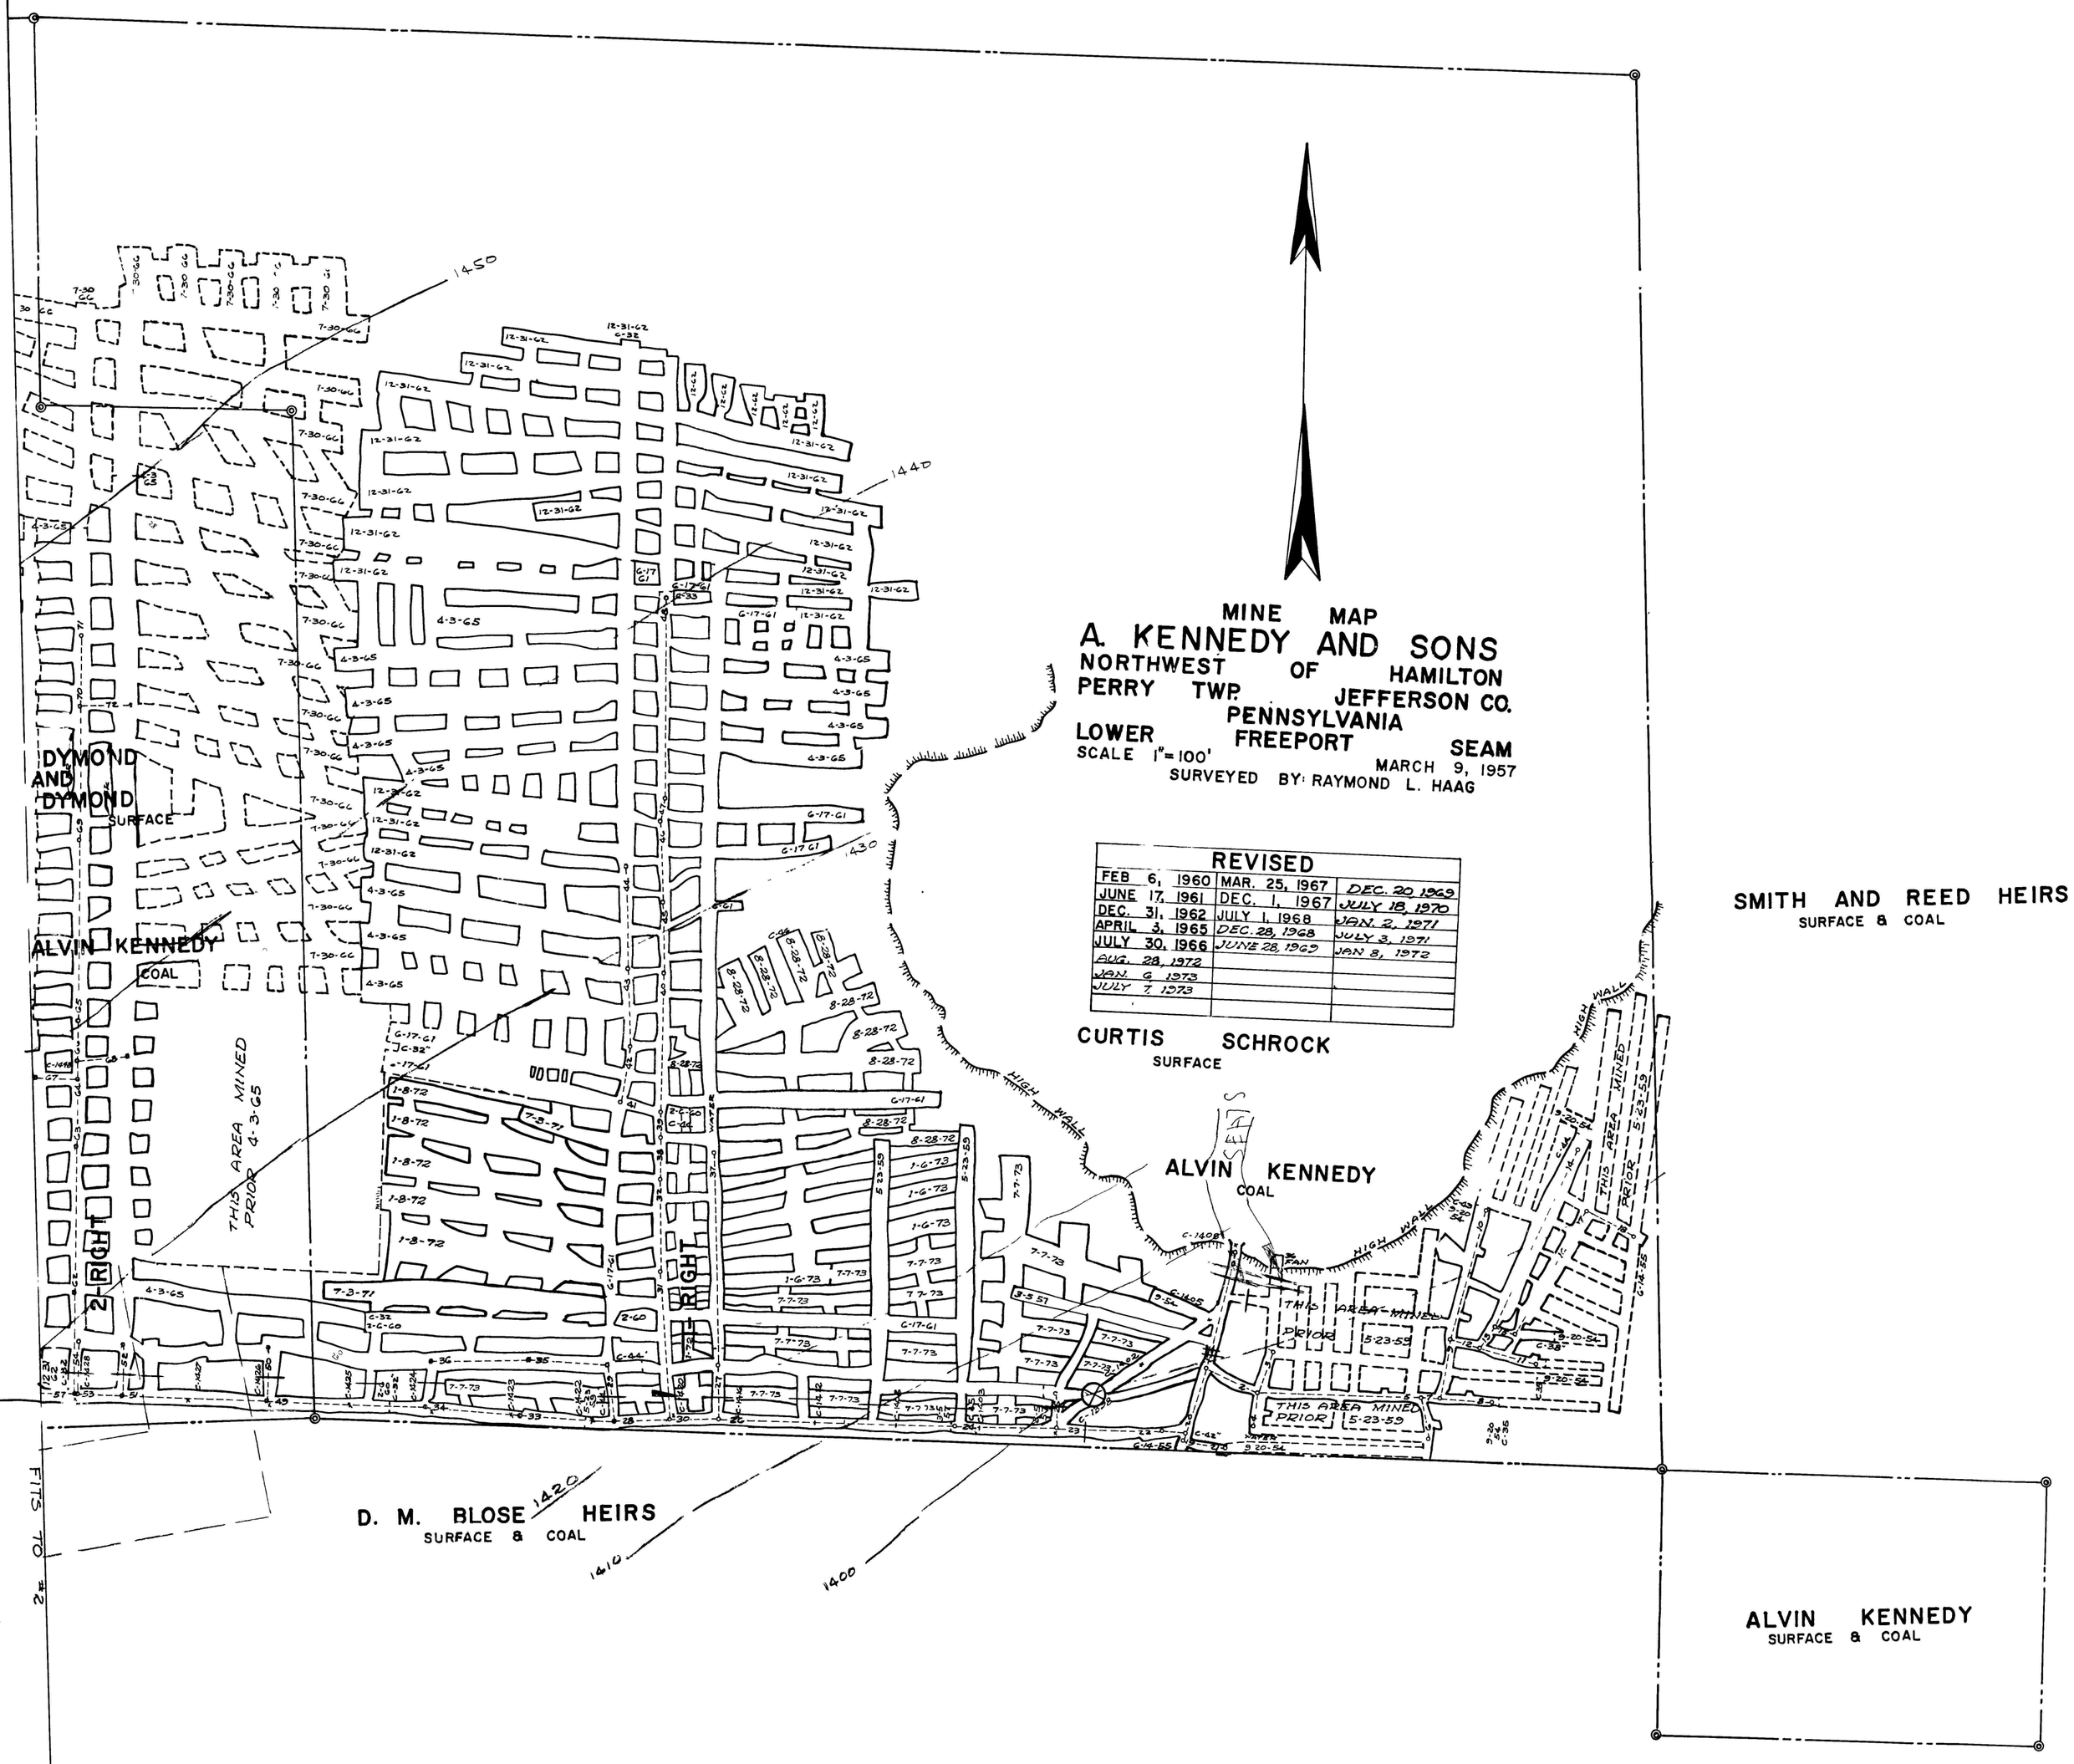

LEGEND

AREA OUTLINED IN BLUE SHOWS MINE PROPERTY AND LIMIT OF MINING OPERATIONS TO BE CONDUCTED UNDER THE PERMIT REQUESTED.

AREA OUTLINED IN RED SHOWS MINING TO BE DONE DURING THE SIX MONTH PERIOD.

BROKEN LINES IN BLACK SHOWS PROTECTED AREA.

? STRUCTURE AND NUMBER.

AREA OUTLINED IN GREEN SHOWS AREA MINED TO

AREA IN HATCHED GREEN SHOWS MINING COMPLETED.