


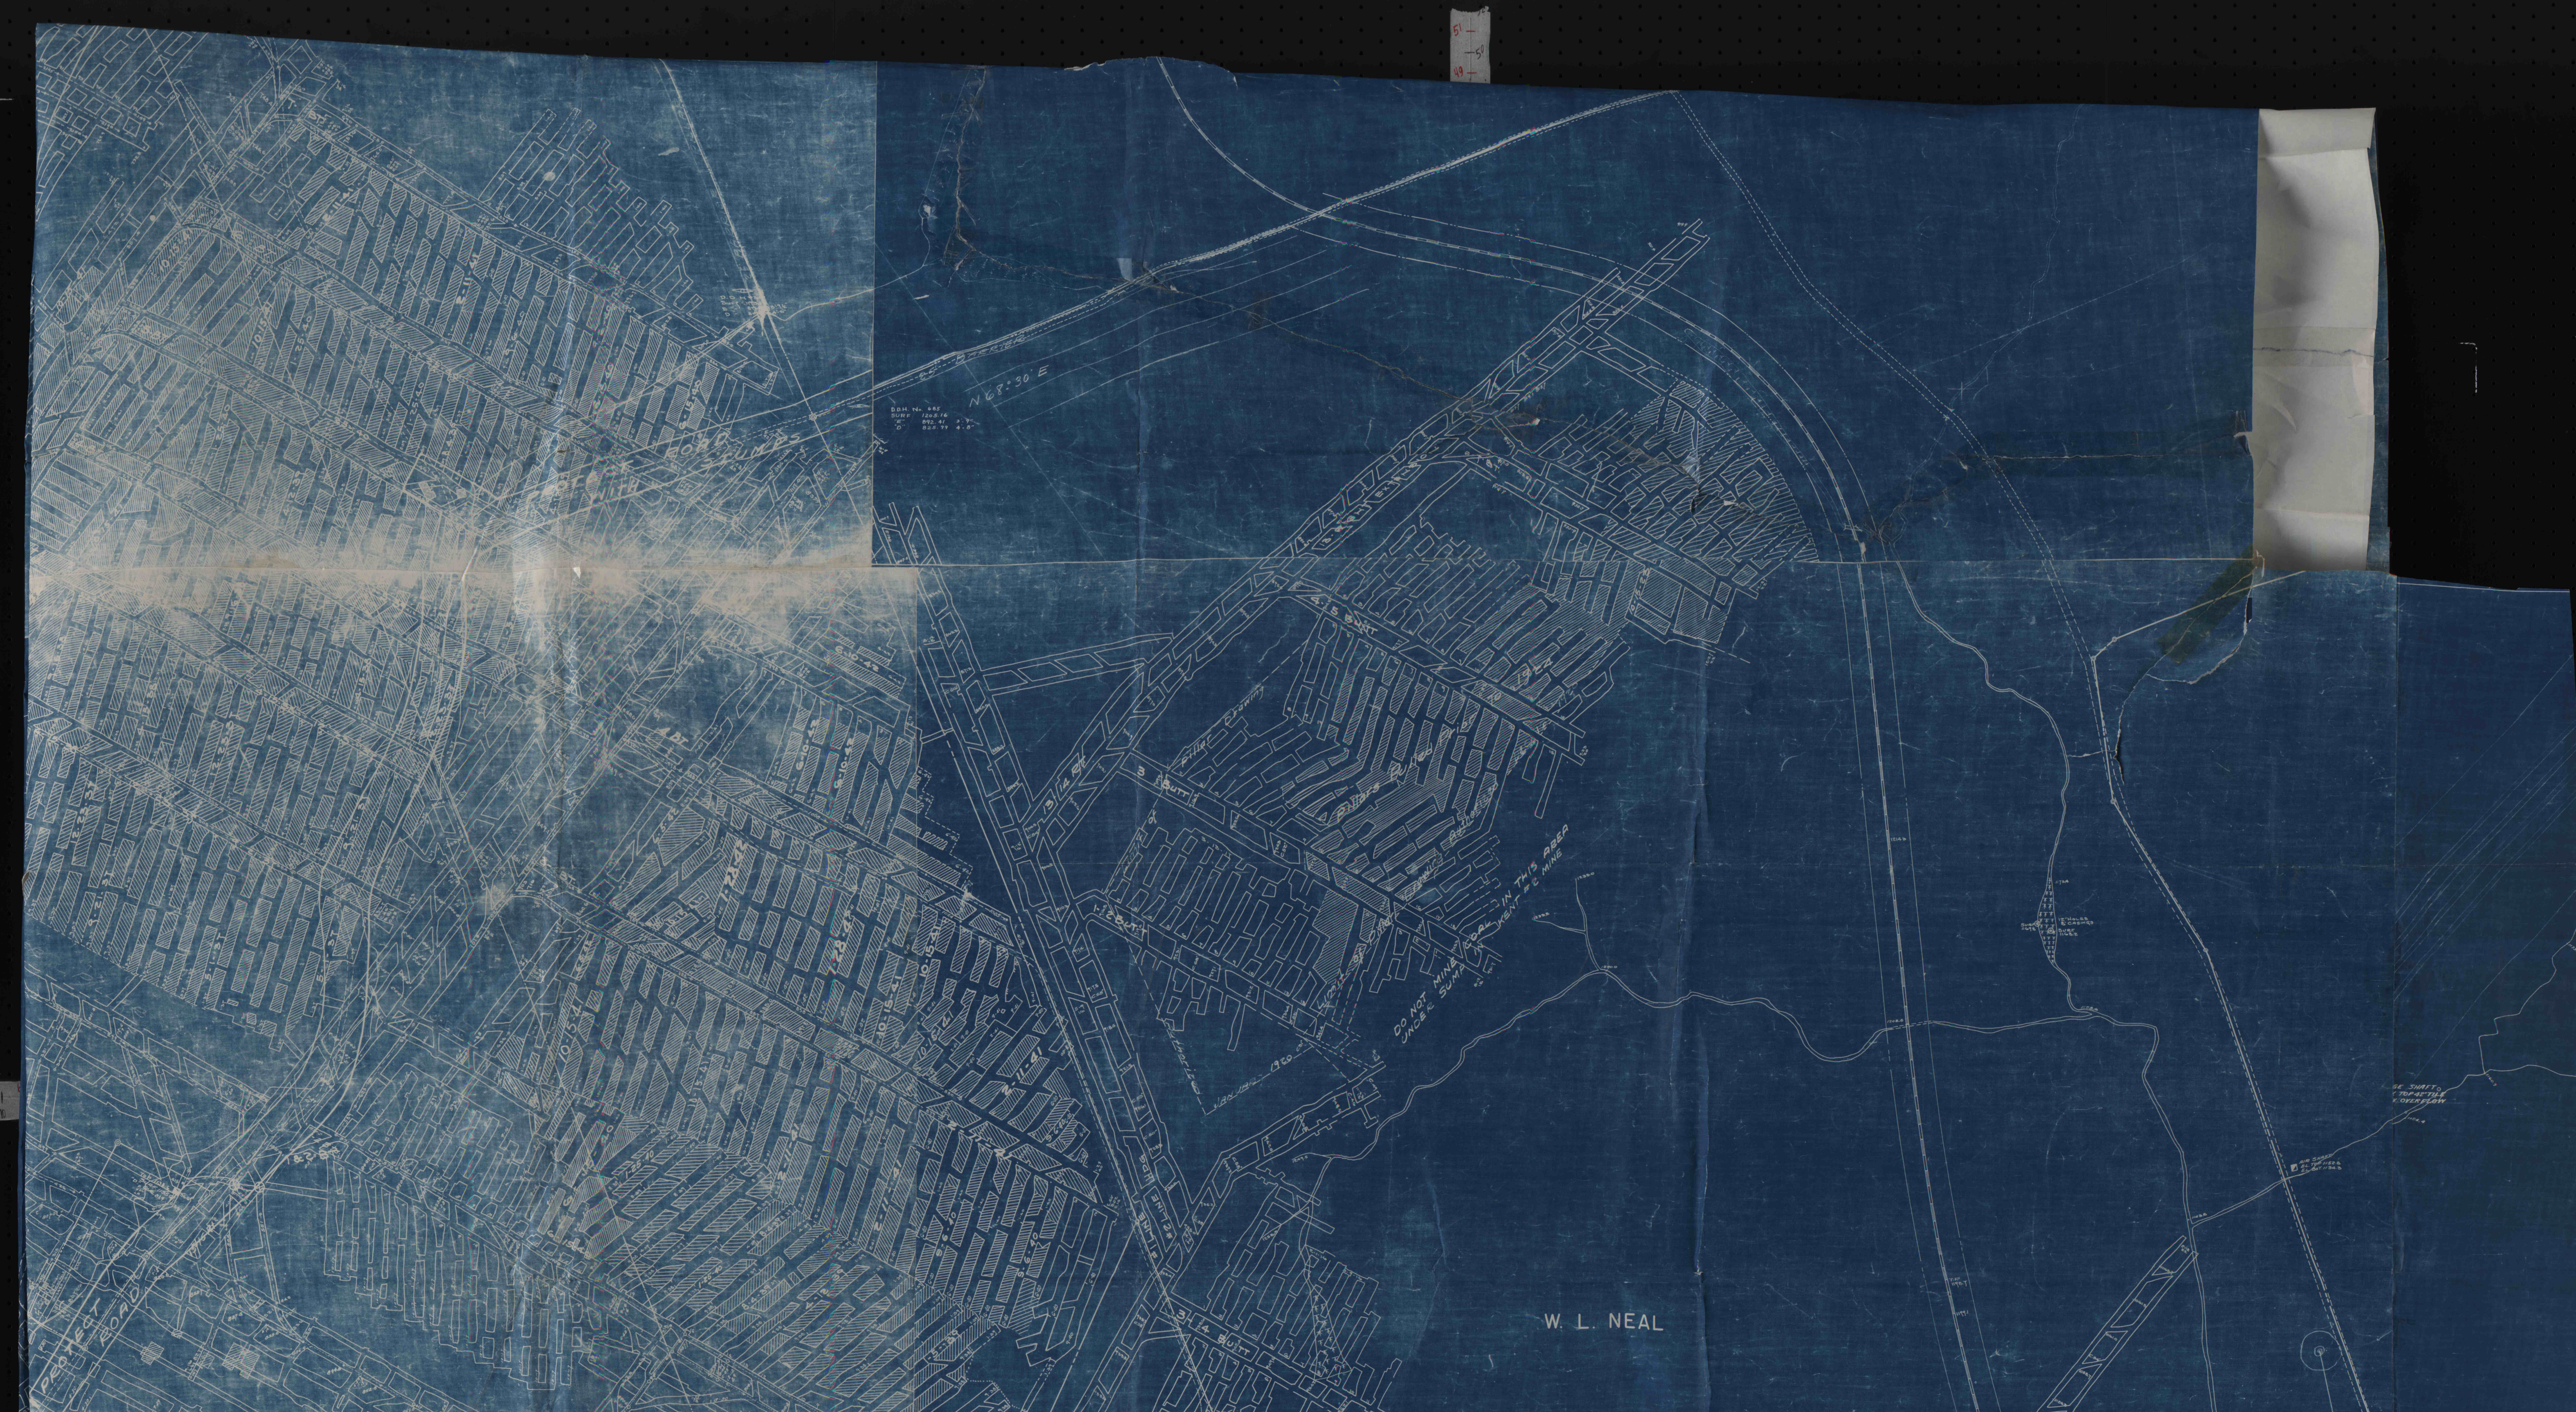

DDM. No. 885
SURF 1205.16
" 1205.41
" 1205.79 4.6"

N 68° 30' E


W. L. NEAL


