


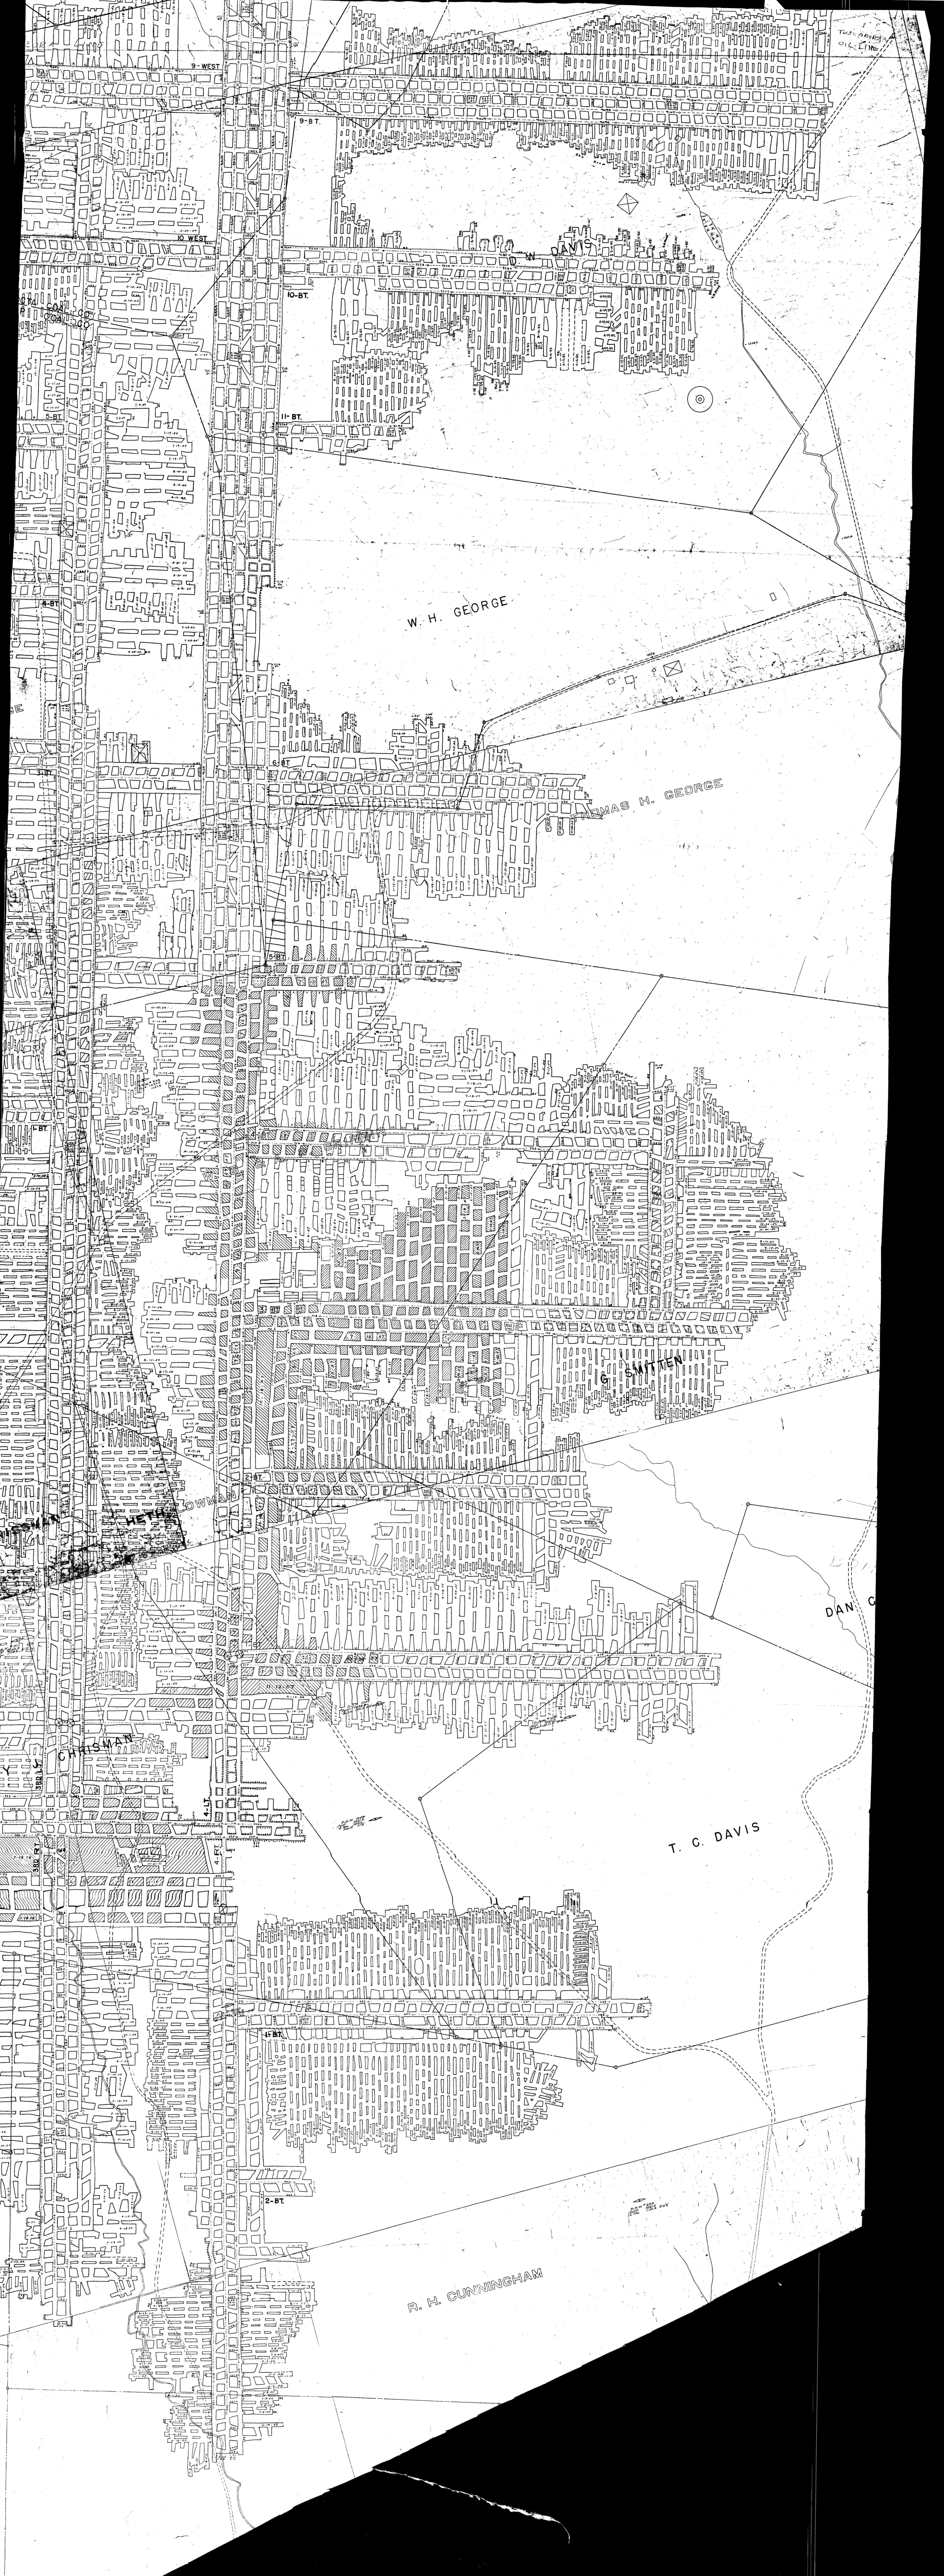

9 WEST

9-BT

10 WEST

10-BT

11-BT

W. H. GEORGE

THOMAS H. GEORGE


DAN C

T. C. DAVIS

R. H. CUNNINGHAM

2-BT