



SEAL  
Not To Scale

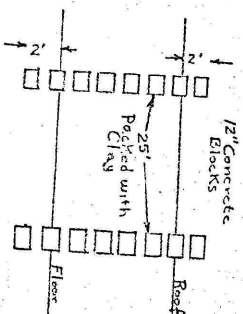

C.B. Coal blocks shown to be considered only condition beyond unknown.  
BOUNDARY OF MINING OPERATION LEAVE 50' COAL CONVENIENTLY FOR SUBSTANTIAL SURFACE SUPPORT  
CONTINGENT CONTINUED WORKING  
From 3-31-68 TO 10-1-68  
CROSS CUTS WILL BE MADE NORTH TO SOUTH TO WIDTHS OF 8 FEET WITH  
SUBSTANTIAL SUPPORTS BETWEEN BLOCK (D) WEST TO EAST, FRONTS SOUTH TO NORTH  
IN AREA IN RED AS INDICATED  
MINED - 10-1-67 TO 3-31-68

WILLIAM J. KING  
COAL CO.  
FRANK KOTOUCH ENGR.  
SOUTH HUNTINGTON TWP  
WESTMORELAND COUNTY  
PENNSYLVANIA  
SCALE 1" = 100'  
DATE JAN 10, 1967  
F.B. P.G. FILE NO. SHEET NO.

#1184-01  
8-18-67

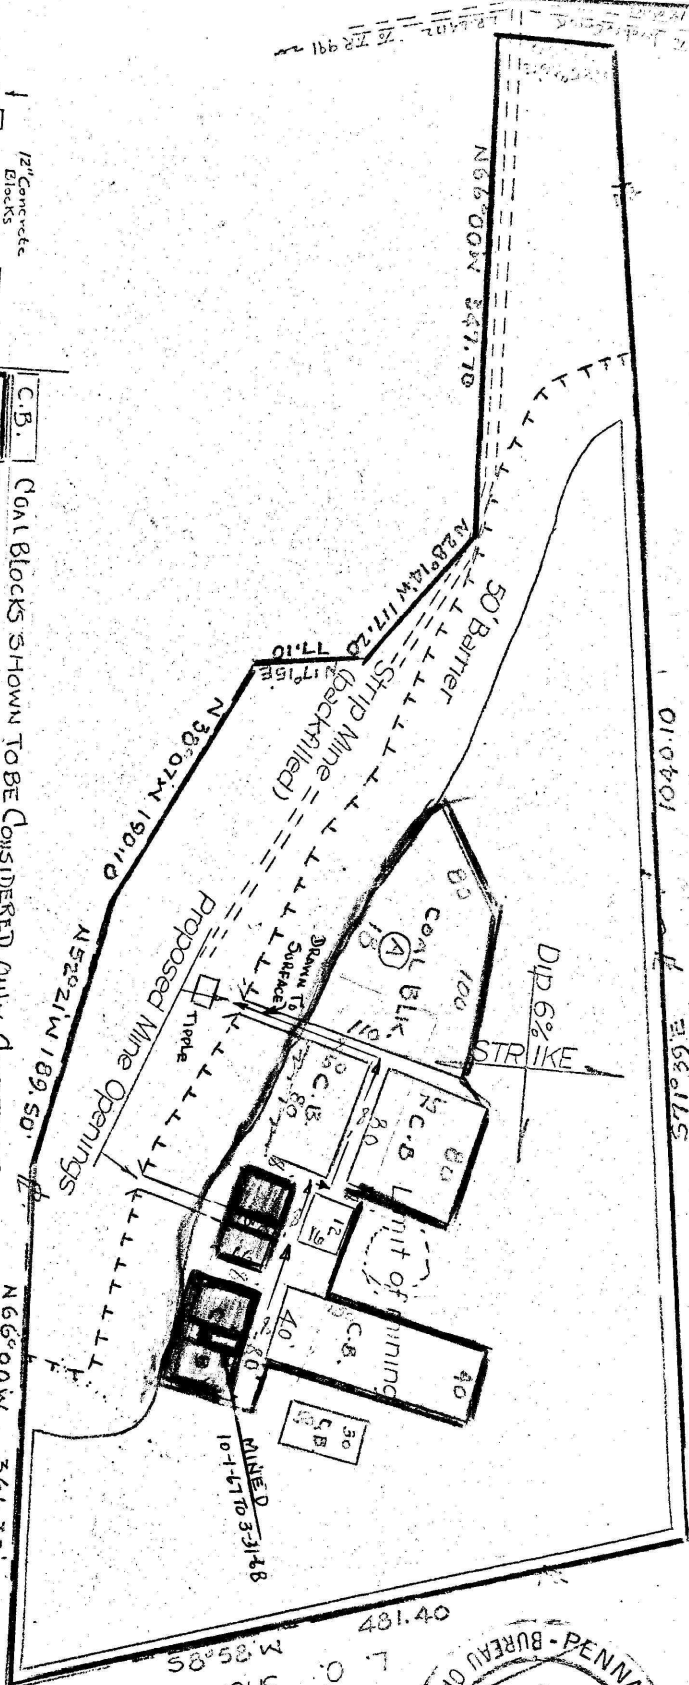

REC'D  
APR 16 1968  
BUREAU OF MINE SUBSIDENCE - PENNA. DEPT. OF MINES