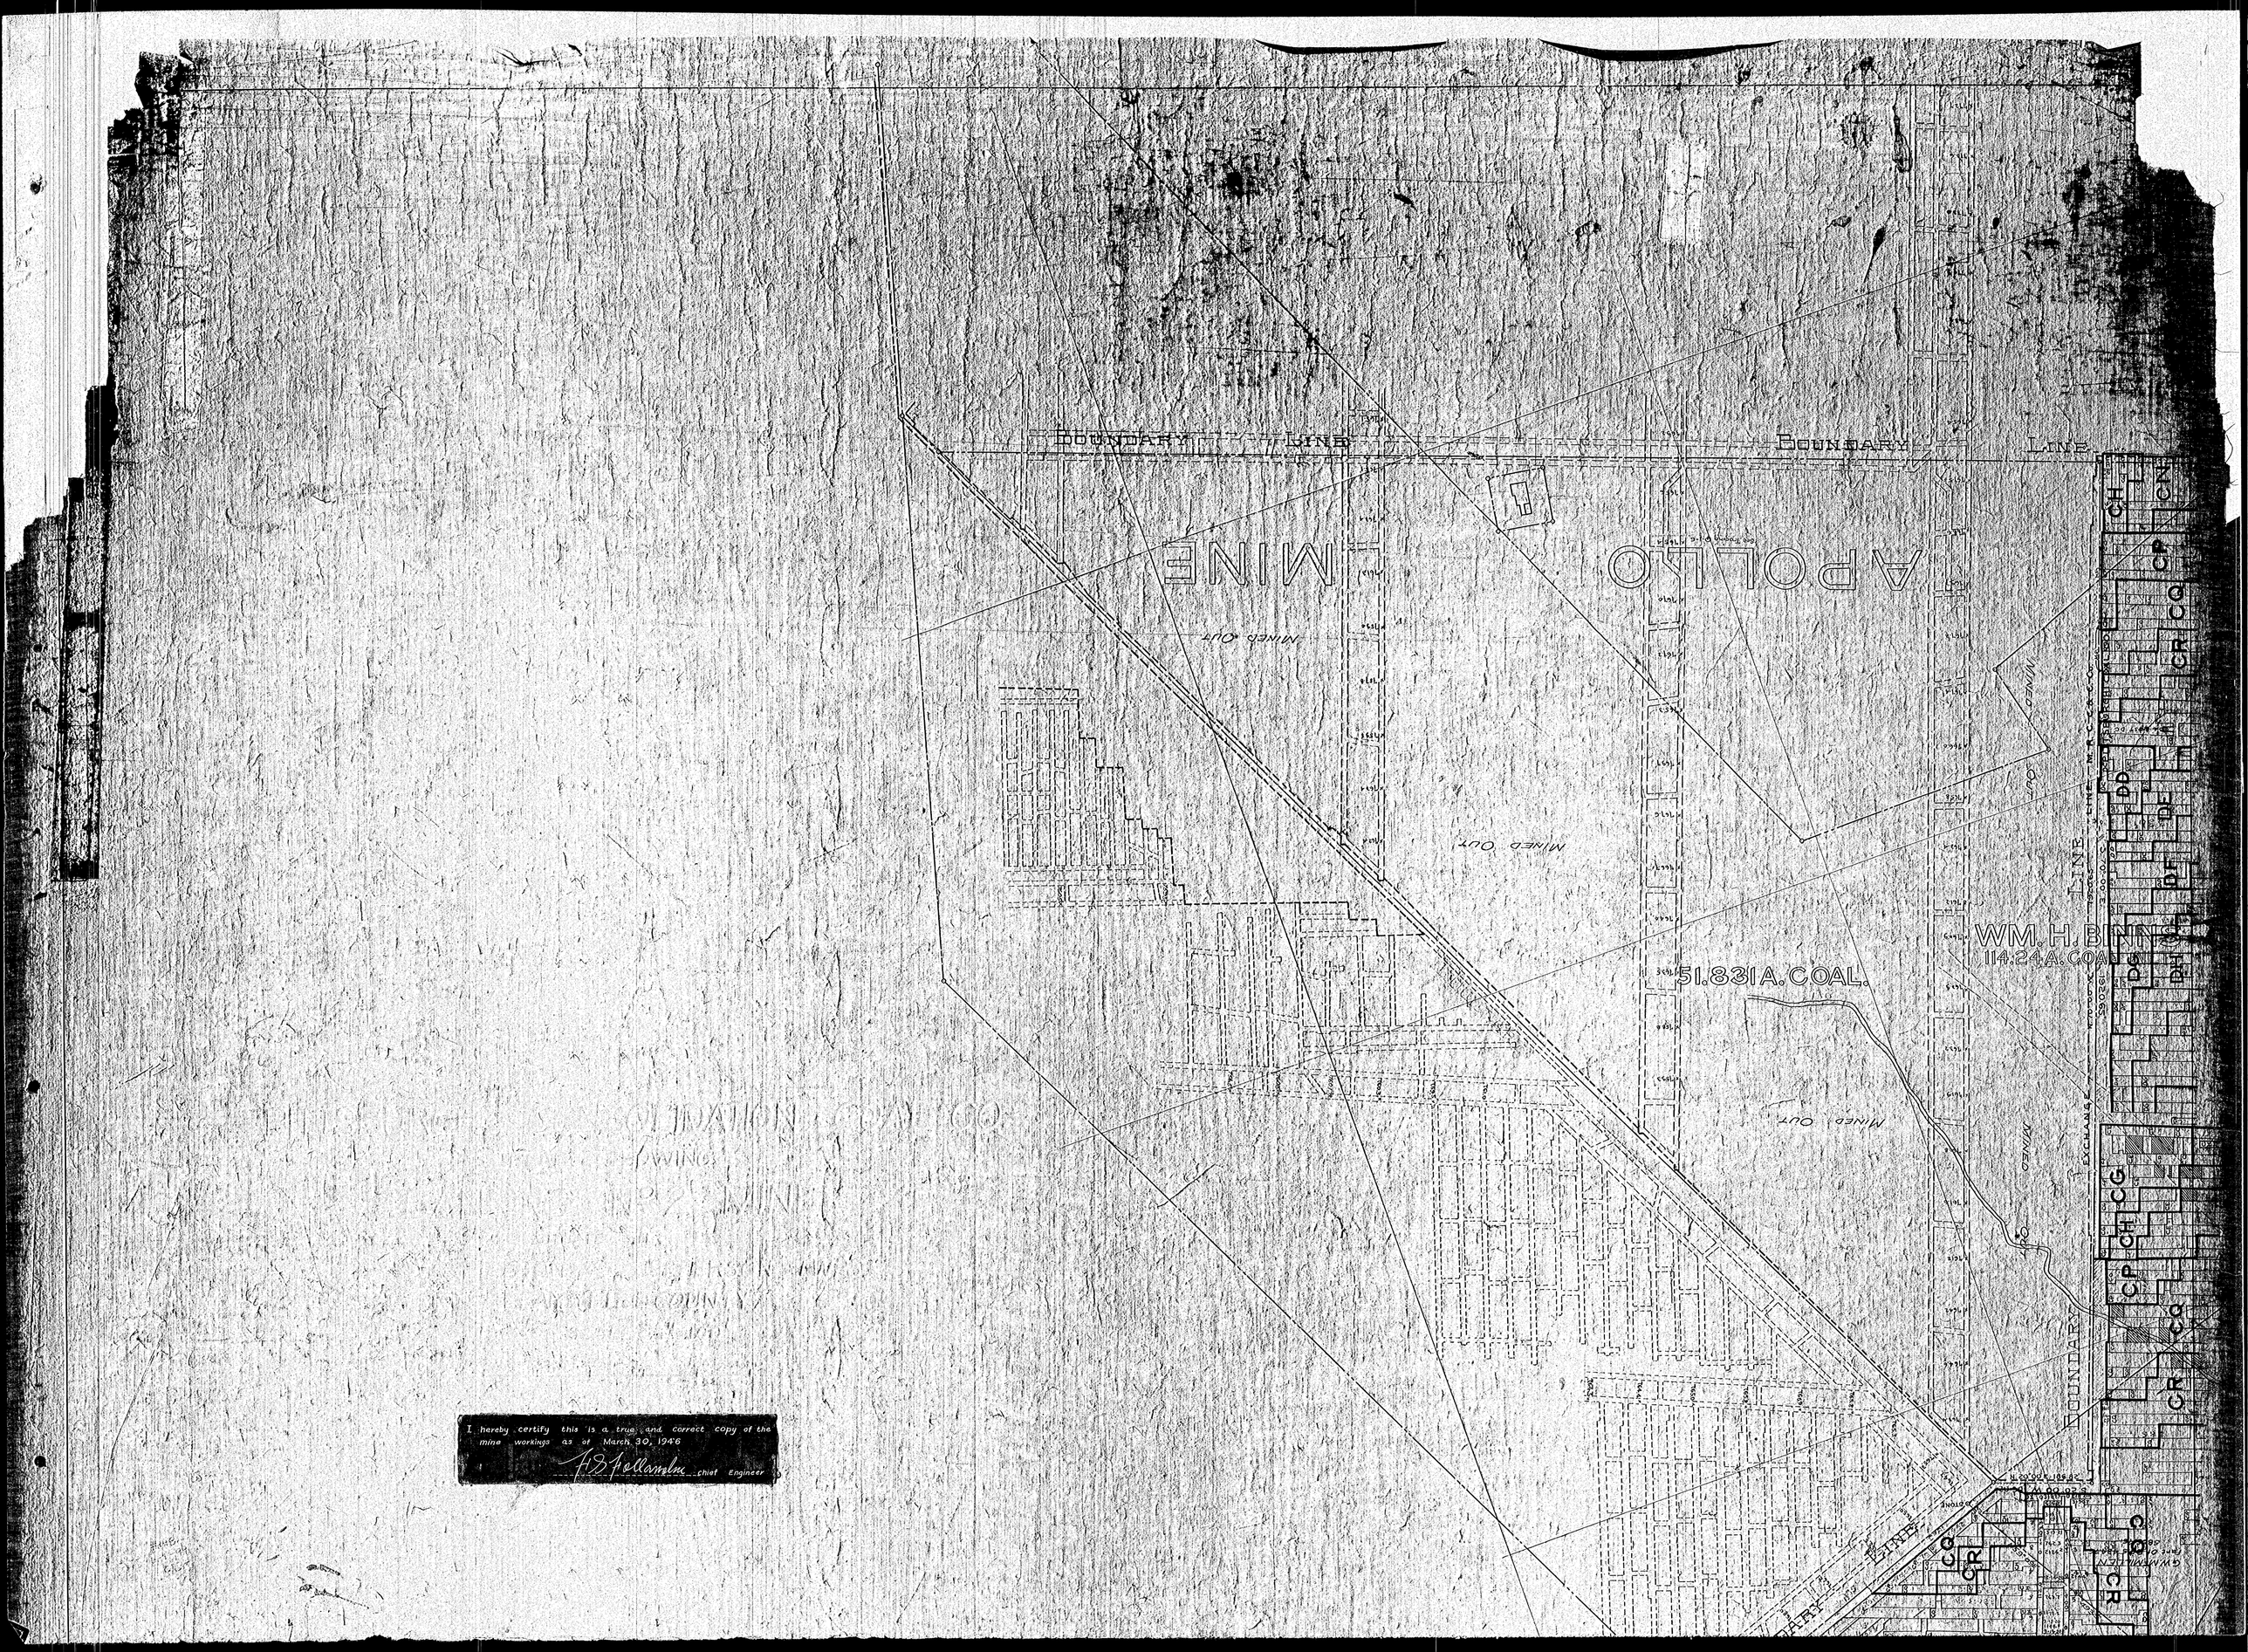

BOUNDARY LINE
BOUNDARY LINE
APOLLO MINE
See Tracing Q-6
MINED OUT
MINED OUT
MINED OUT
MINED OUT
51.831A. COAL.
WM. H. BINNS
114.24A. COAL NET
LINE
LINE M.R.C.C.&C.Co.
EXCHANGE
BOUNDARY LINE
BOUNDARY LINE
N 20°00' E 186.82'
S 20°00' W
STONE
G.W. McMILLEN
CH
CN
CP
CQ
CR
DD
DE
DF
DG
DH
CG

I hereby certify this is a true and correct copy of the mine workings as of March 30, 1946

chief Engineer