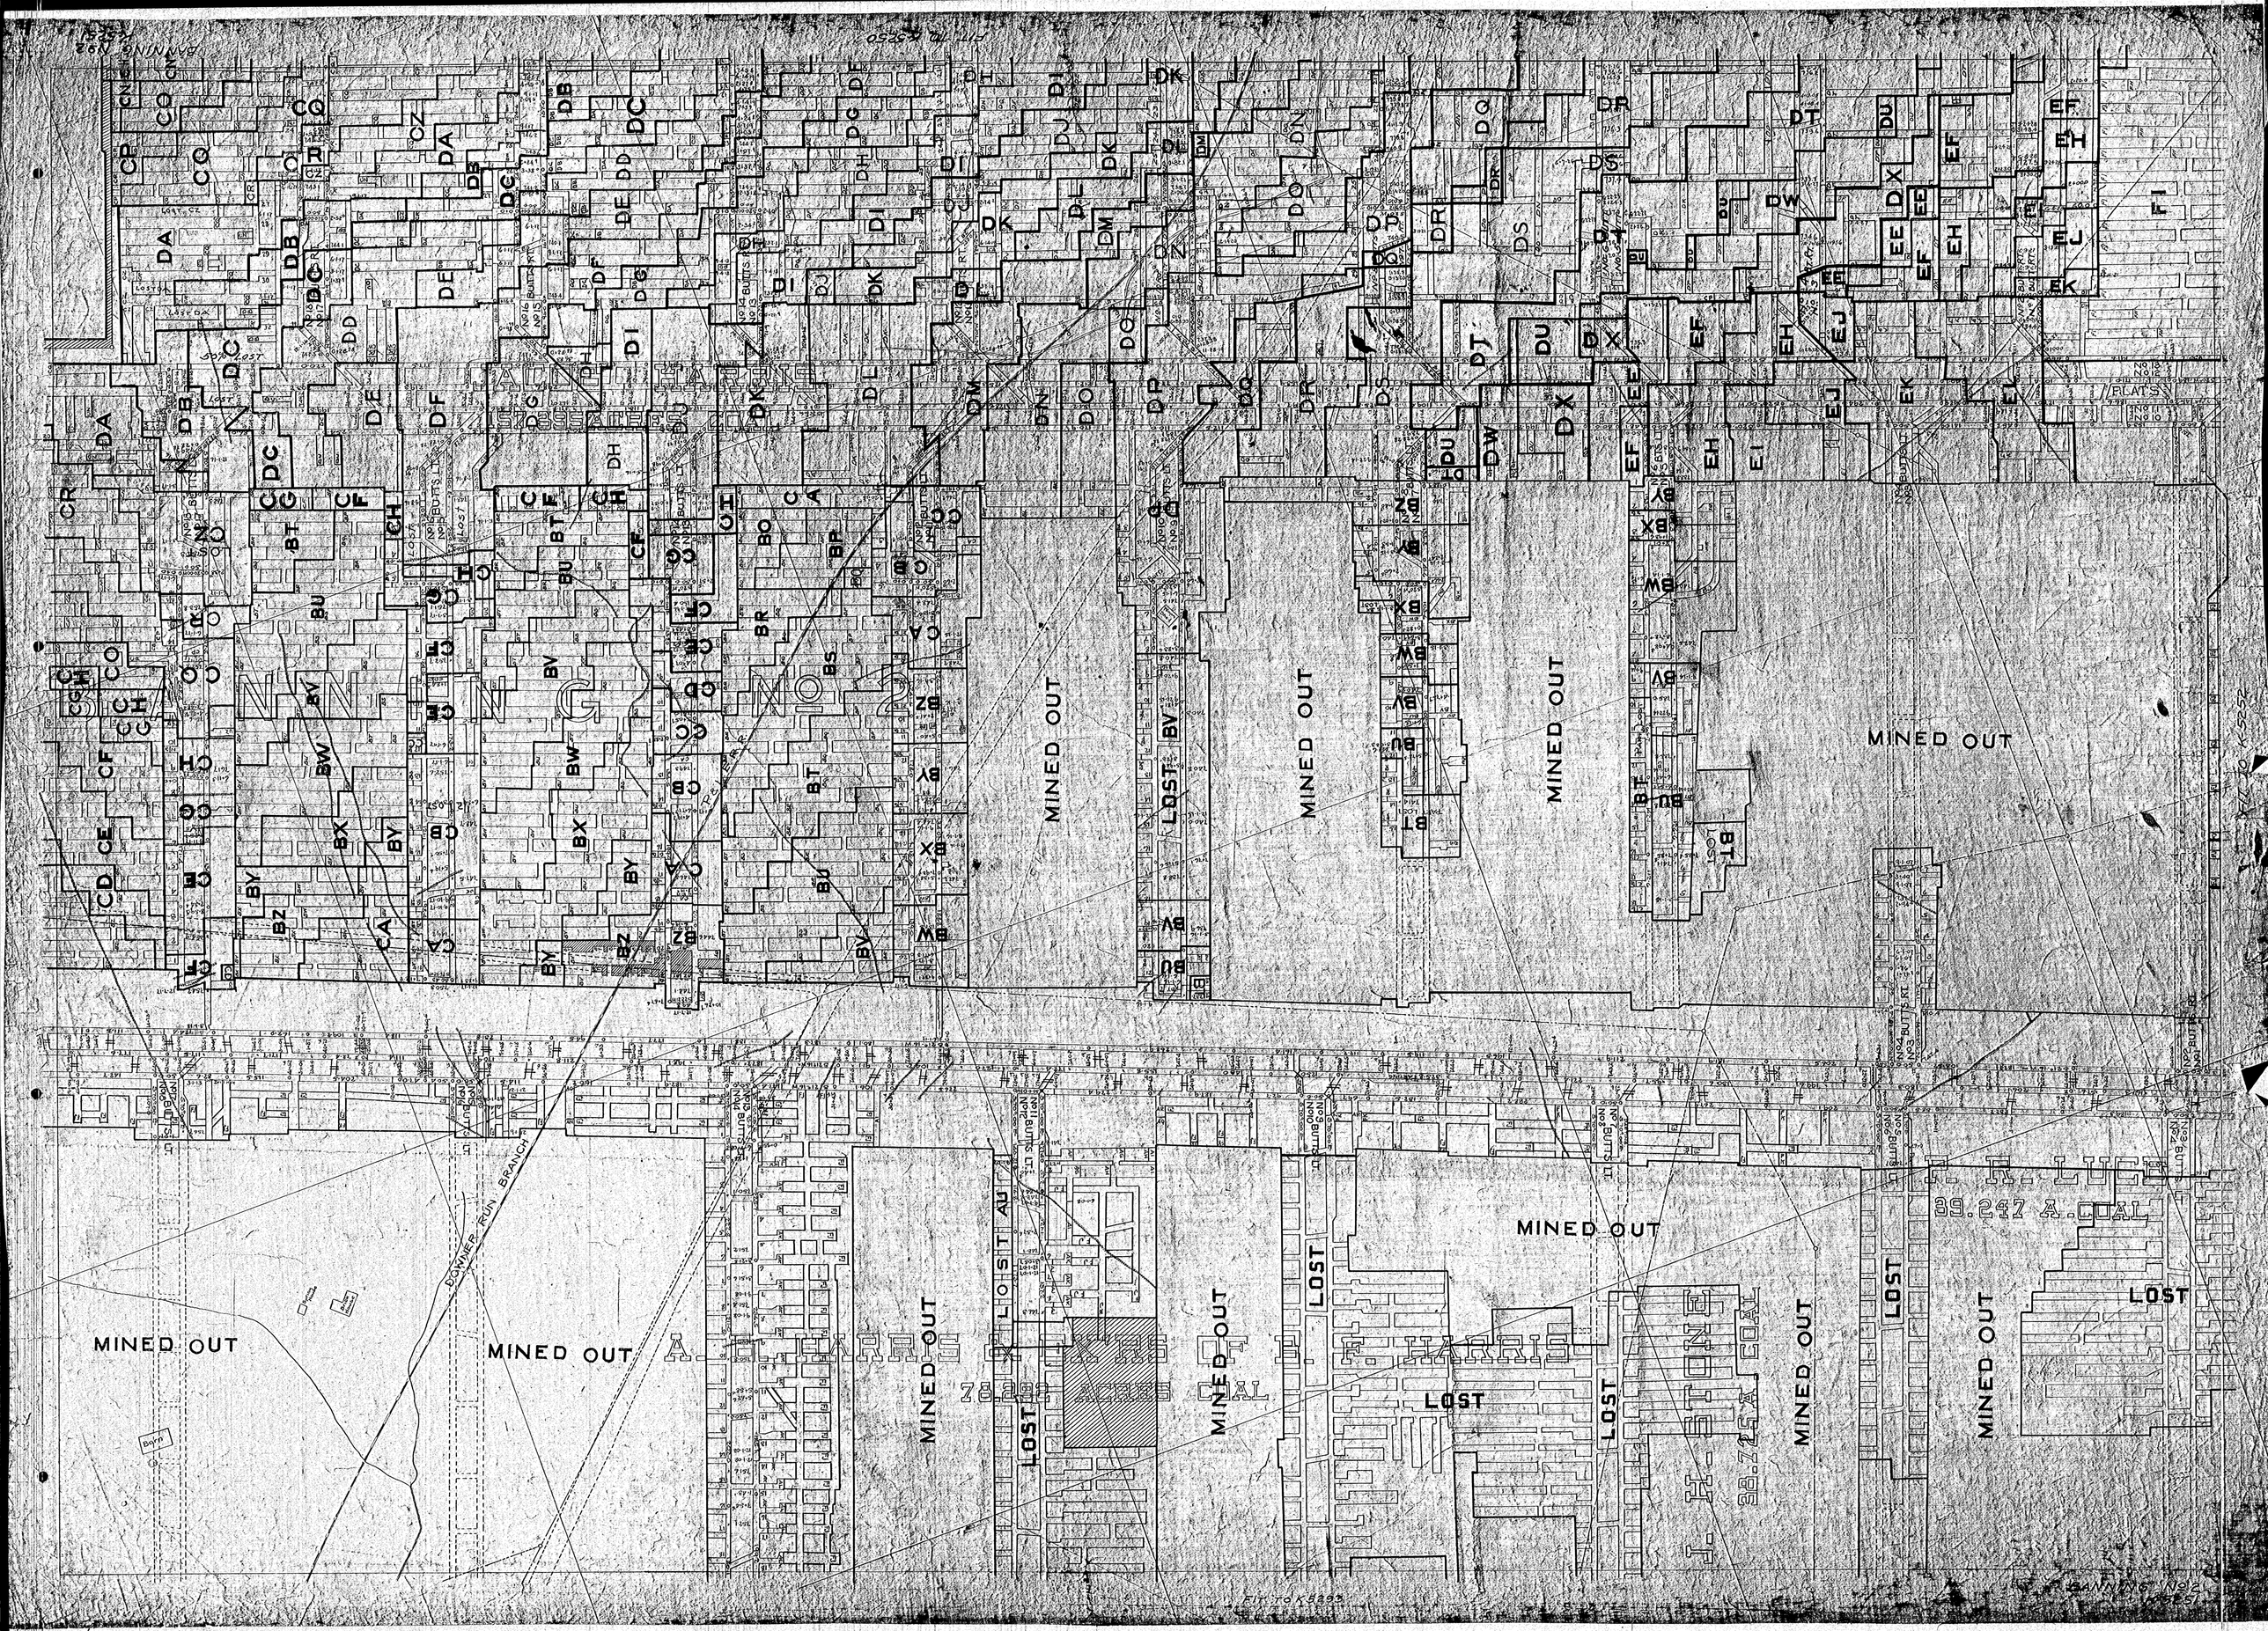

BANNING No 2
K5251
FIT TO K5250
A. C. HARRIS
157.895 ACRES COAL
BANNING No 2
50% LOST
LOST CZ
LOST DA
P&LE R.R.
FLATS
MINED OUT
LOST
PART LOST
FIT TO K-5252
DOWNER RUN BRANCH
Spring House
Brick House
Barn
A. C. HARRIS & HEIRS OF E. F. HARRIS
78.292 ACRES COAL
J. H. STONE
38.725 A. COAL
F. R. LUCE
39.247 A. COAL
FIT TO K5293
BANNING No 2
K5251