


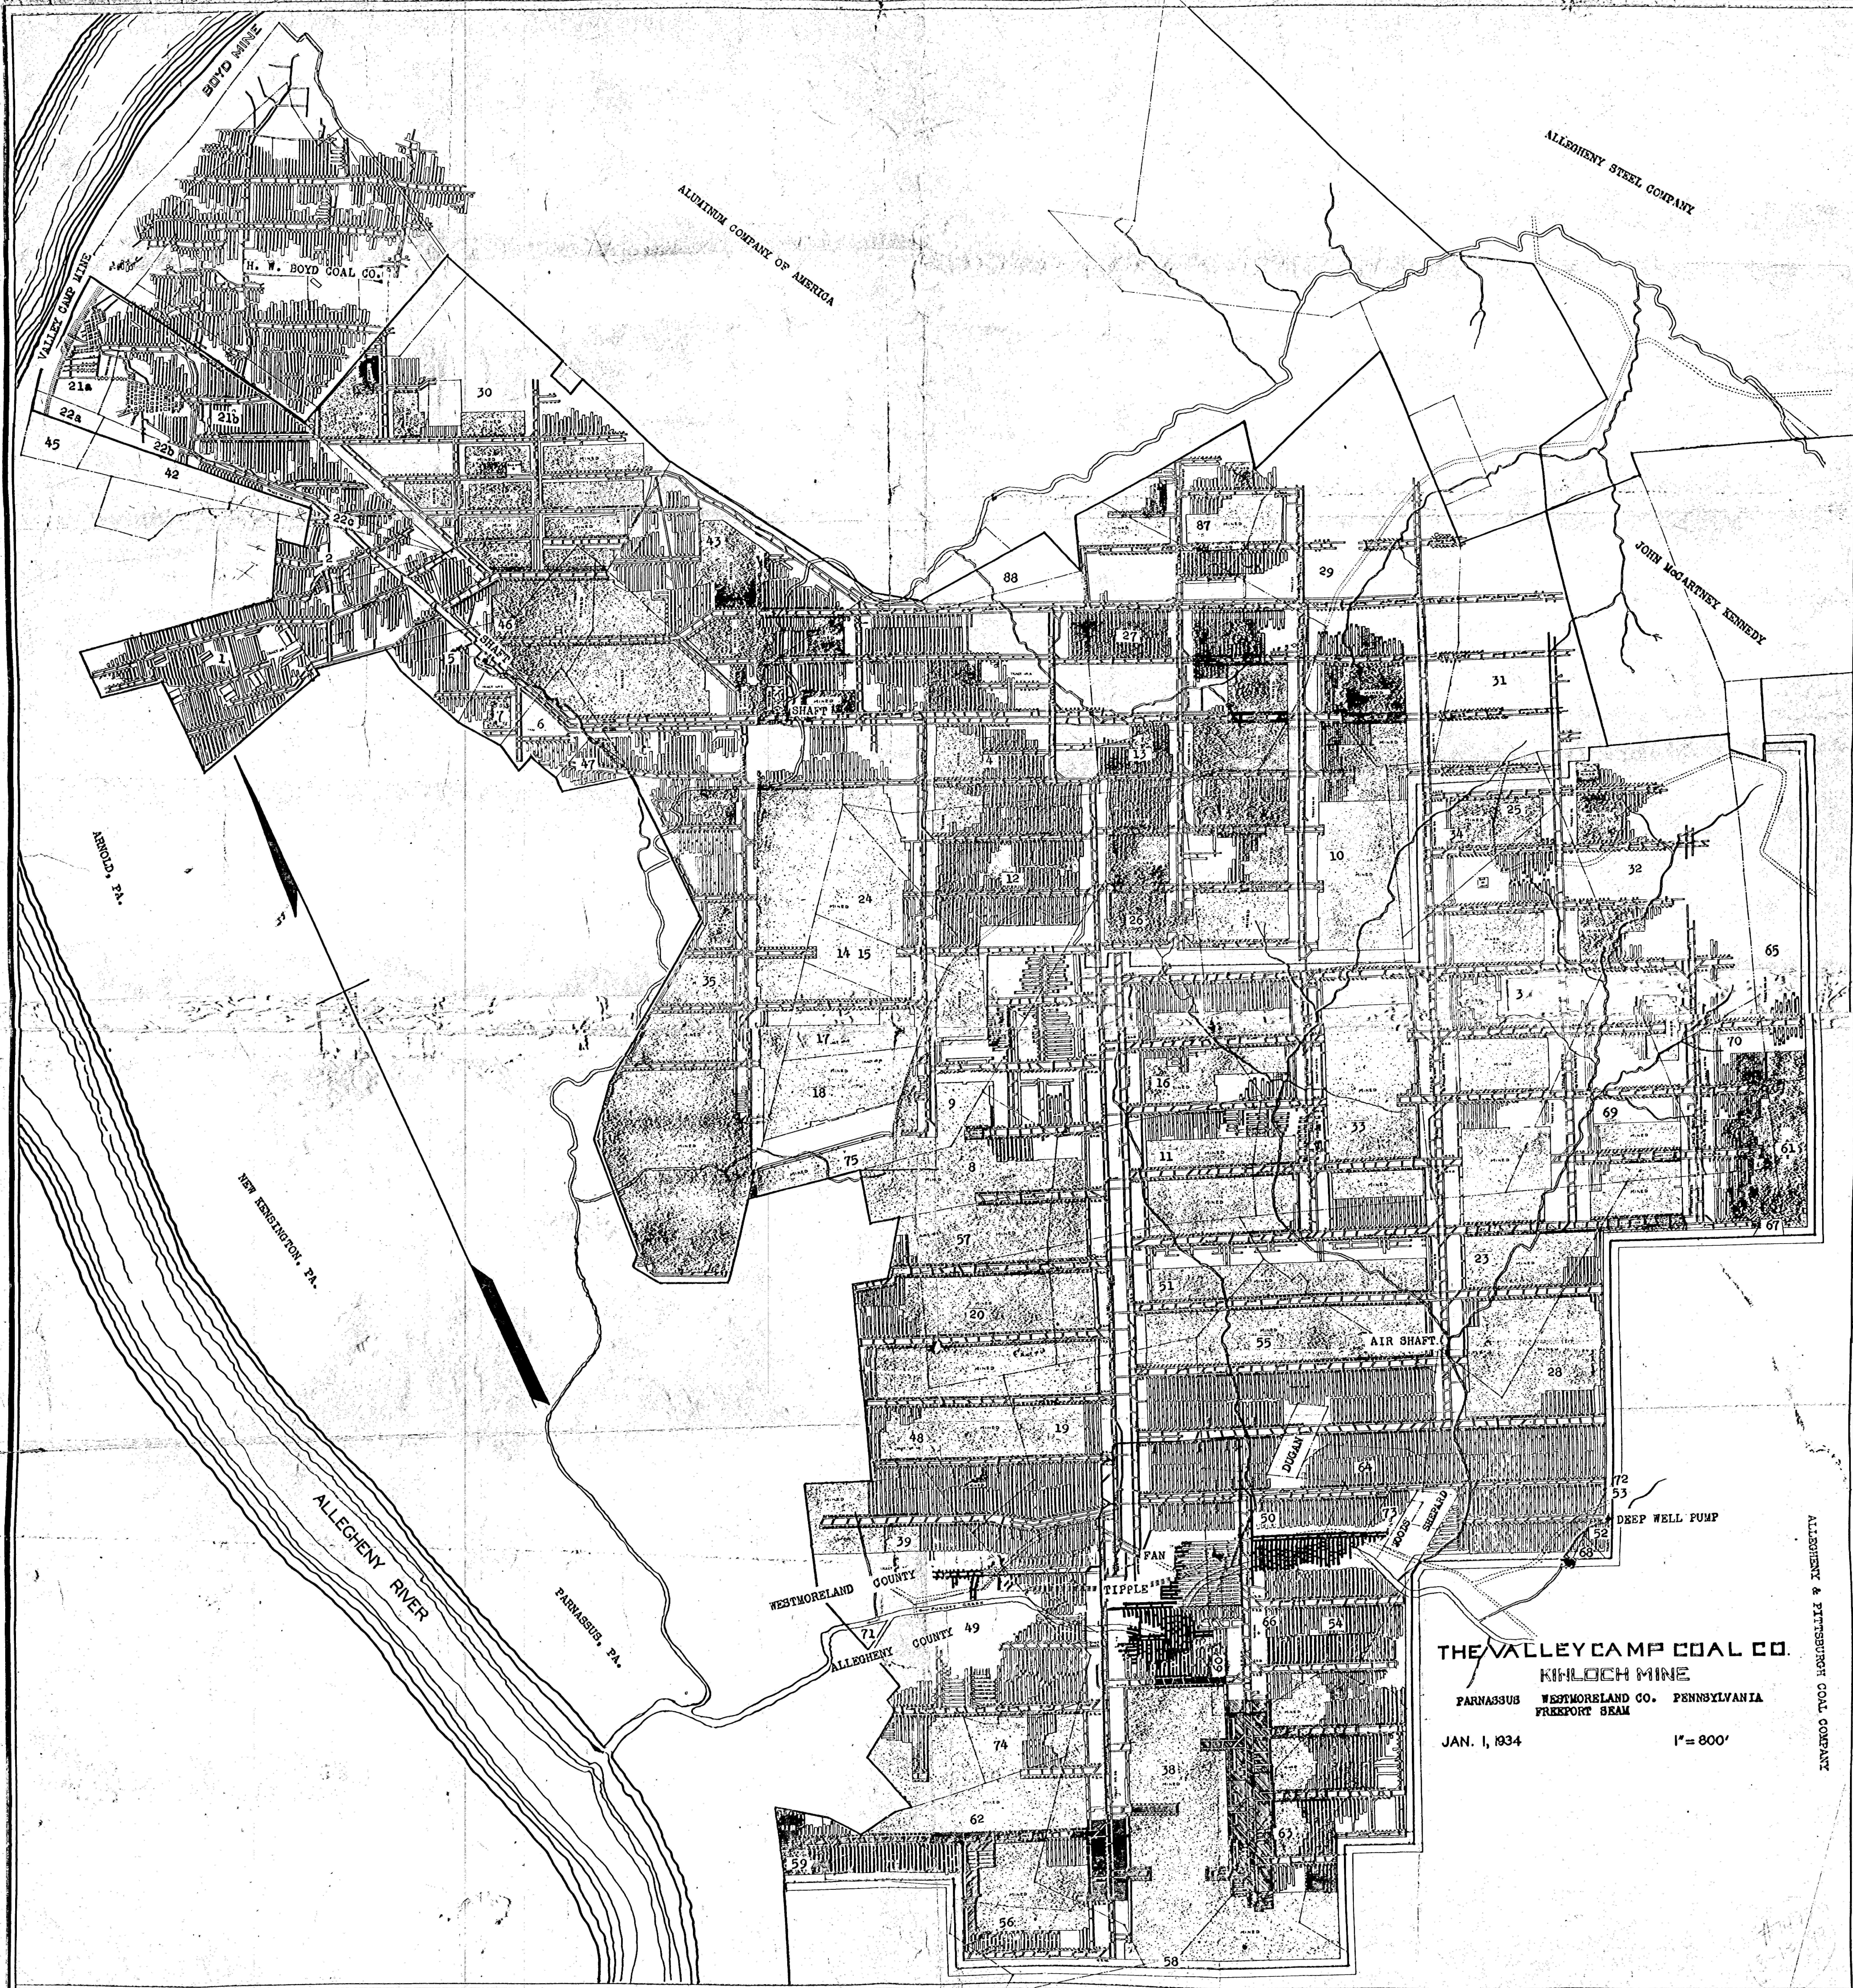

THE VALLEY CAMP COAL CO.
KINLOCH MINE
FARNASSUS WESTMORELAND CO. PENNSYLVANIA
FREEPORT BEAM
JAN. 1, 1934
1" = 800'

ALLEGHENY & PITTSBURGH COAL COMPANY