


1826.62

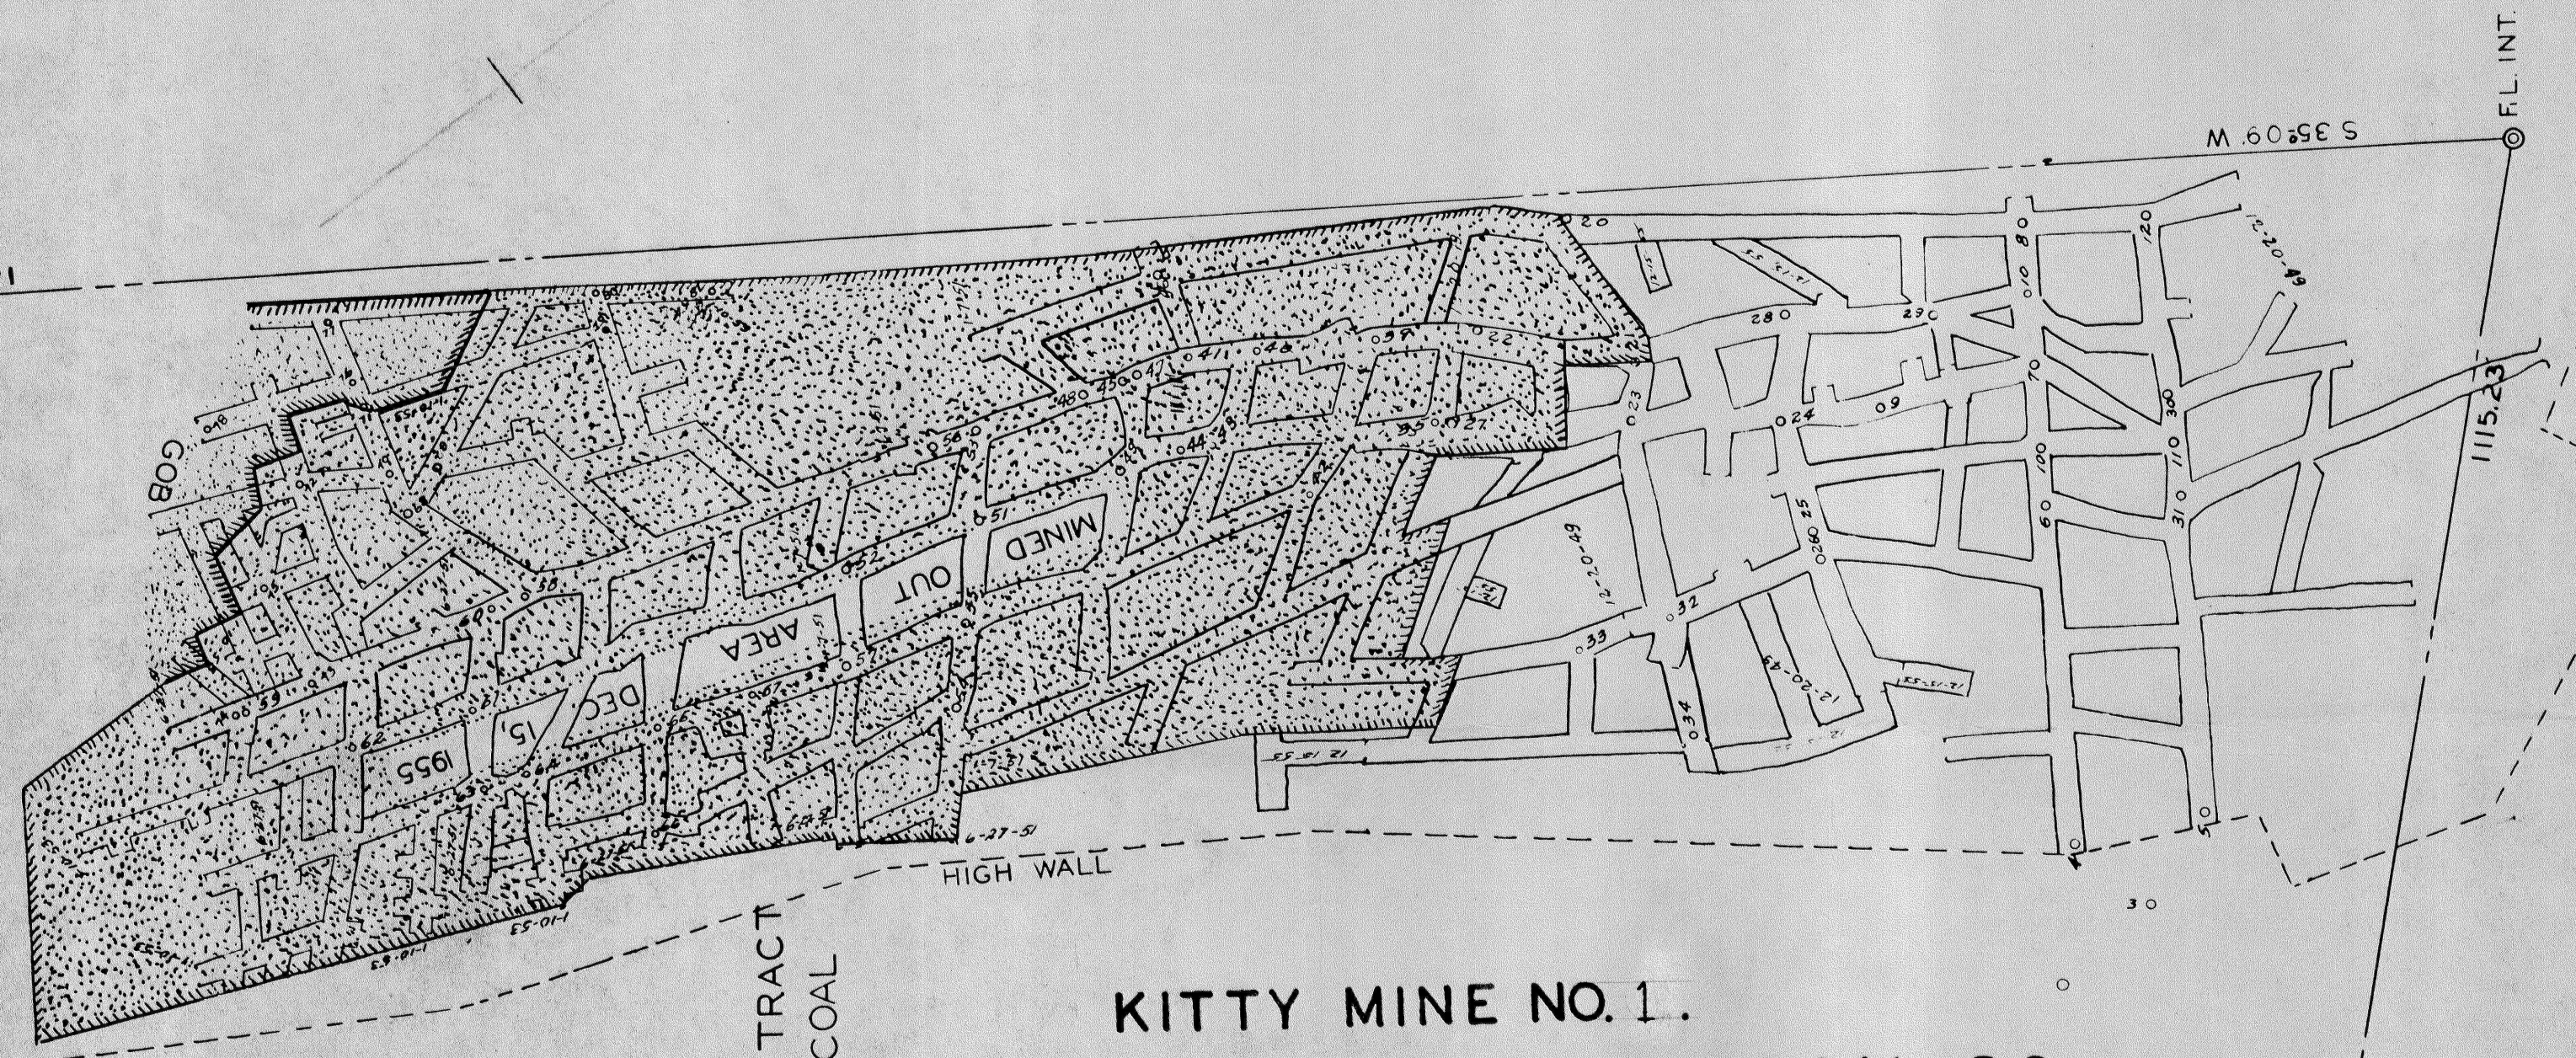

IDA L. MILLER - TRACT
27 ACRES COAL

KITTY MINE NO. 1. NICHOLSON-MARSHALL COAL CO.

DUNKARD TOWNSHIP, GREENE CO., PA.
SCALE 100' TO 1" MARCH 6, 1956

Albert A. Hood
P.S. 8572

#1495
8-13-99
C.C.

WARREN ROSS - TRACT