


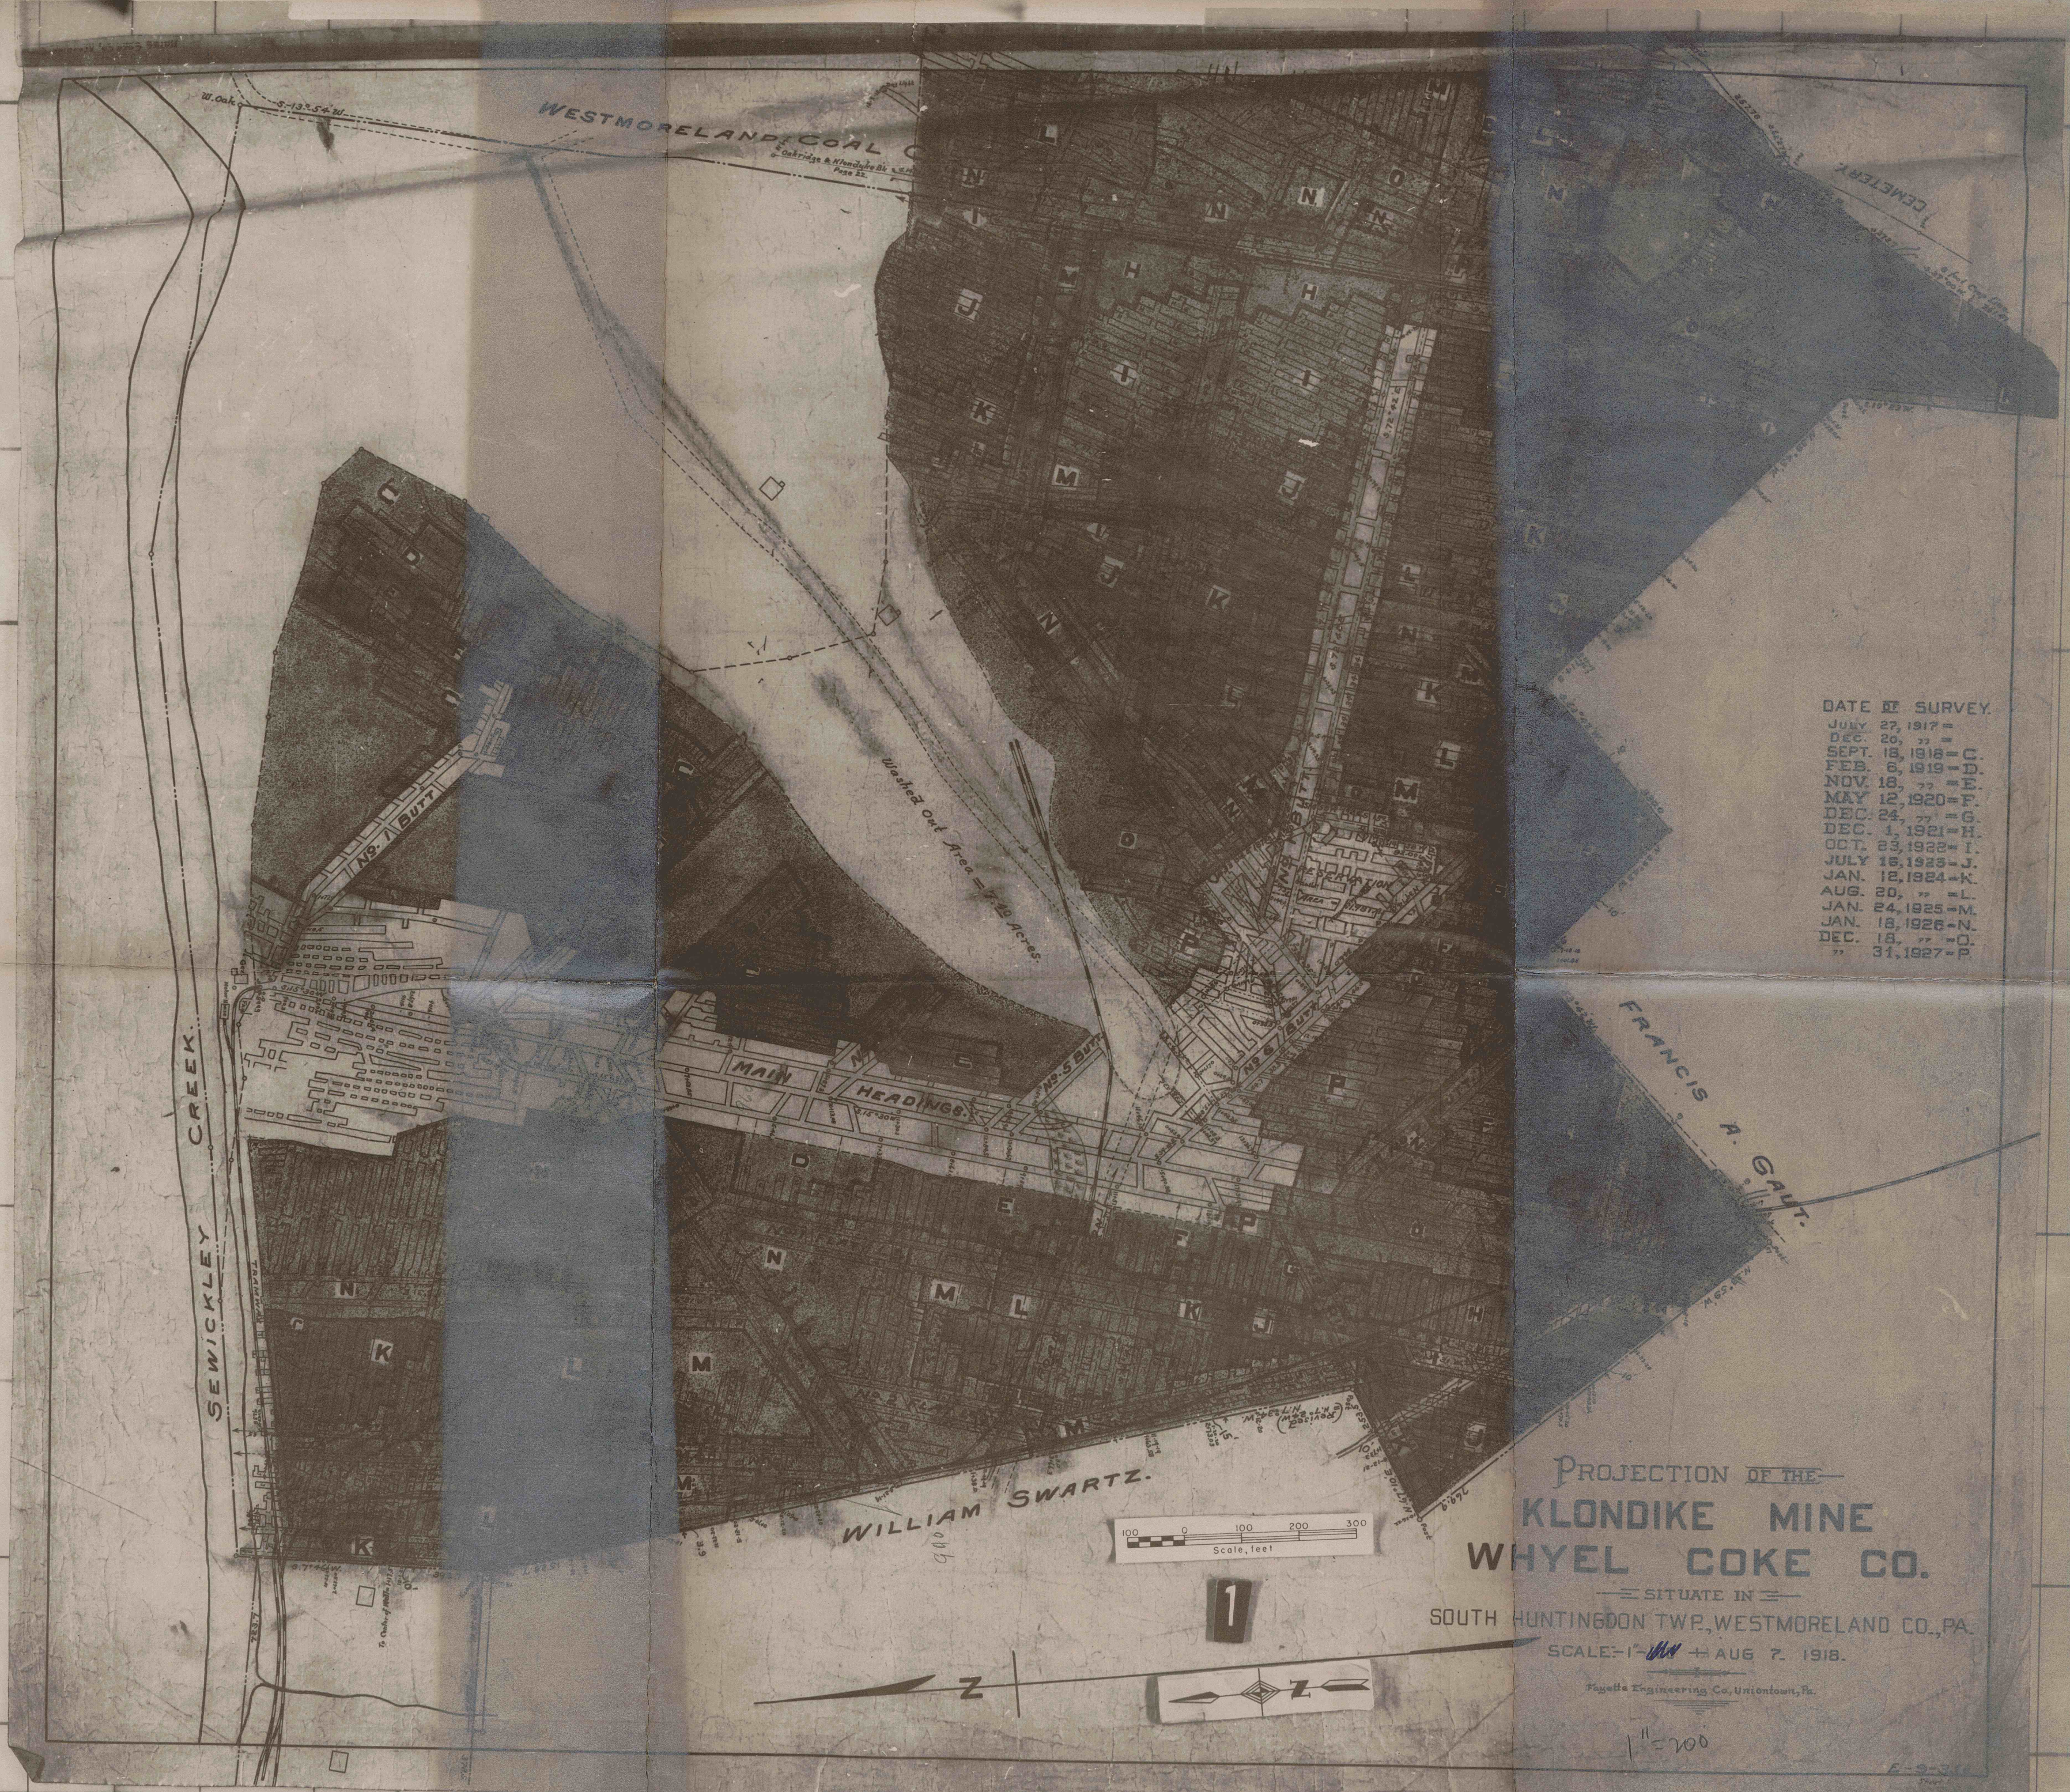

DATE OF SURVEY.

JULY 27, 1917 =
DEC. 20, " =
SEPT. 18, 1918 = C.
FEB. 6, 1919 = D.
NOV. 18, " = E.
MAY 12, 1920 = F.
DEC. 24, " = G.
DEC. 1, 1921 = H.
OCT. 23, 1922 = I.
JULY 15, 1923 = J.
JAN. 12, 1924 = K.
AUG. 20, " = L.
JAN. 24, 1925 = M.
JAN. 18, 1926 = N.
DEC. 19, " = O.
" 31, 1927 = P.

PROJECTION OF THE
KLONDIKE MINE
WHYEL COKE CO.

SITUATE IN
SOUTH HUNTINGDON TWP., WESTMORELAND CO., PA.
SCALE = 1" = 200' AUG 7, 1918.

Fayette Engineering Co., Uniontown, Pa.

1" = 200'

03116 364 28X 343735

1" = 200'

#1499
8-13-99
cc