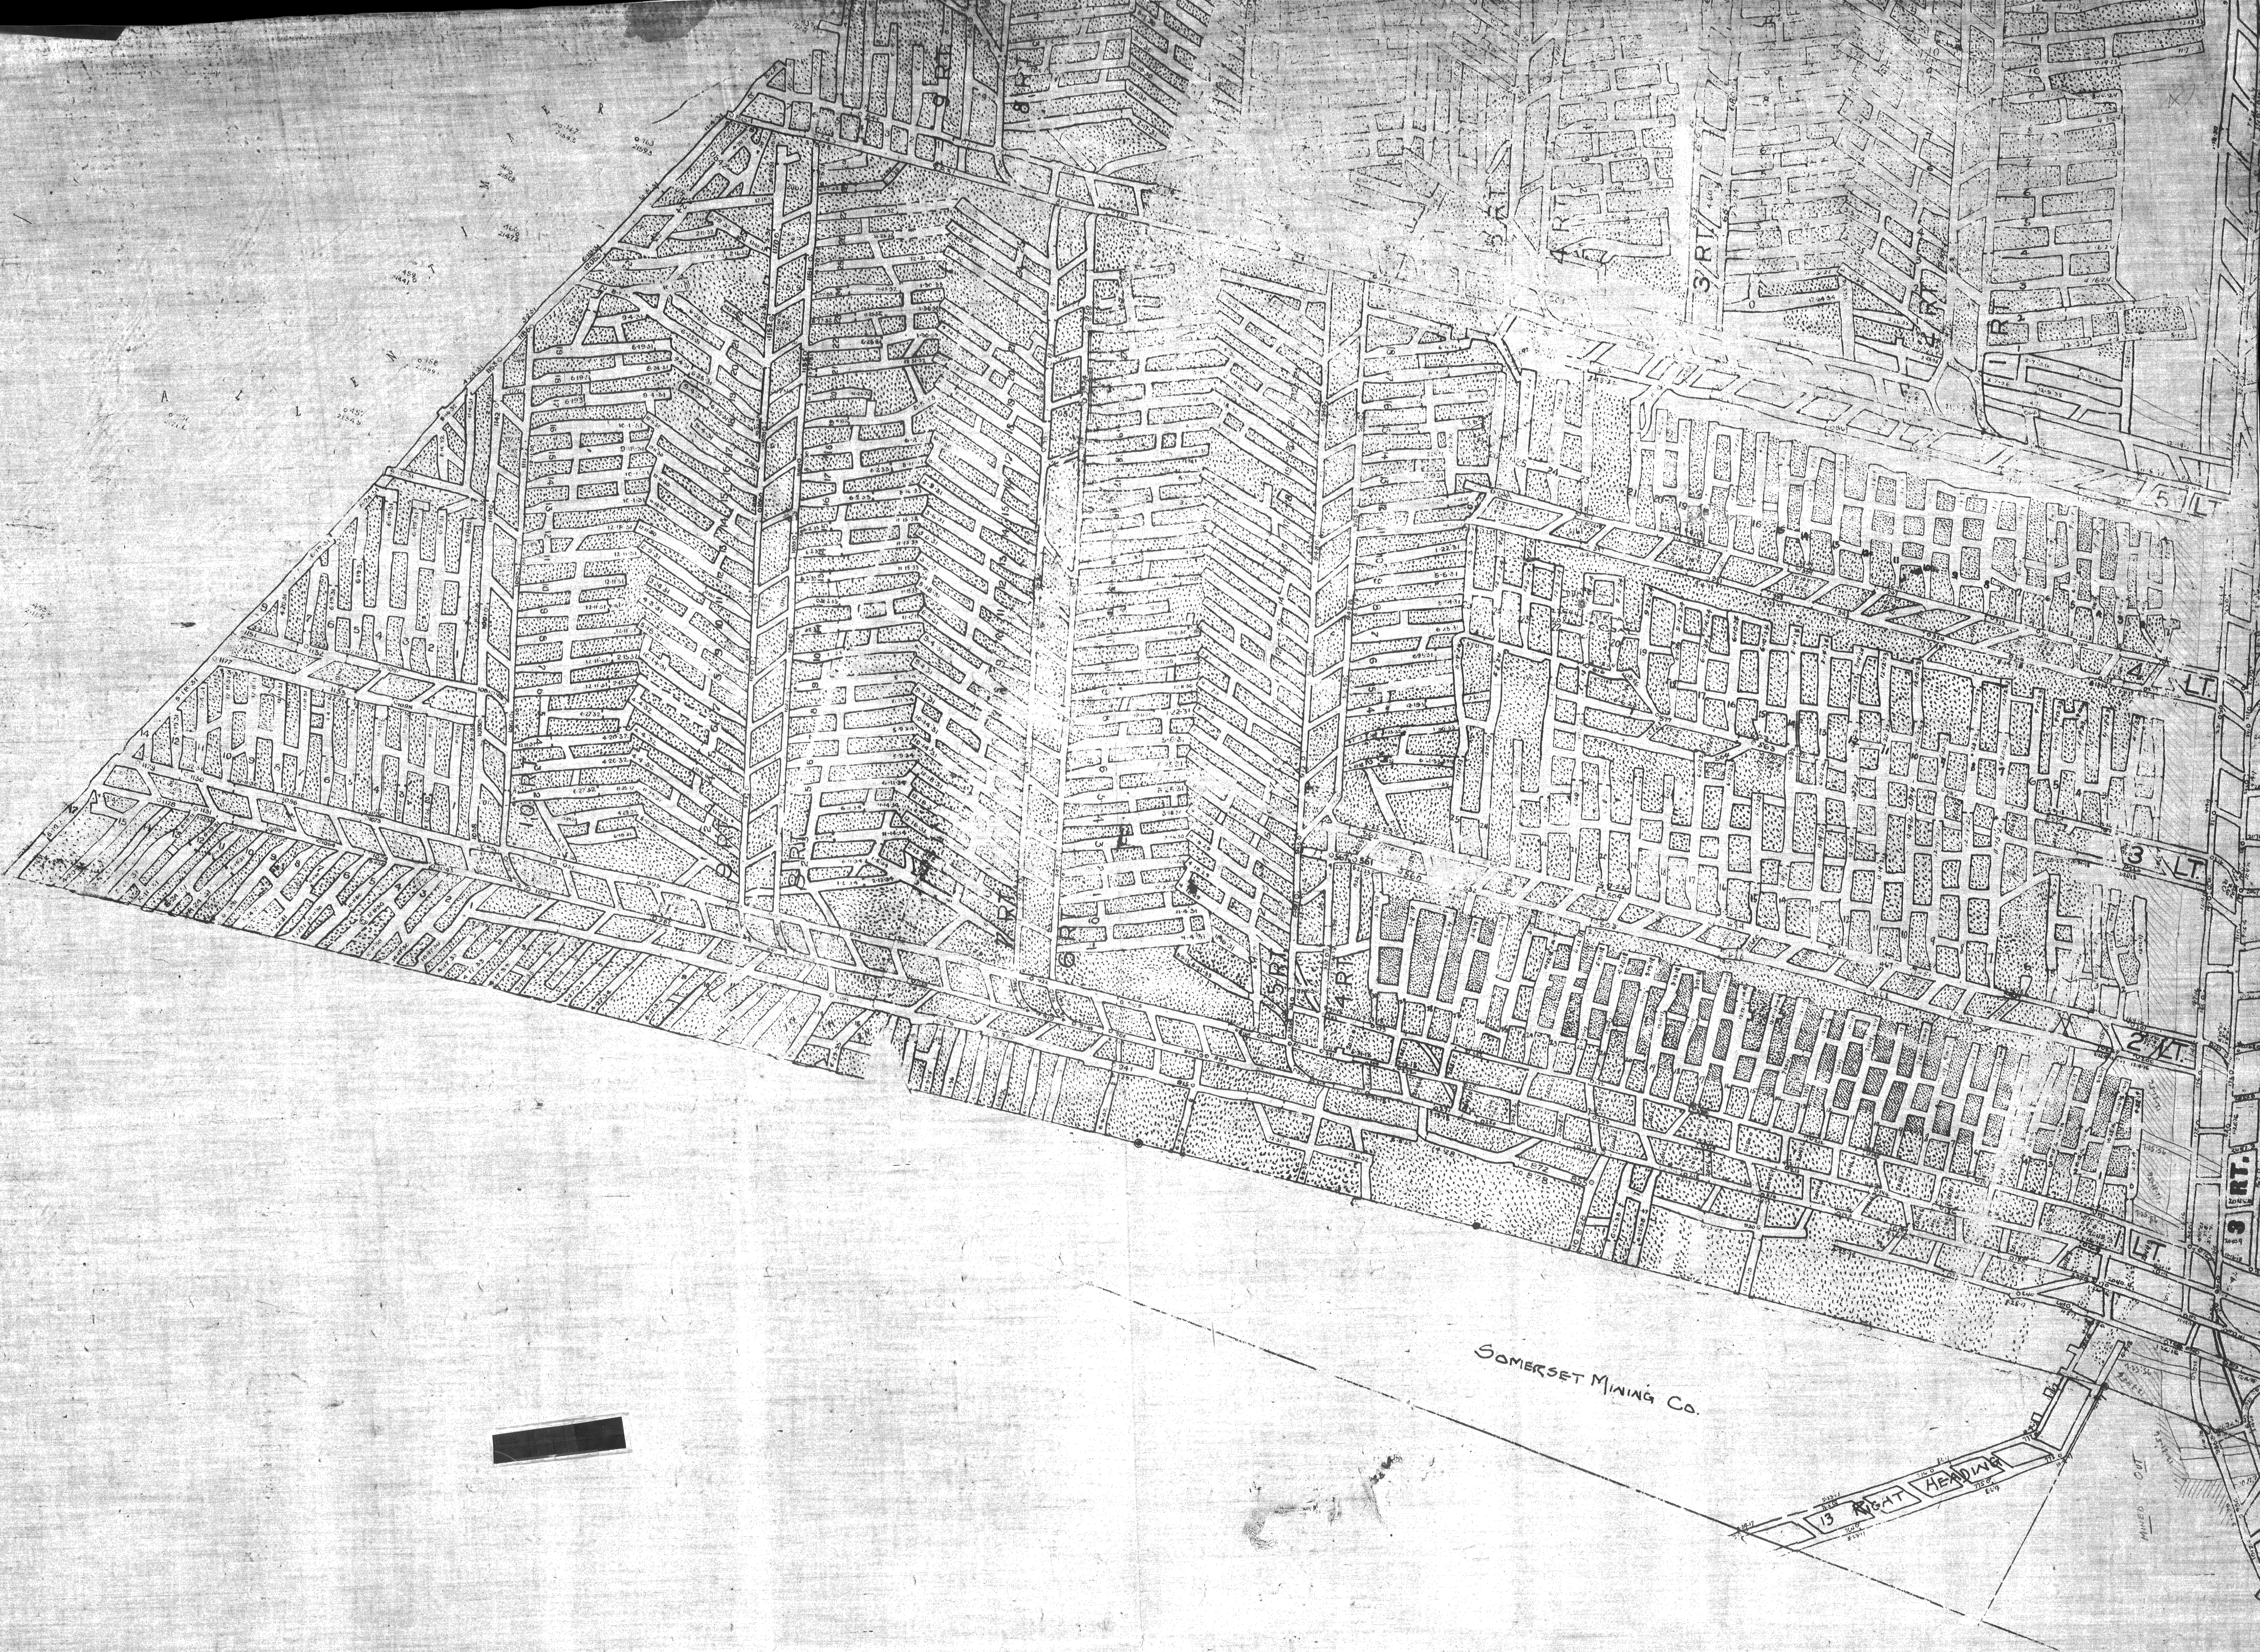
5 LT.
4 LT.
3 LT.
2 LT.
LT.
3 RT.
3 RT.
4 RT.
8 RT.
SOMERSET MINING CO.
13 RIGHT HEADING
MINED OUT

[redacted]