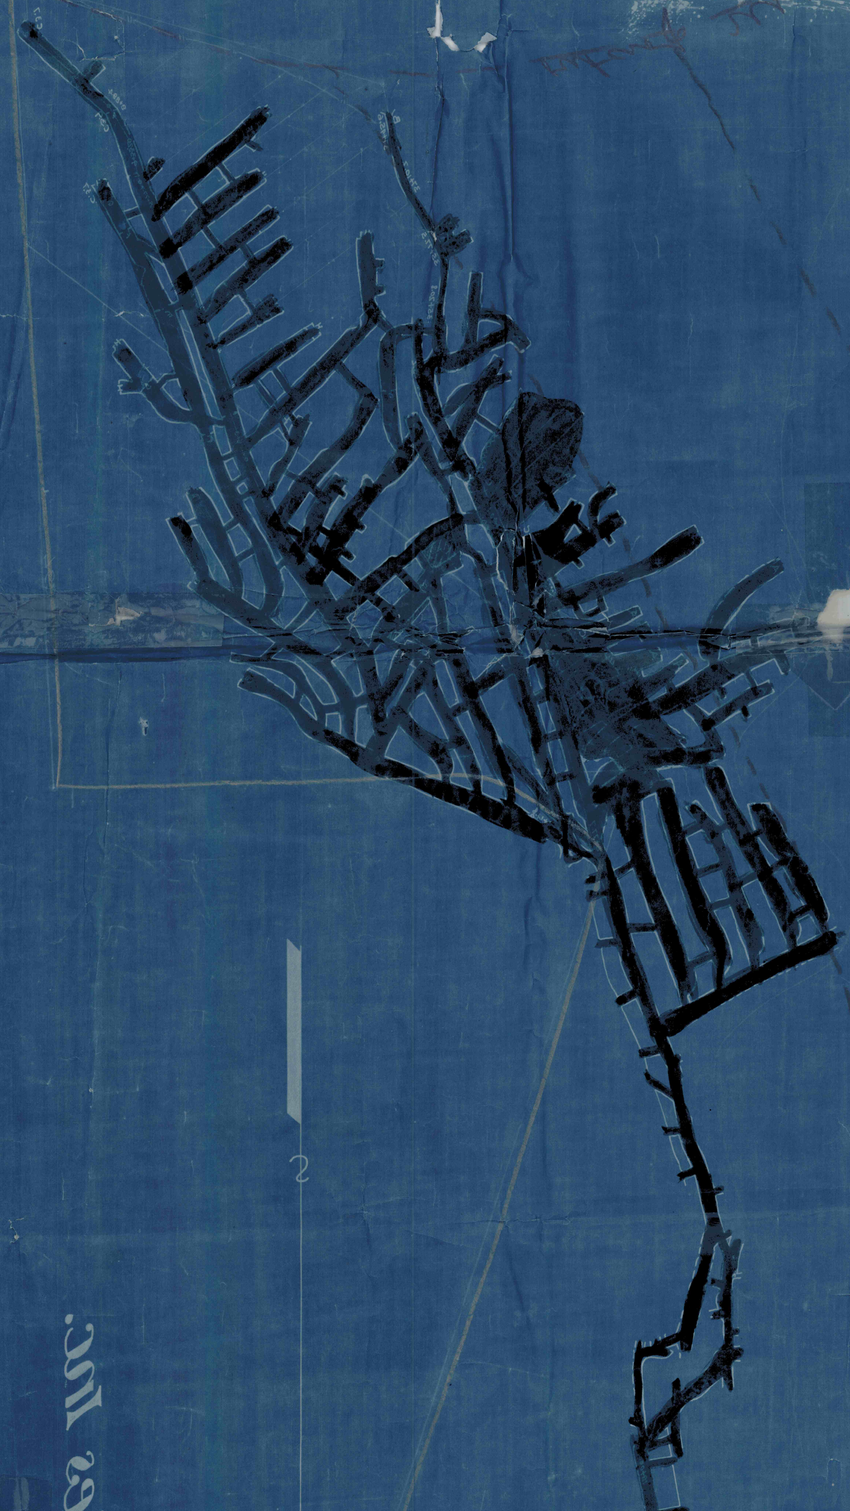

Pennsylvania Collieries Inc.
Kokomo Mine
situate in
Cresson Township, Cambria Co., Penna.
Scale 1"=100'. Aug. 1, 1917
Engineering Service Co. Inc.
Johnstown Pa. Nov. 1919
Index
① Carroll Land 110 Ac.±
② Burgoon Land 6 Ac.±
③ Michael Bradley 60 Ac.±
⑤ James and William Noon 2 Ac.±
⑥ Burgoon Land 100 Ac.±
N
S