

UNITED STATES
DEPARTMENT OF THE INTERIOR
GEOLOGICAL SURVEY

LUTHERSBURG QUADRANGLE
PENNSYLVANIA—CLEARFIELD CO.
7.5 MINUTE SERIES (TOPOGRAPHIC)
SW 1/4 PENFIELD 15' QUADRANGLE



J. I. Korb
Luthersburg, Pa.

Location of
Mine & Coal Land


Clearfield, Pa.
Dec. 1, 1966

Roy C. Kindig
Reg. Engr.

Mapped, edited, and published by the Geological Survey
Control by USGS and USC&GS
Topography from aerial photographs by photogrammetric methods
Aerial photographs taken 1958. Field check 1959.
Polyconic projection. 1927 North American datum
10,000-foot grid based on Pennsylvania coordinate system,
north zone
1000-meter Universal Transverse Mercator grid ticks,
zone 17, shown in blue
Fine red dashed lines indicate selected fence and field lines
visible on aerial photographs. This information is unchecked

**BRADY TOWNSHIP
CLEARFIELD COUNTY
PERMIT NUMBER - 228-1
"E" - OR UPPER FREEPORT SEAM**

APPROXIMATE MEAN
DECLINATION, 1959

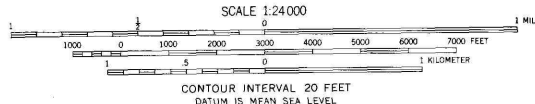

THIS MAP COMPLIES WITH NATIONAL MAP ACCURACY STANDARDS
FOR SALE BY U.S. GEOLOGICAL SURVEY, WASHINGTON 25, D. C.
A FOLDER DESCRIBING TOPOGRAPHIC MAPS AND SYMBOLS IS AVAILABLE ON REQUEST

ROAD CLASSIFICATION
Heavy-duty ——— Light-duty ———
Medium-duty ——— Unimproved dirt ———
U. S. Route ——— State Route ———

LUTHERSBURG, PA.
SW 1/4 PENFIELD 15' QUADRANGLE
N4100—W7837.5/7.5

1959