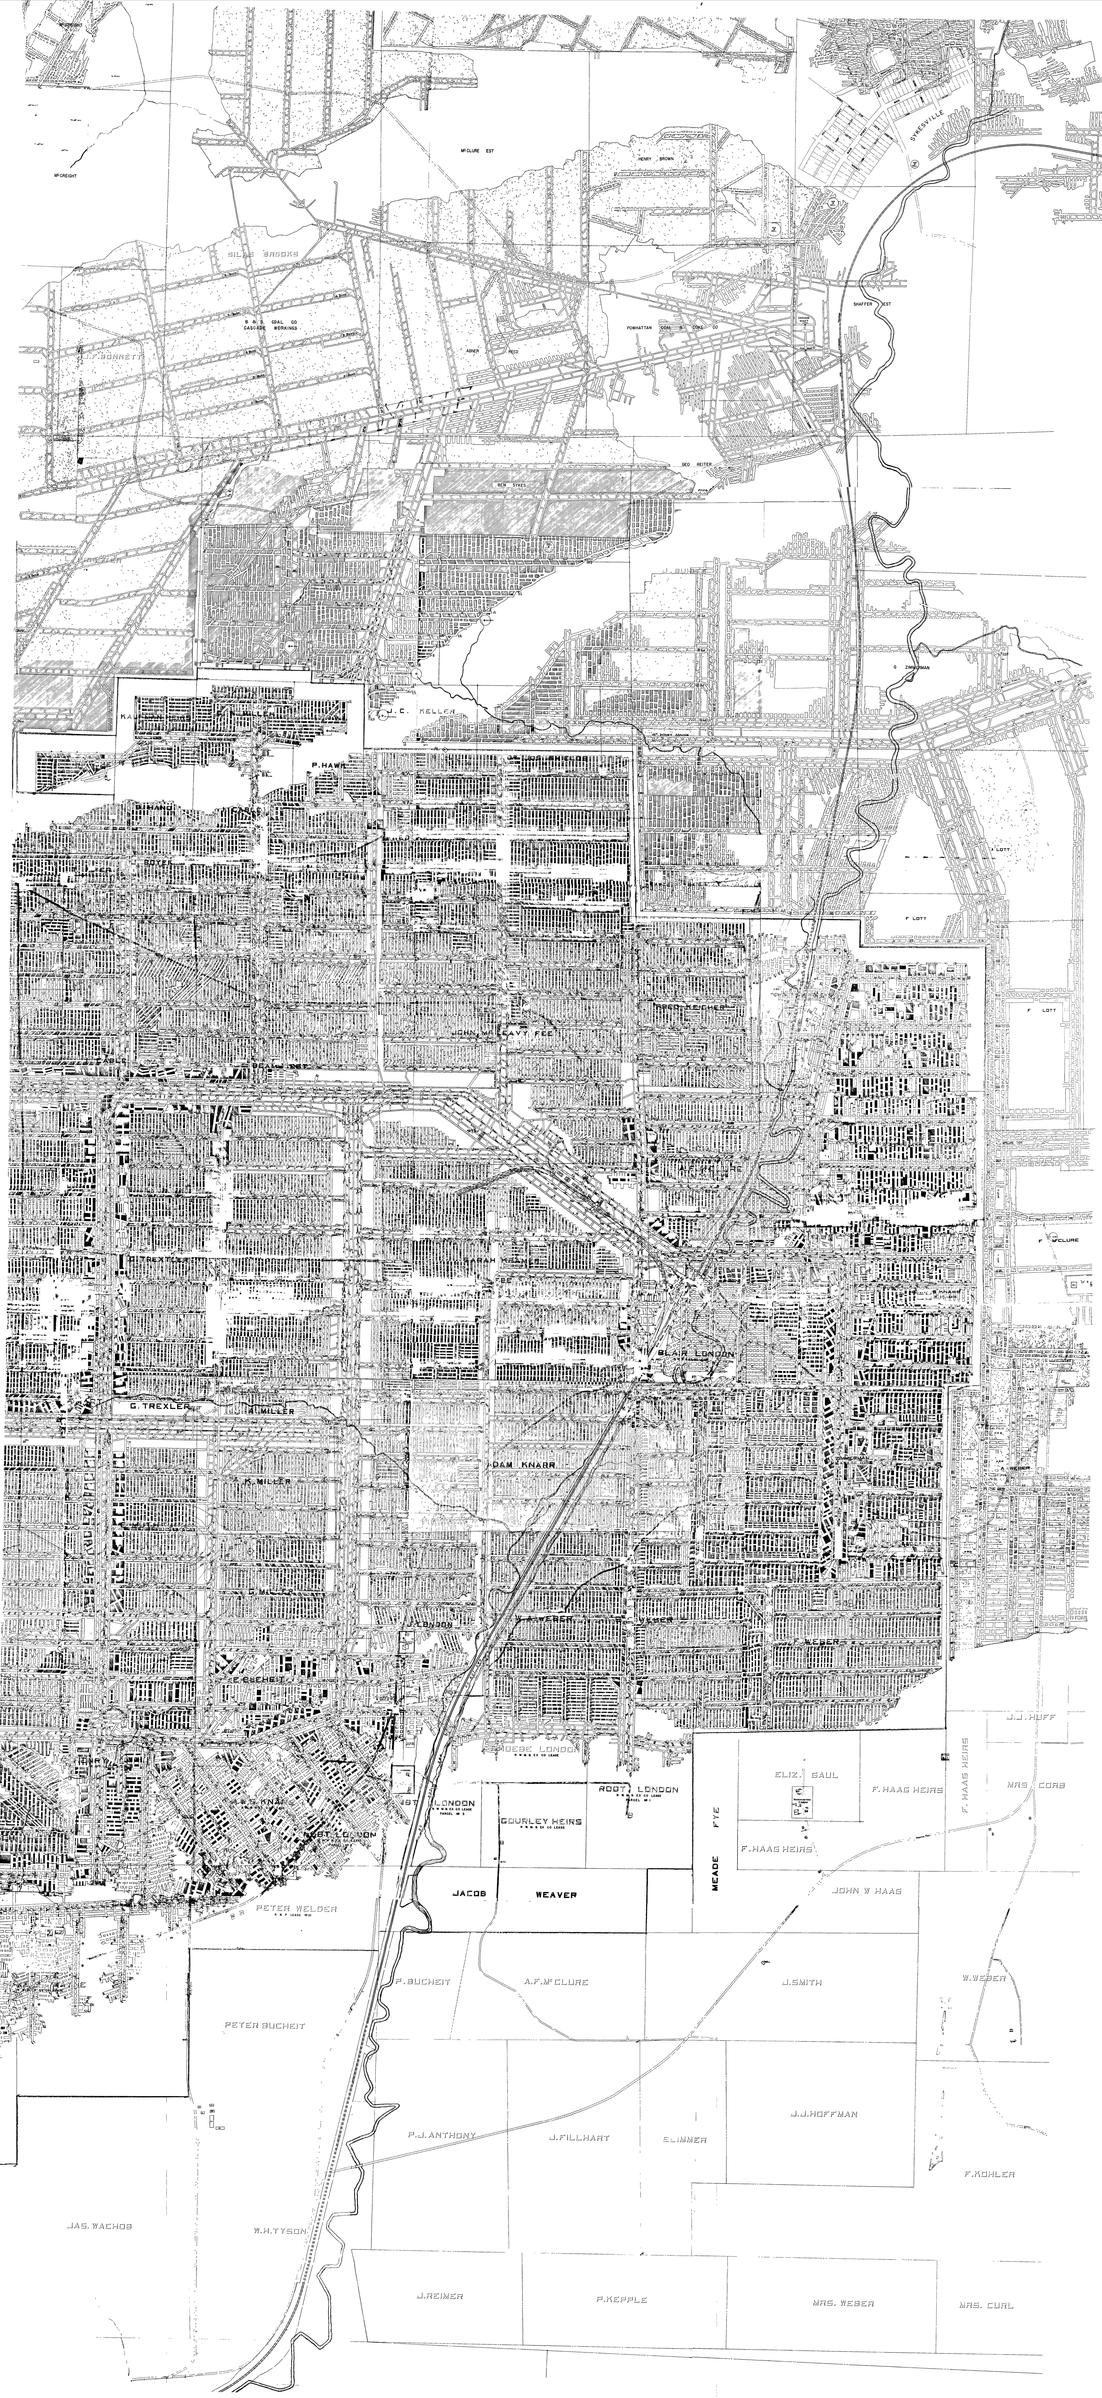

COAL LANDS-KRAHER, JEFFERSON CO., PA.

PROPERTY OF

NORTHWESTERN MINING & EXCHANGE CO.

Scale 1 inch = 400 feet.

POSTED TO MAY 15 1929 Completion of Mining