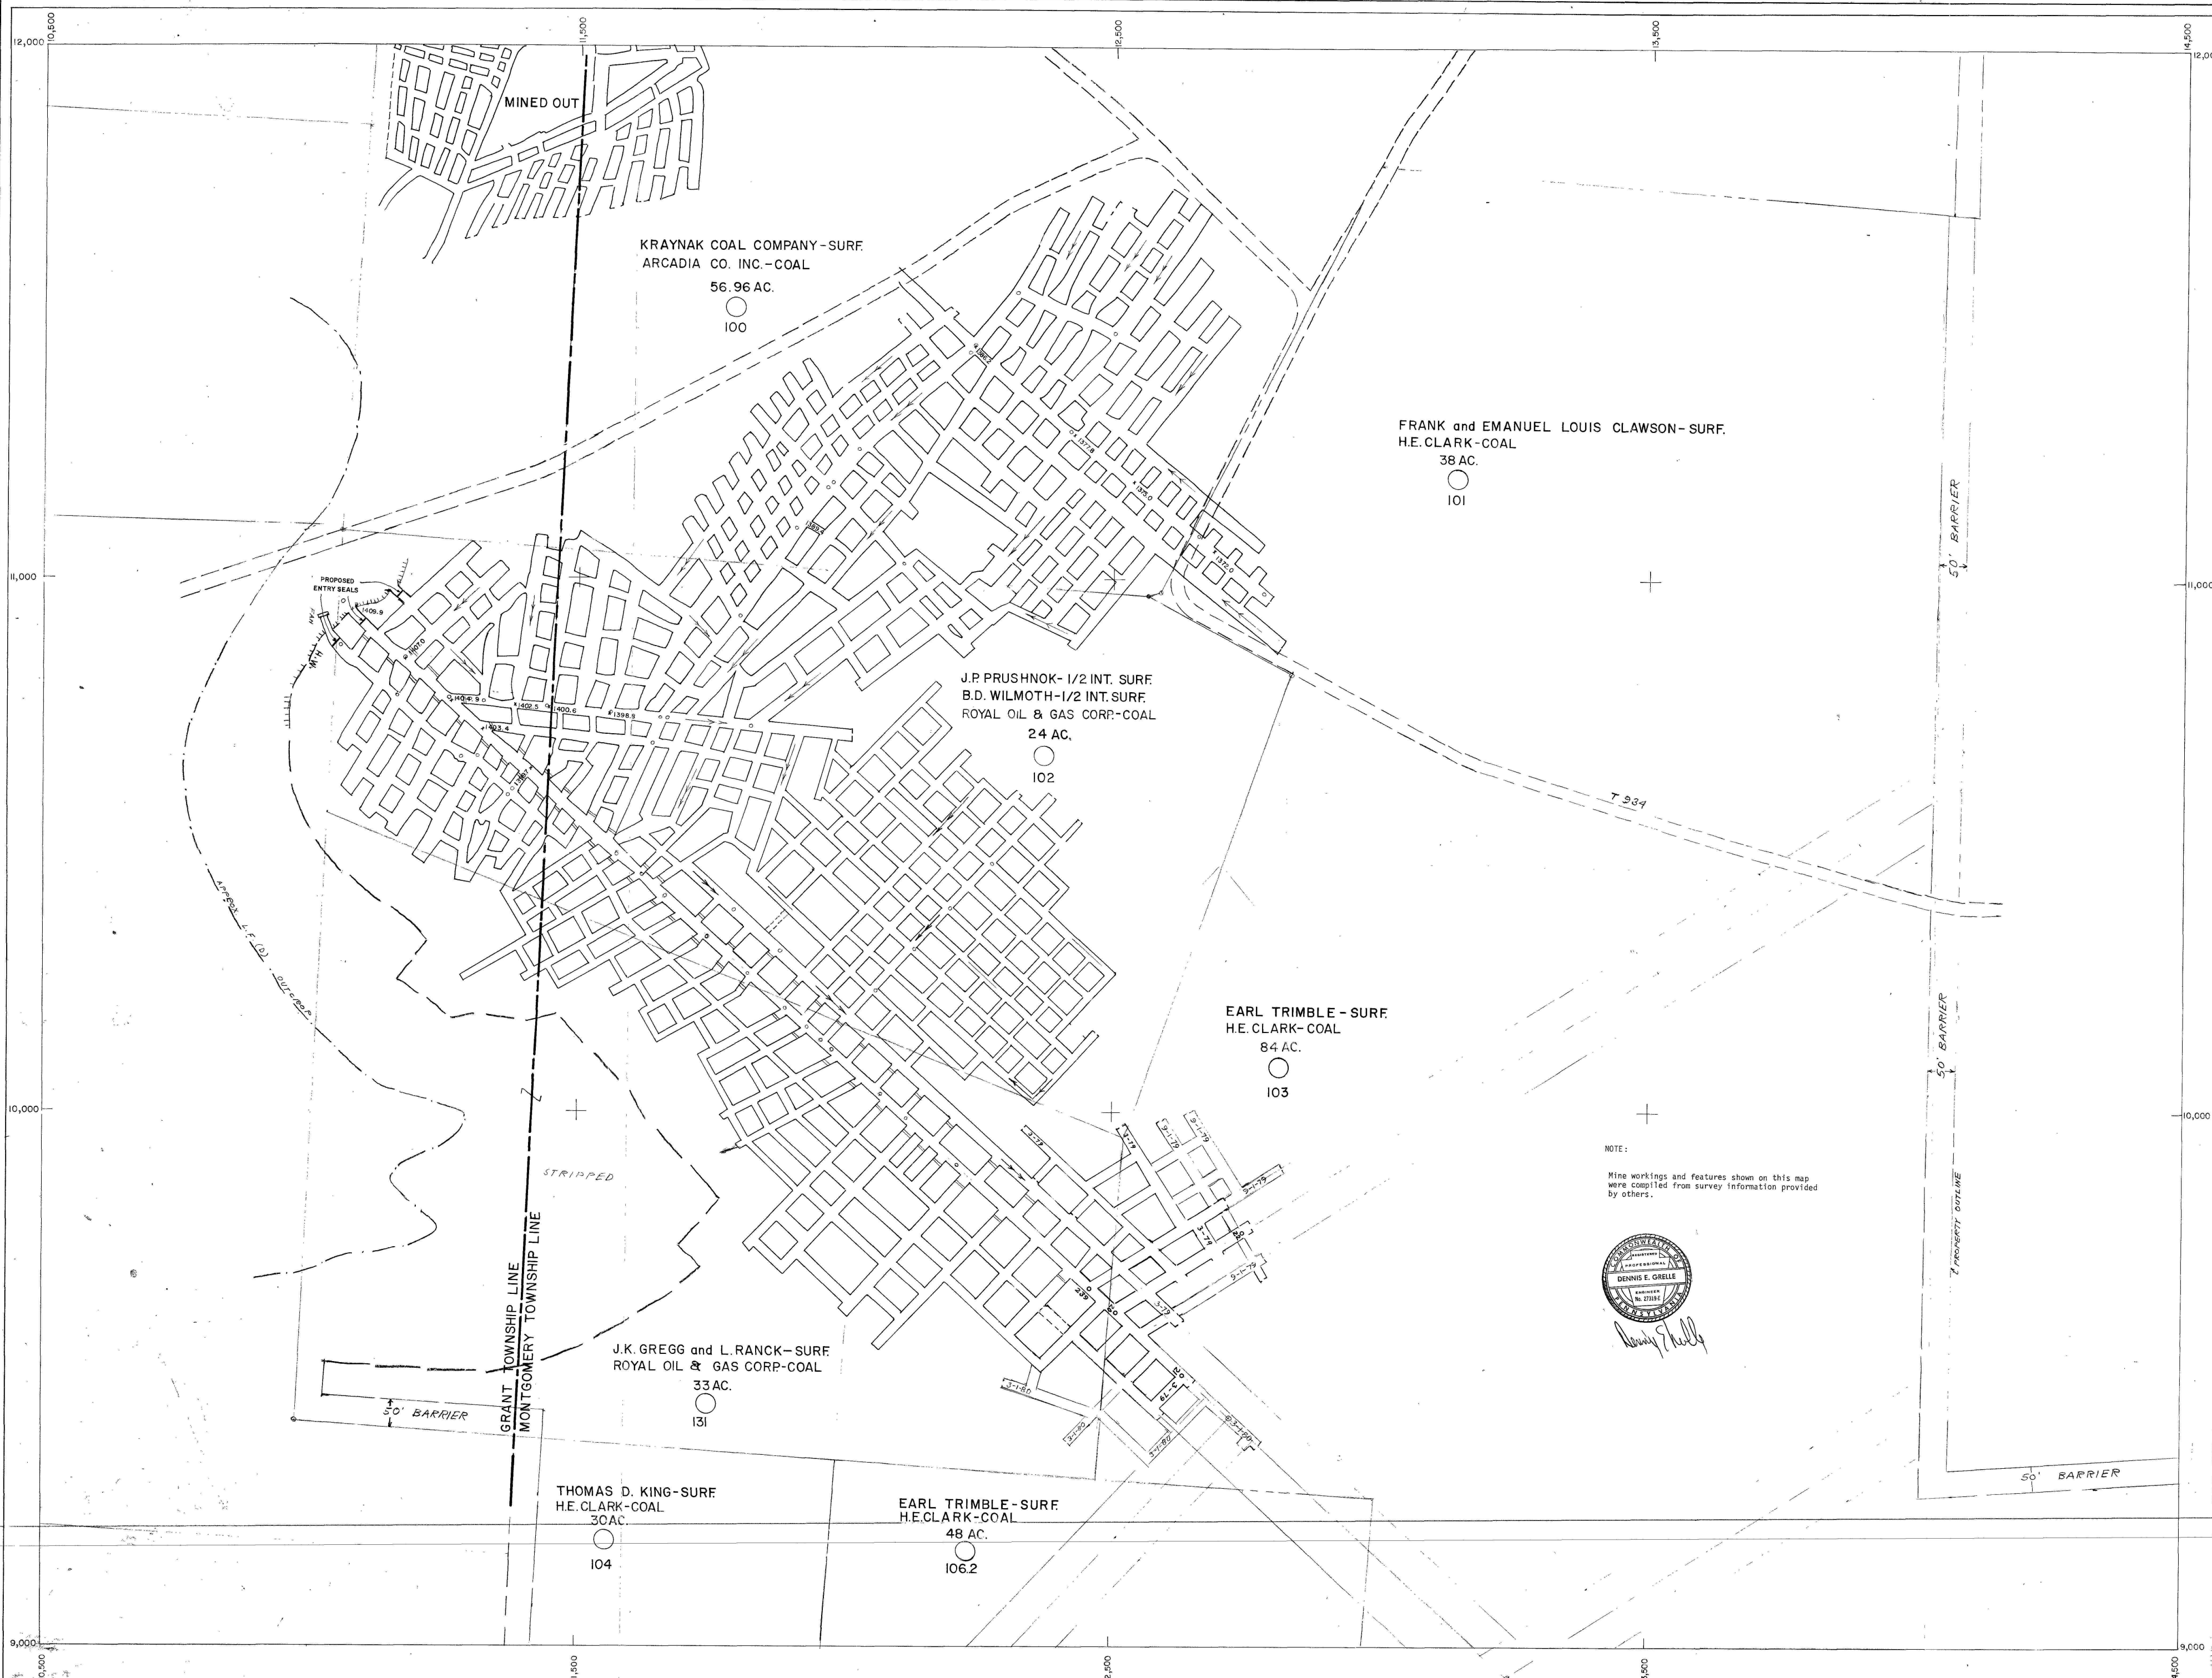


Contemplated mining area 3-1-80 thru future

Mine is currently inactive. When activated the appropriate officials shall be notified.

KRAYNAK COAL COMPANY
KRAYNAK NO.3 DEEP MINE

GRANT and MONTGOMERY TWP, INDIANA CO., PENNA.

SCALE: 1"= 100' DATE: 7-31-87

"D" Seam - Lower Freeport

FINAL MINE MAP

REV'D 8-3-88
W.M. GALE