


271

COLLIER-WYNN

282

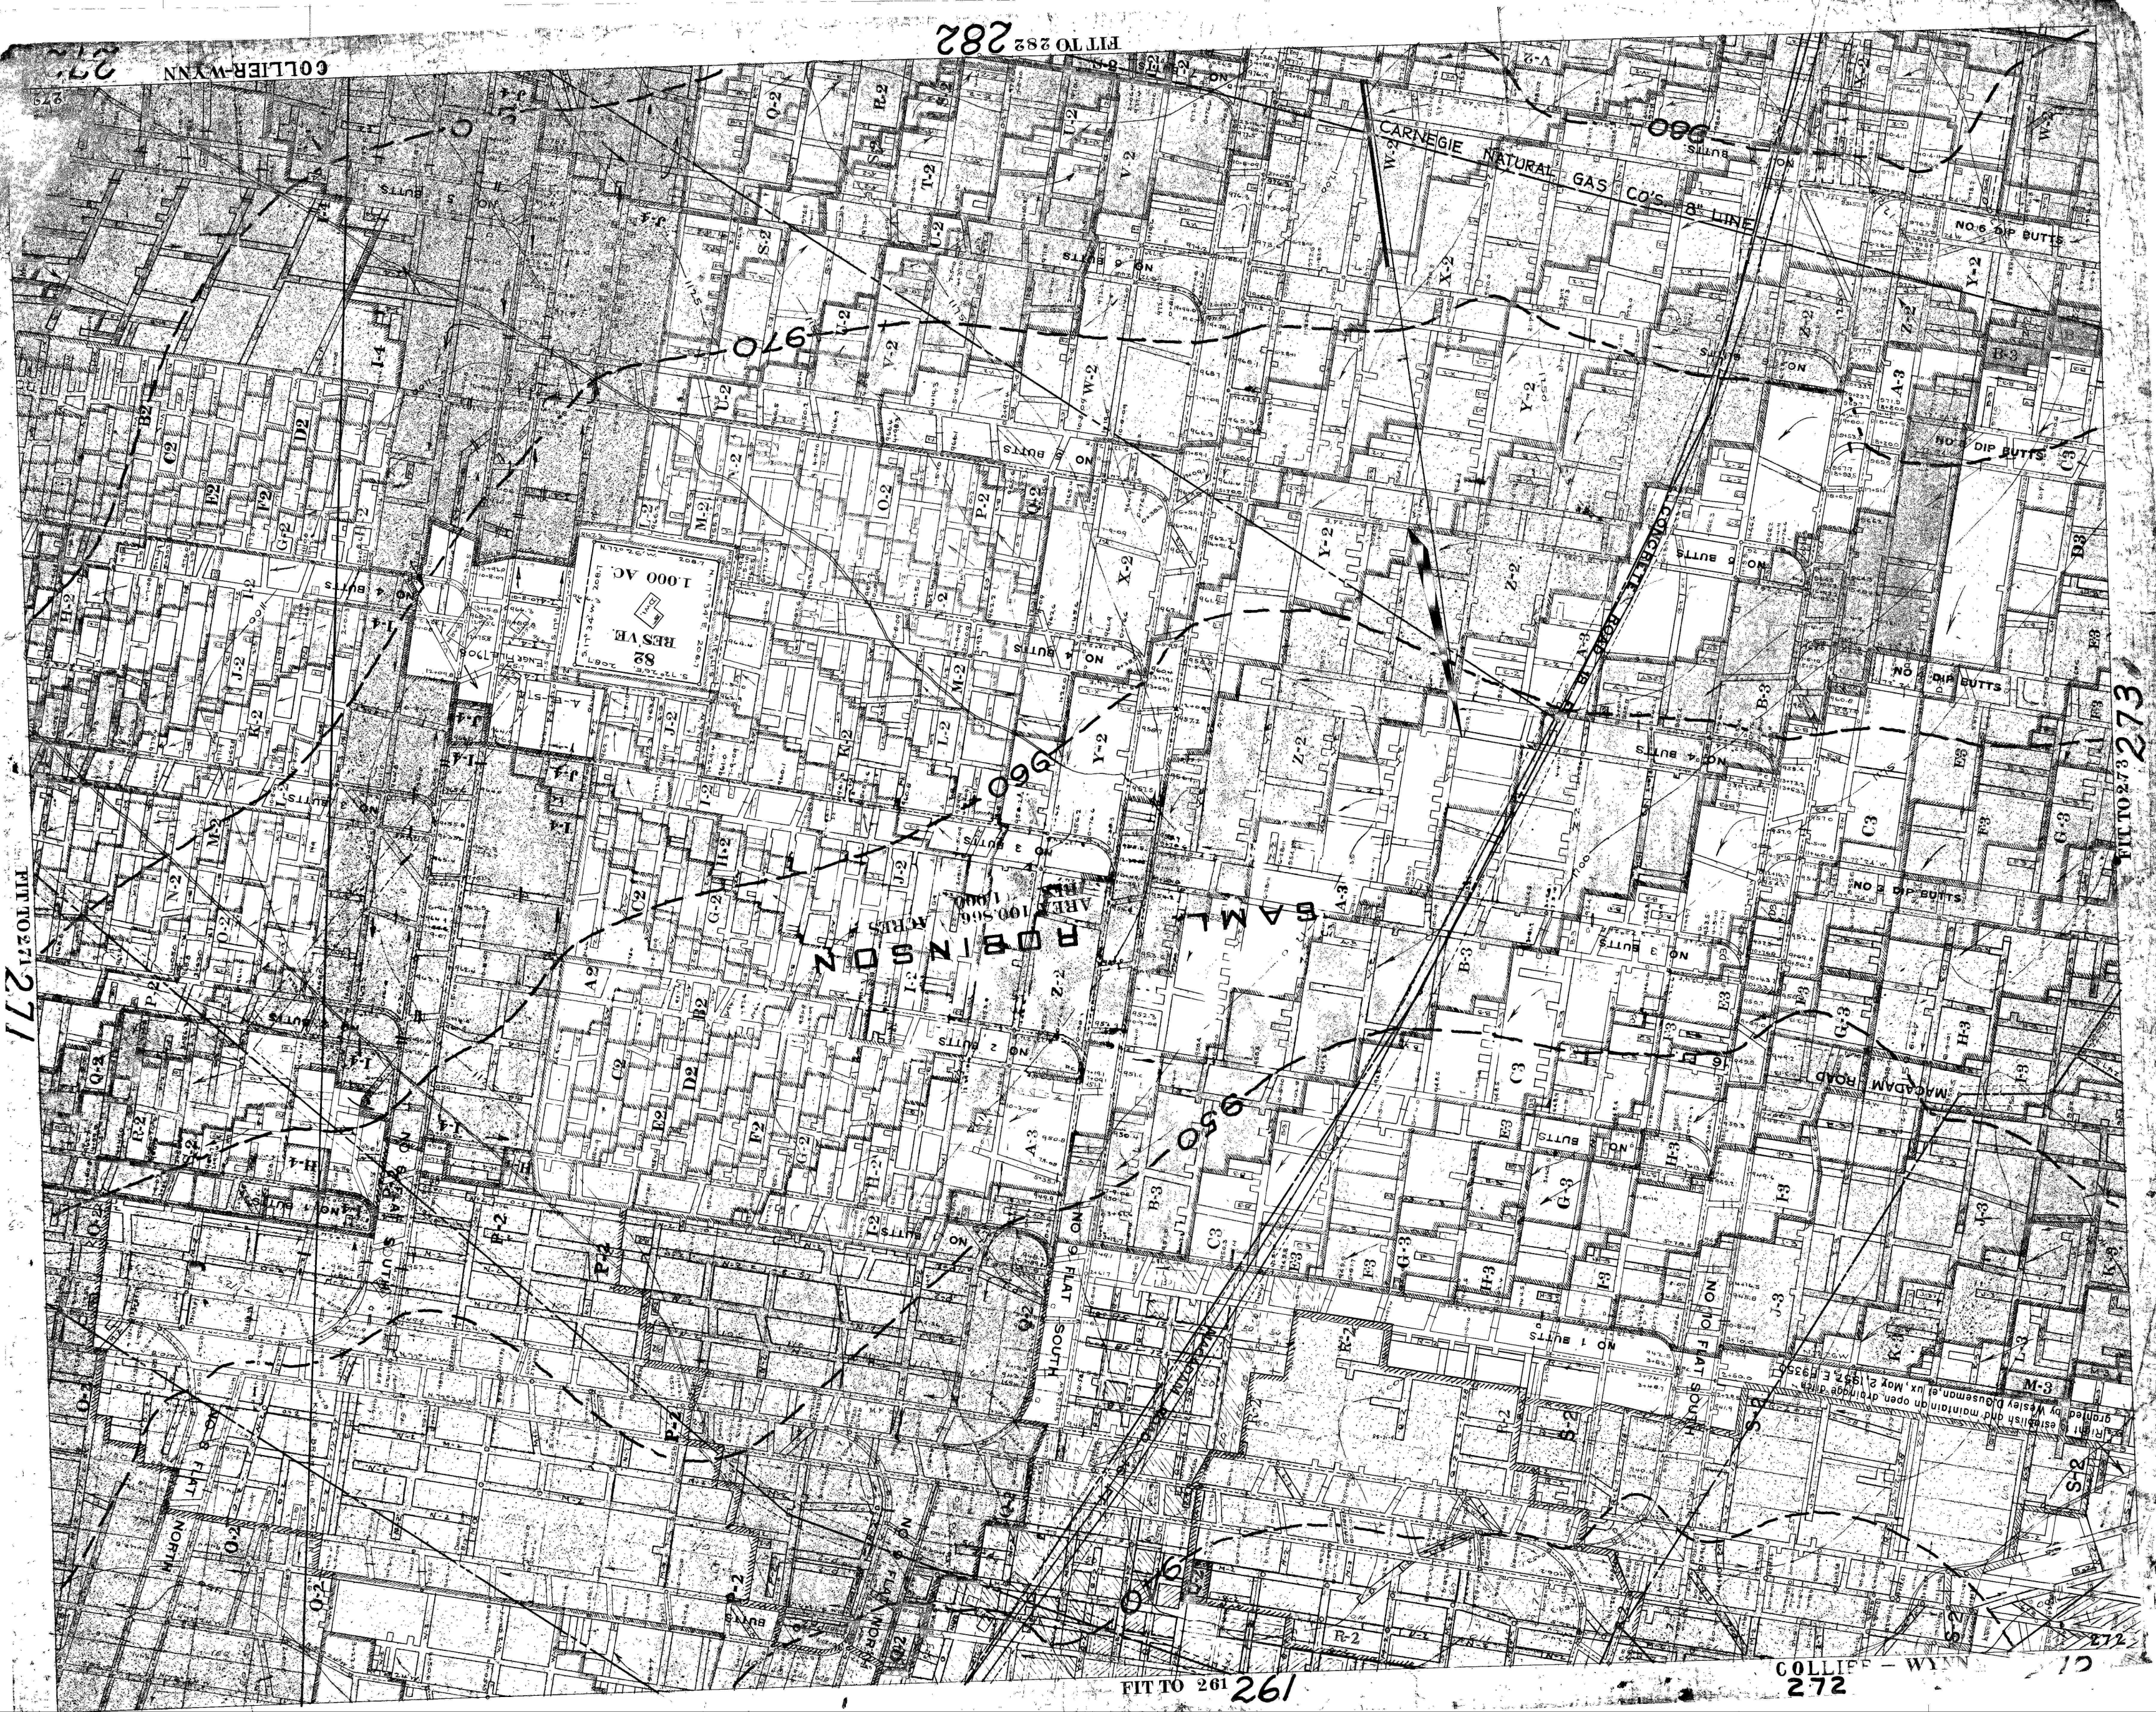

261

COLLIER - WYNN

272

273