


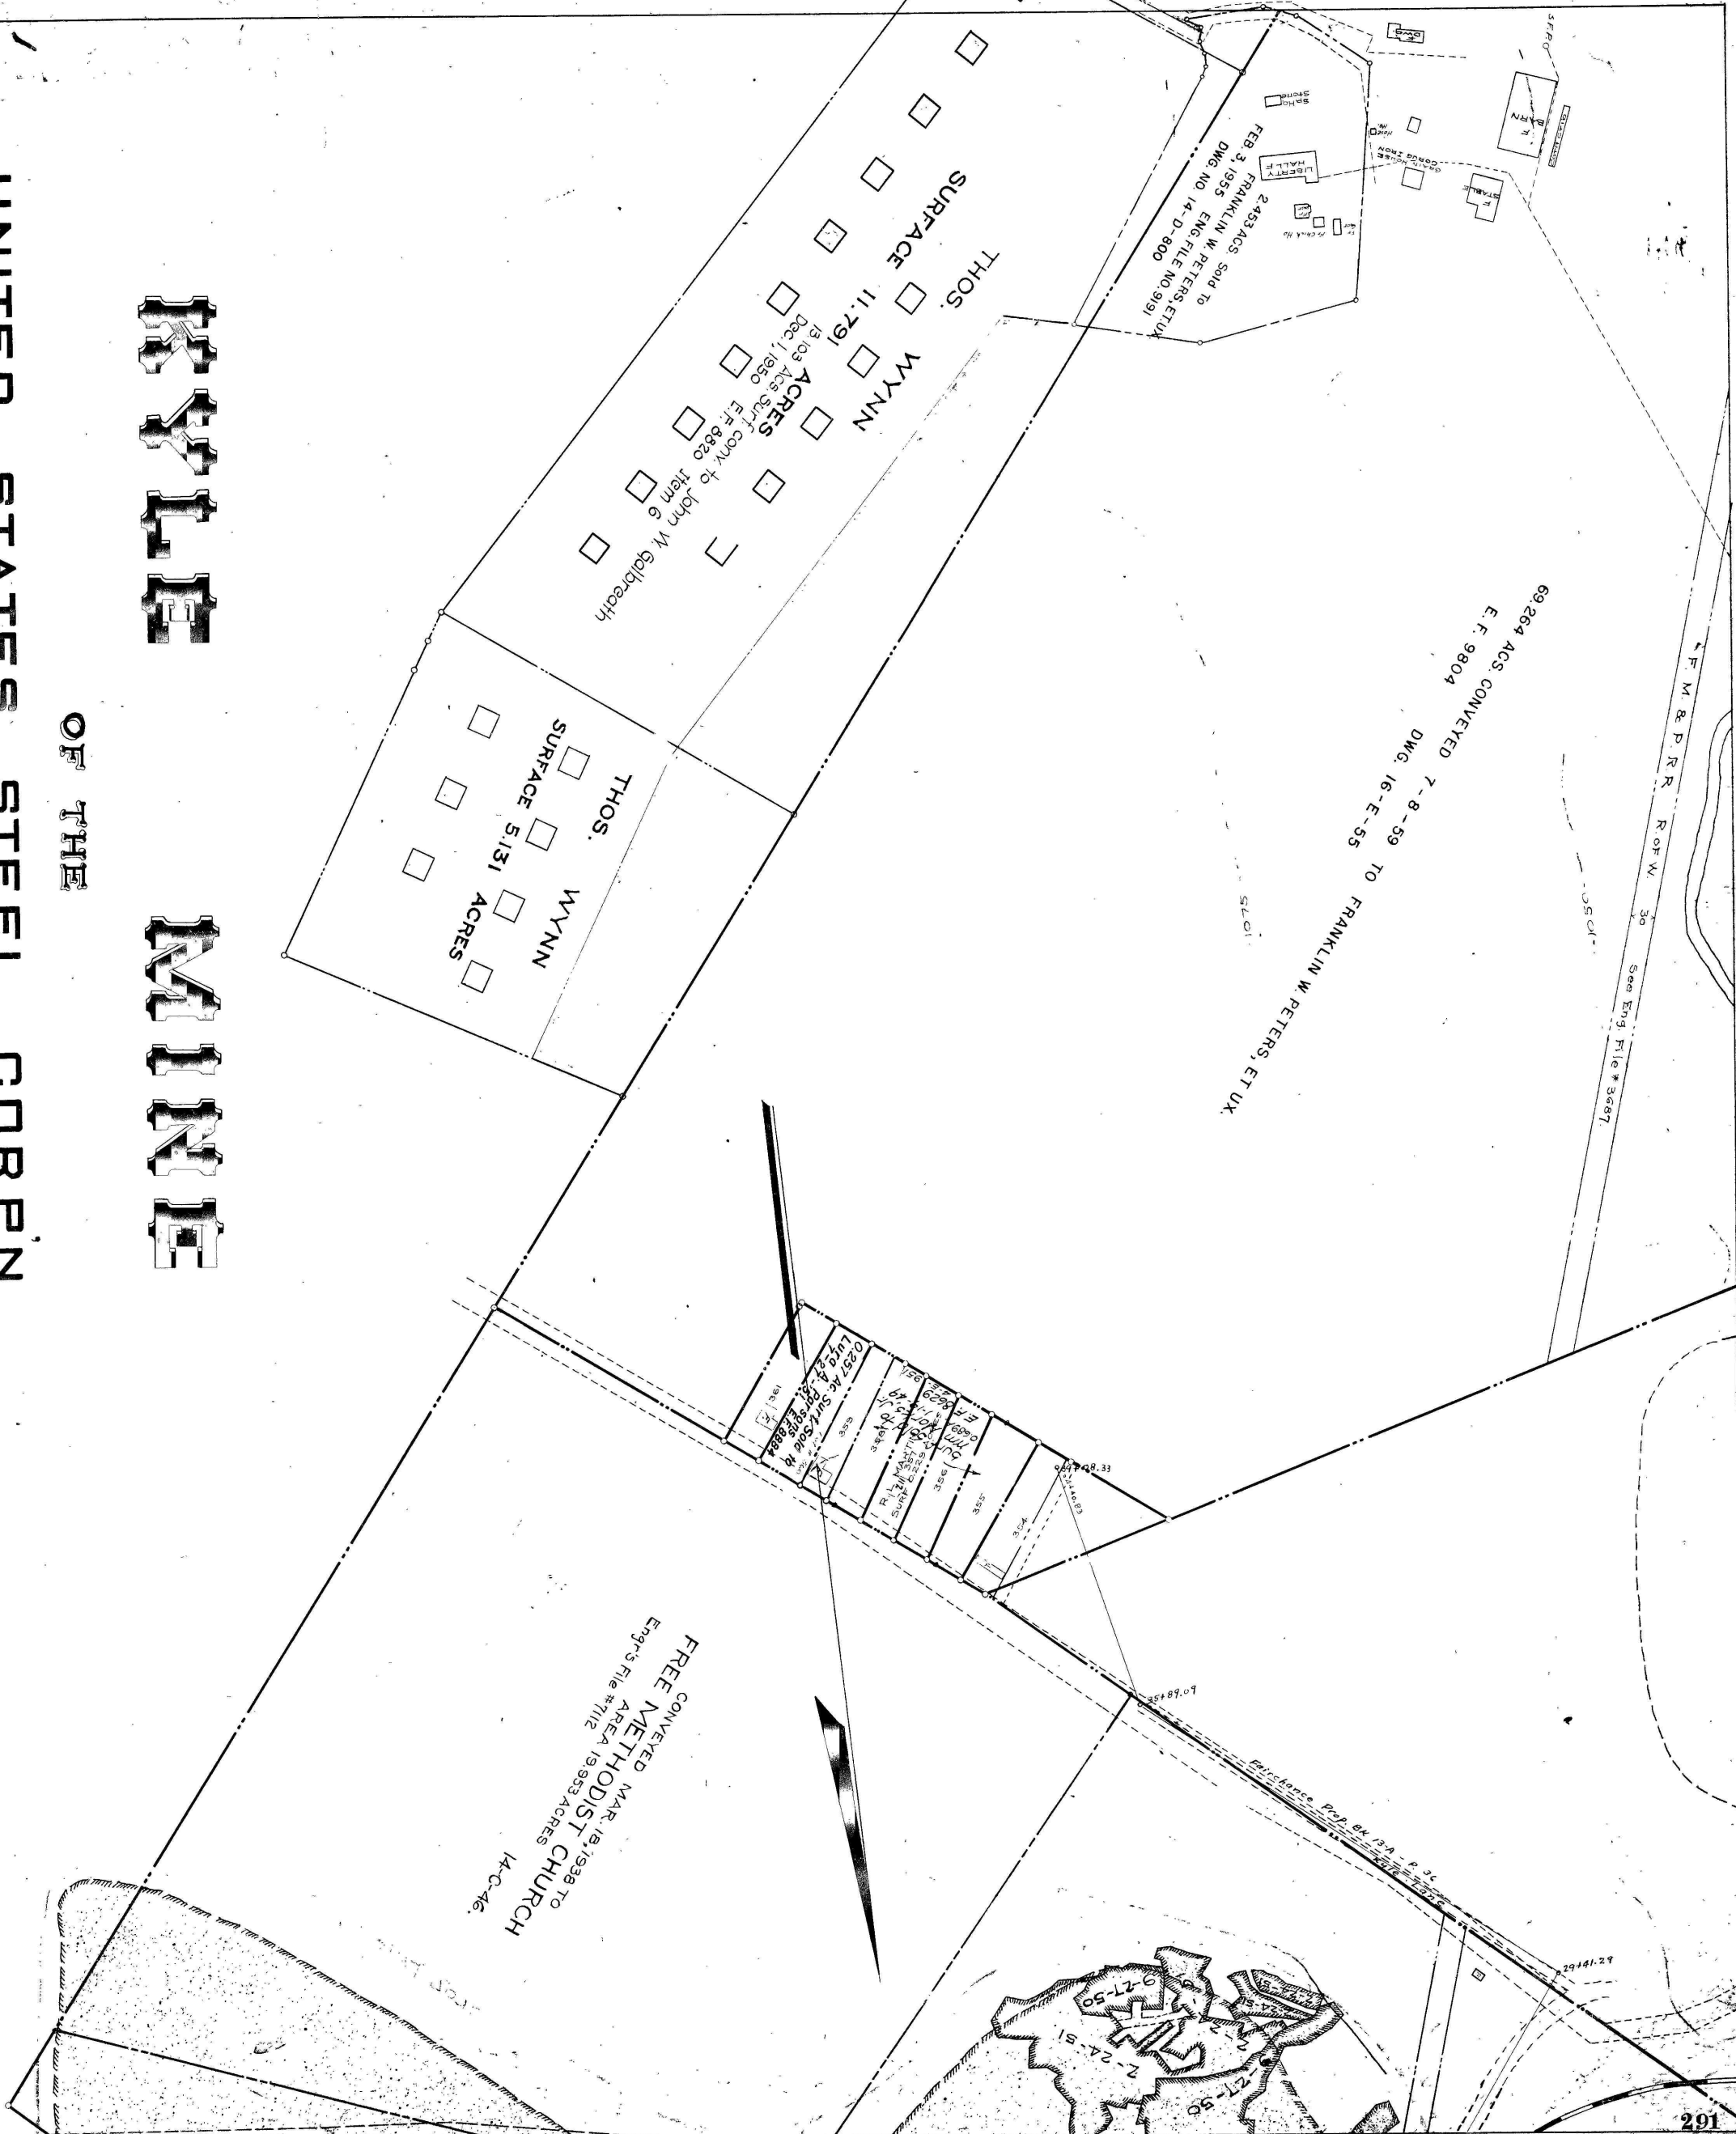

Map of the UNITED STATES STEEL CORP. GEORGES TWP., FAYETTE CO., PA.

DATUM OF LEVELS 16.1 FT. BELOW MEAN TIDE AT SANDY HOOK
SCALE 1"=100'

DATE OF SURVEYS:


271	281	291

(4 + 14) SHEETS
FIT THUS.