


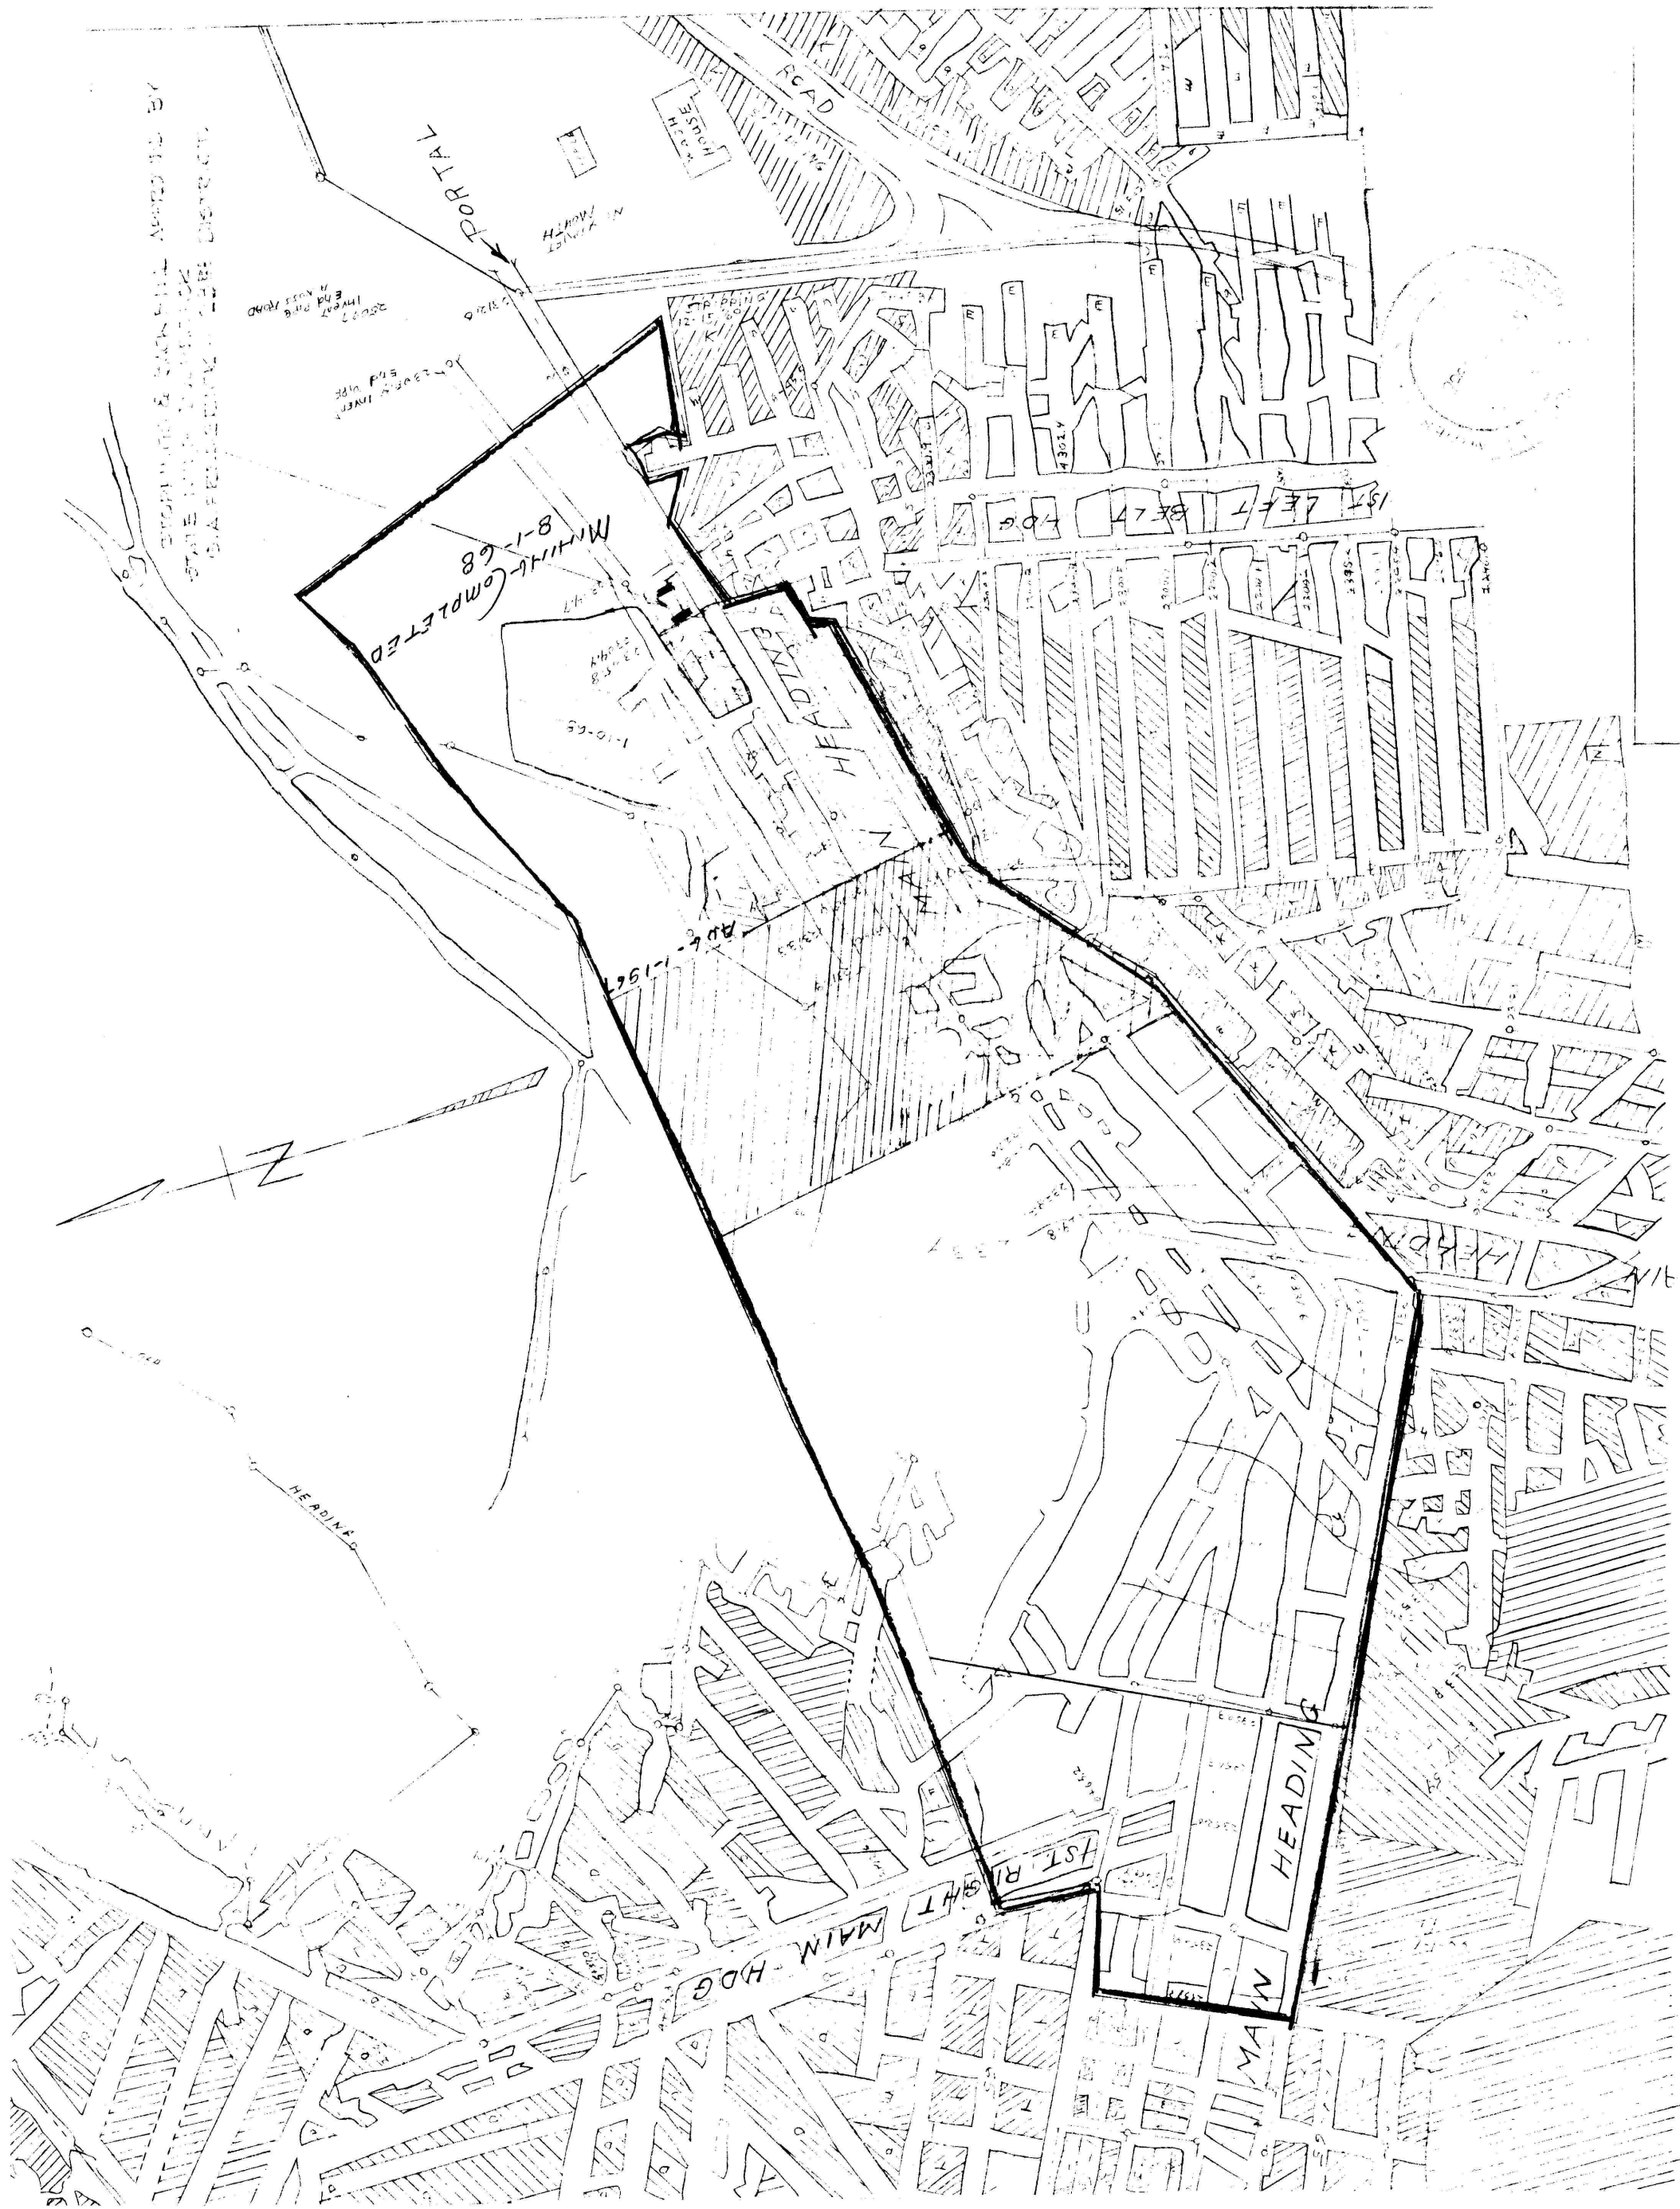

- LEGEND
- ▬ = PROPERTY LINE
  - ▨ = MINING COMPLETED 8-1-68
  - ▧ = OUTCROP LOWER FREEPORT SEAM
  - ▩ = 6 MONTH ADVANCE

THOMAS LUCE

WALTER KOVALESKI


MINE No. 4

LOWER FREEPORT SEAM  
STONYCREEK TWP SOMERSET CO. PA.

MARCH 4, 1961

VEERICKSON RPE No. 7074

SCALE - 1" = 100 FT.

 

FINAL MAP - 11/1/61