


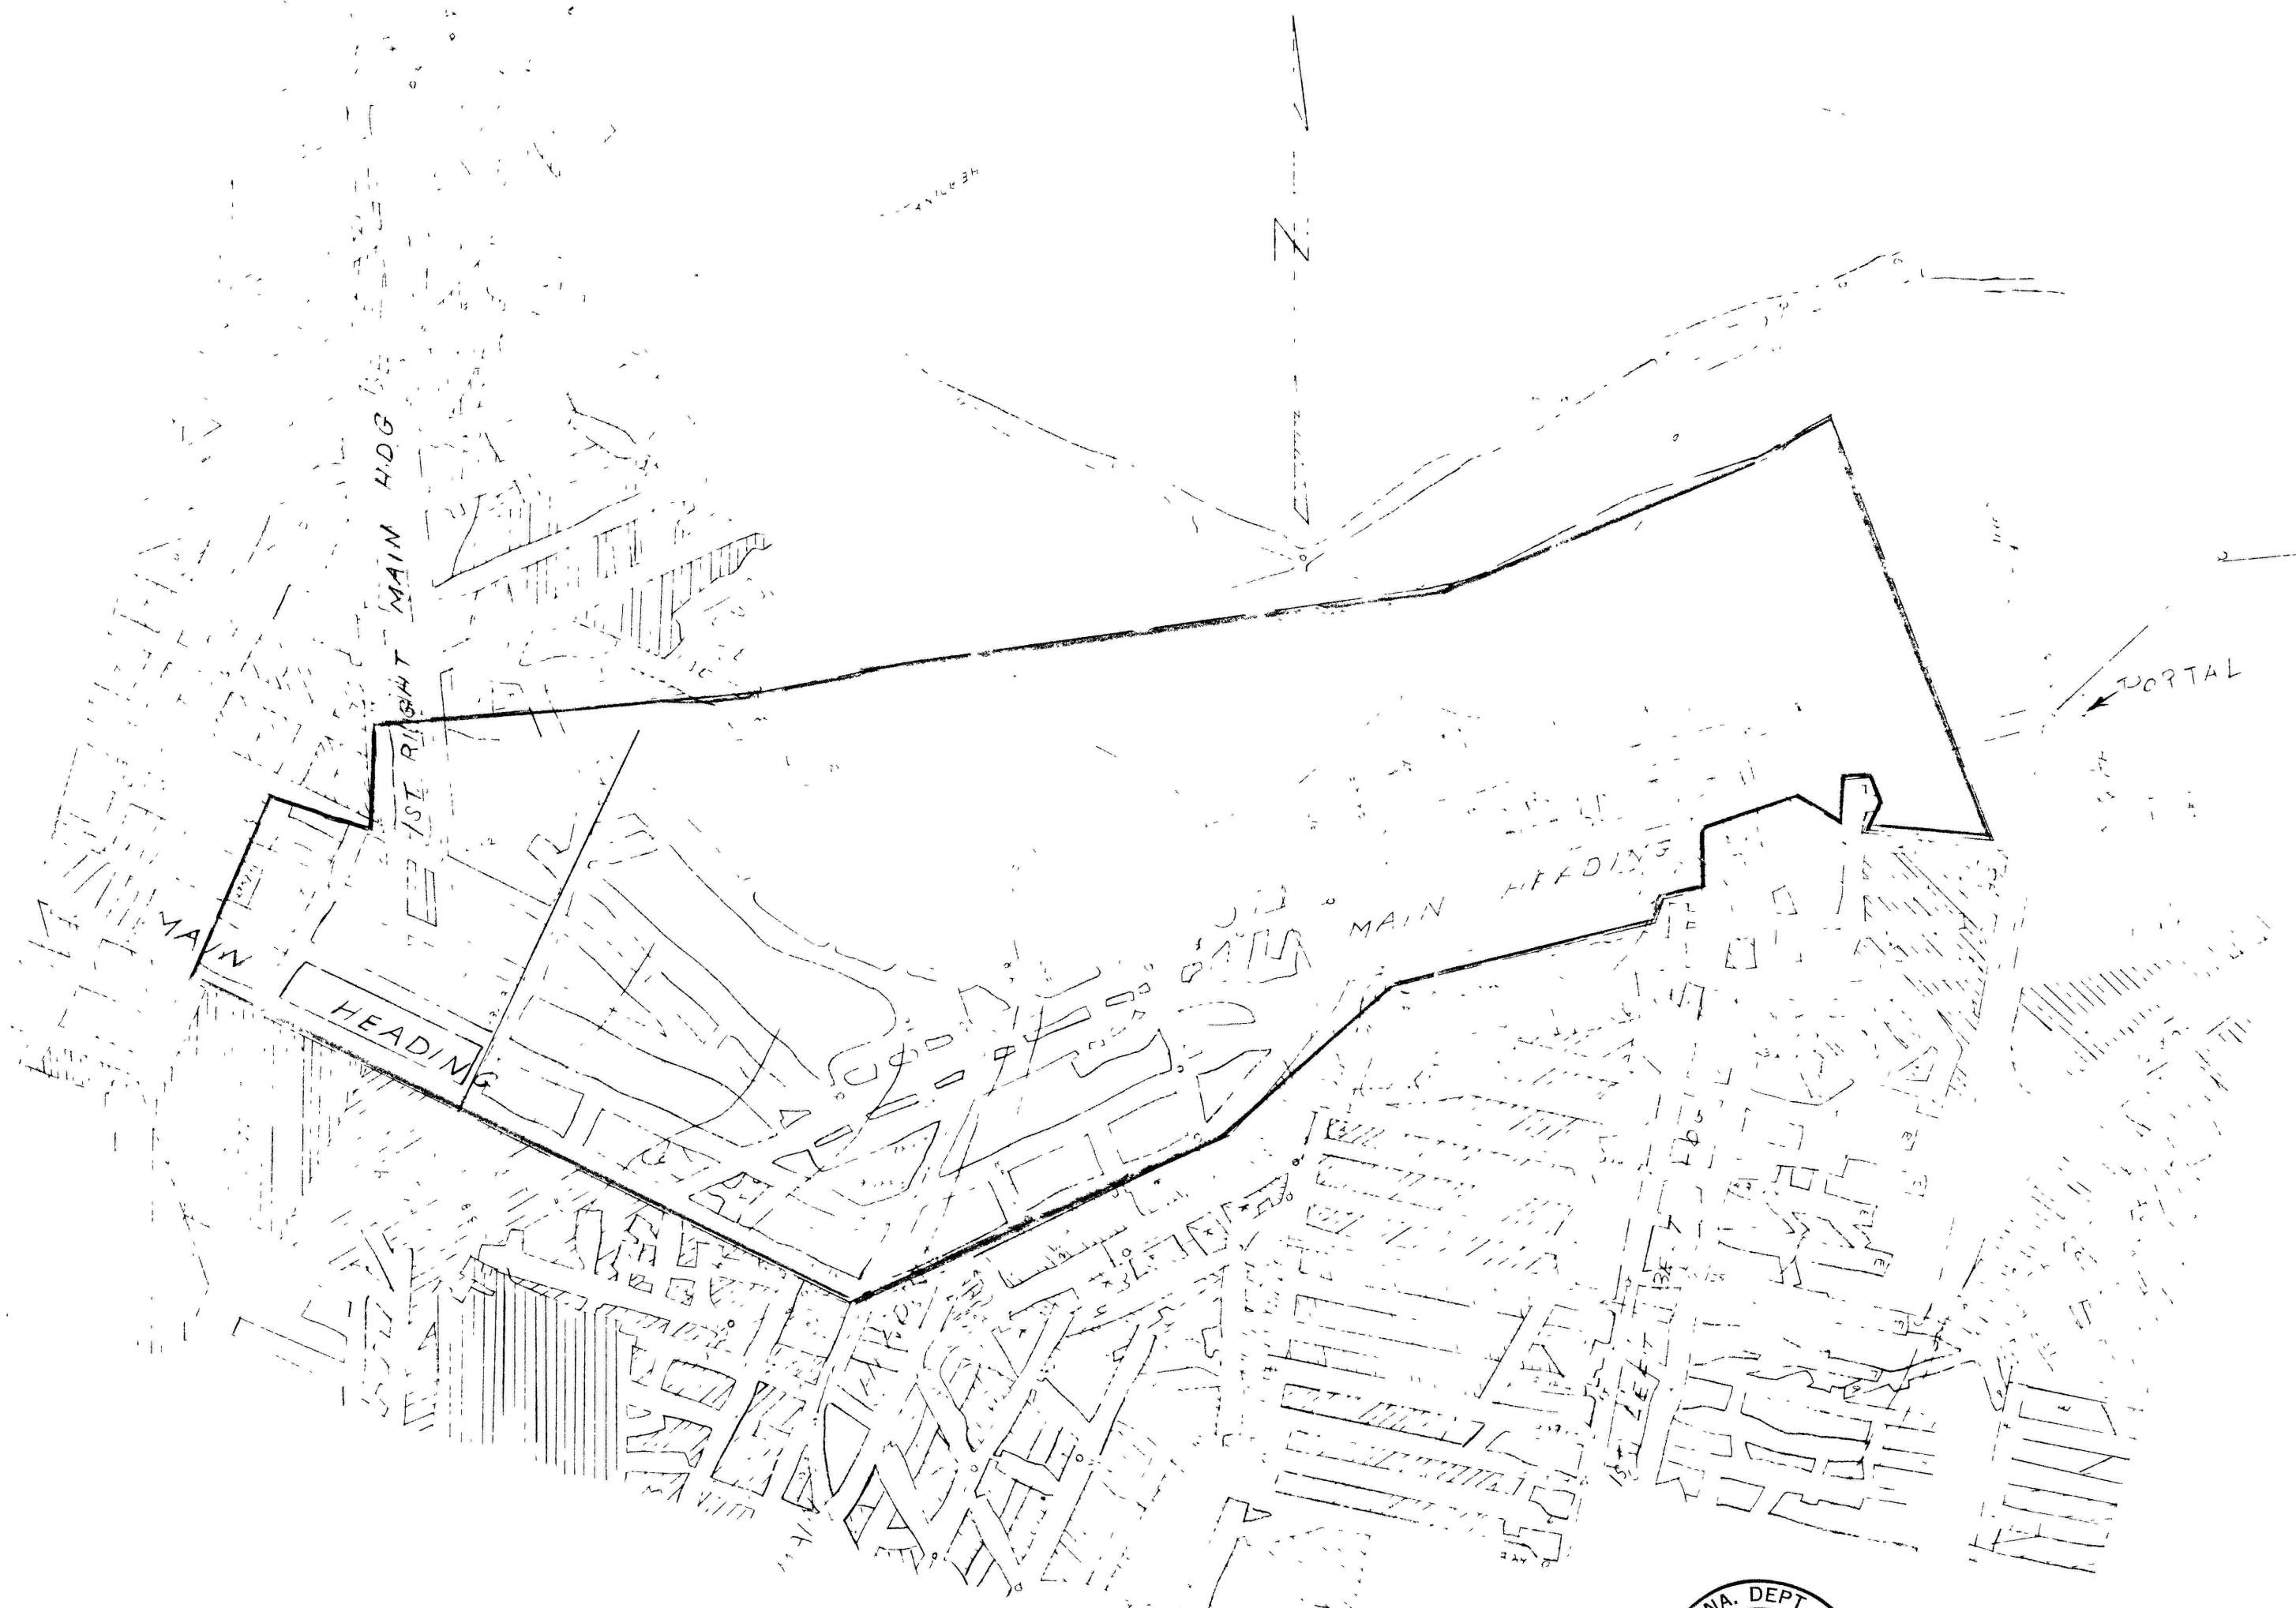

= PROPERTY
 = MINING COMPLETED
 = 1 MONTH ADVANCE
 THOMAS LICE
 HADLER HOWALESKI
 MINE No. 9
 LOWER FREEPORT SEAM
 STONYCREEK TWO
 VERBICKOW
 SOMERSET CO. PA.
 APR 10 1967

OFFICE COPY