


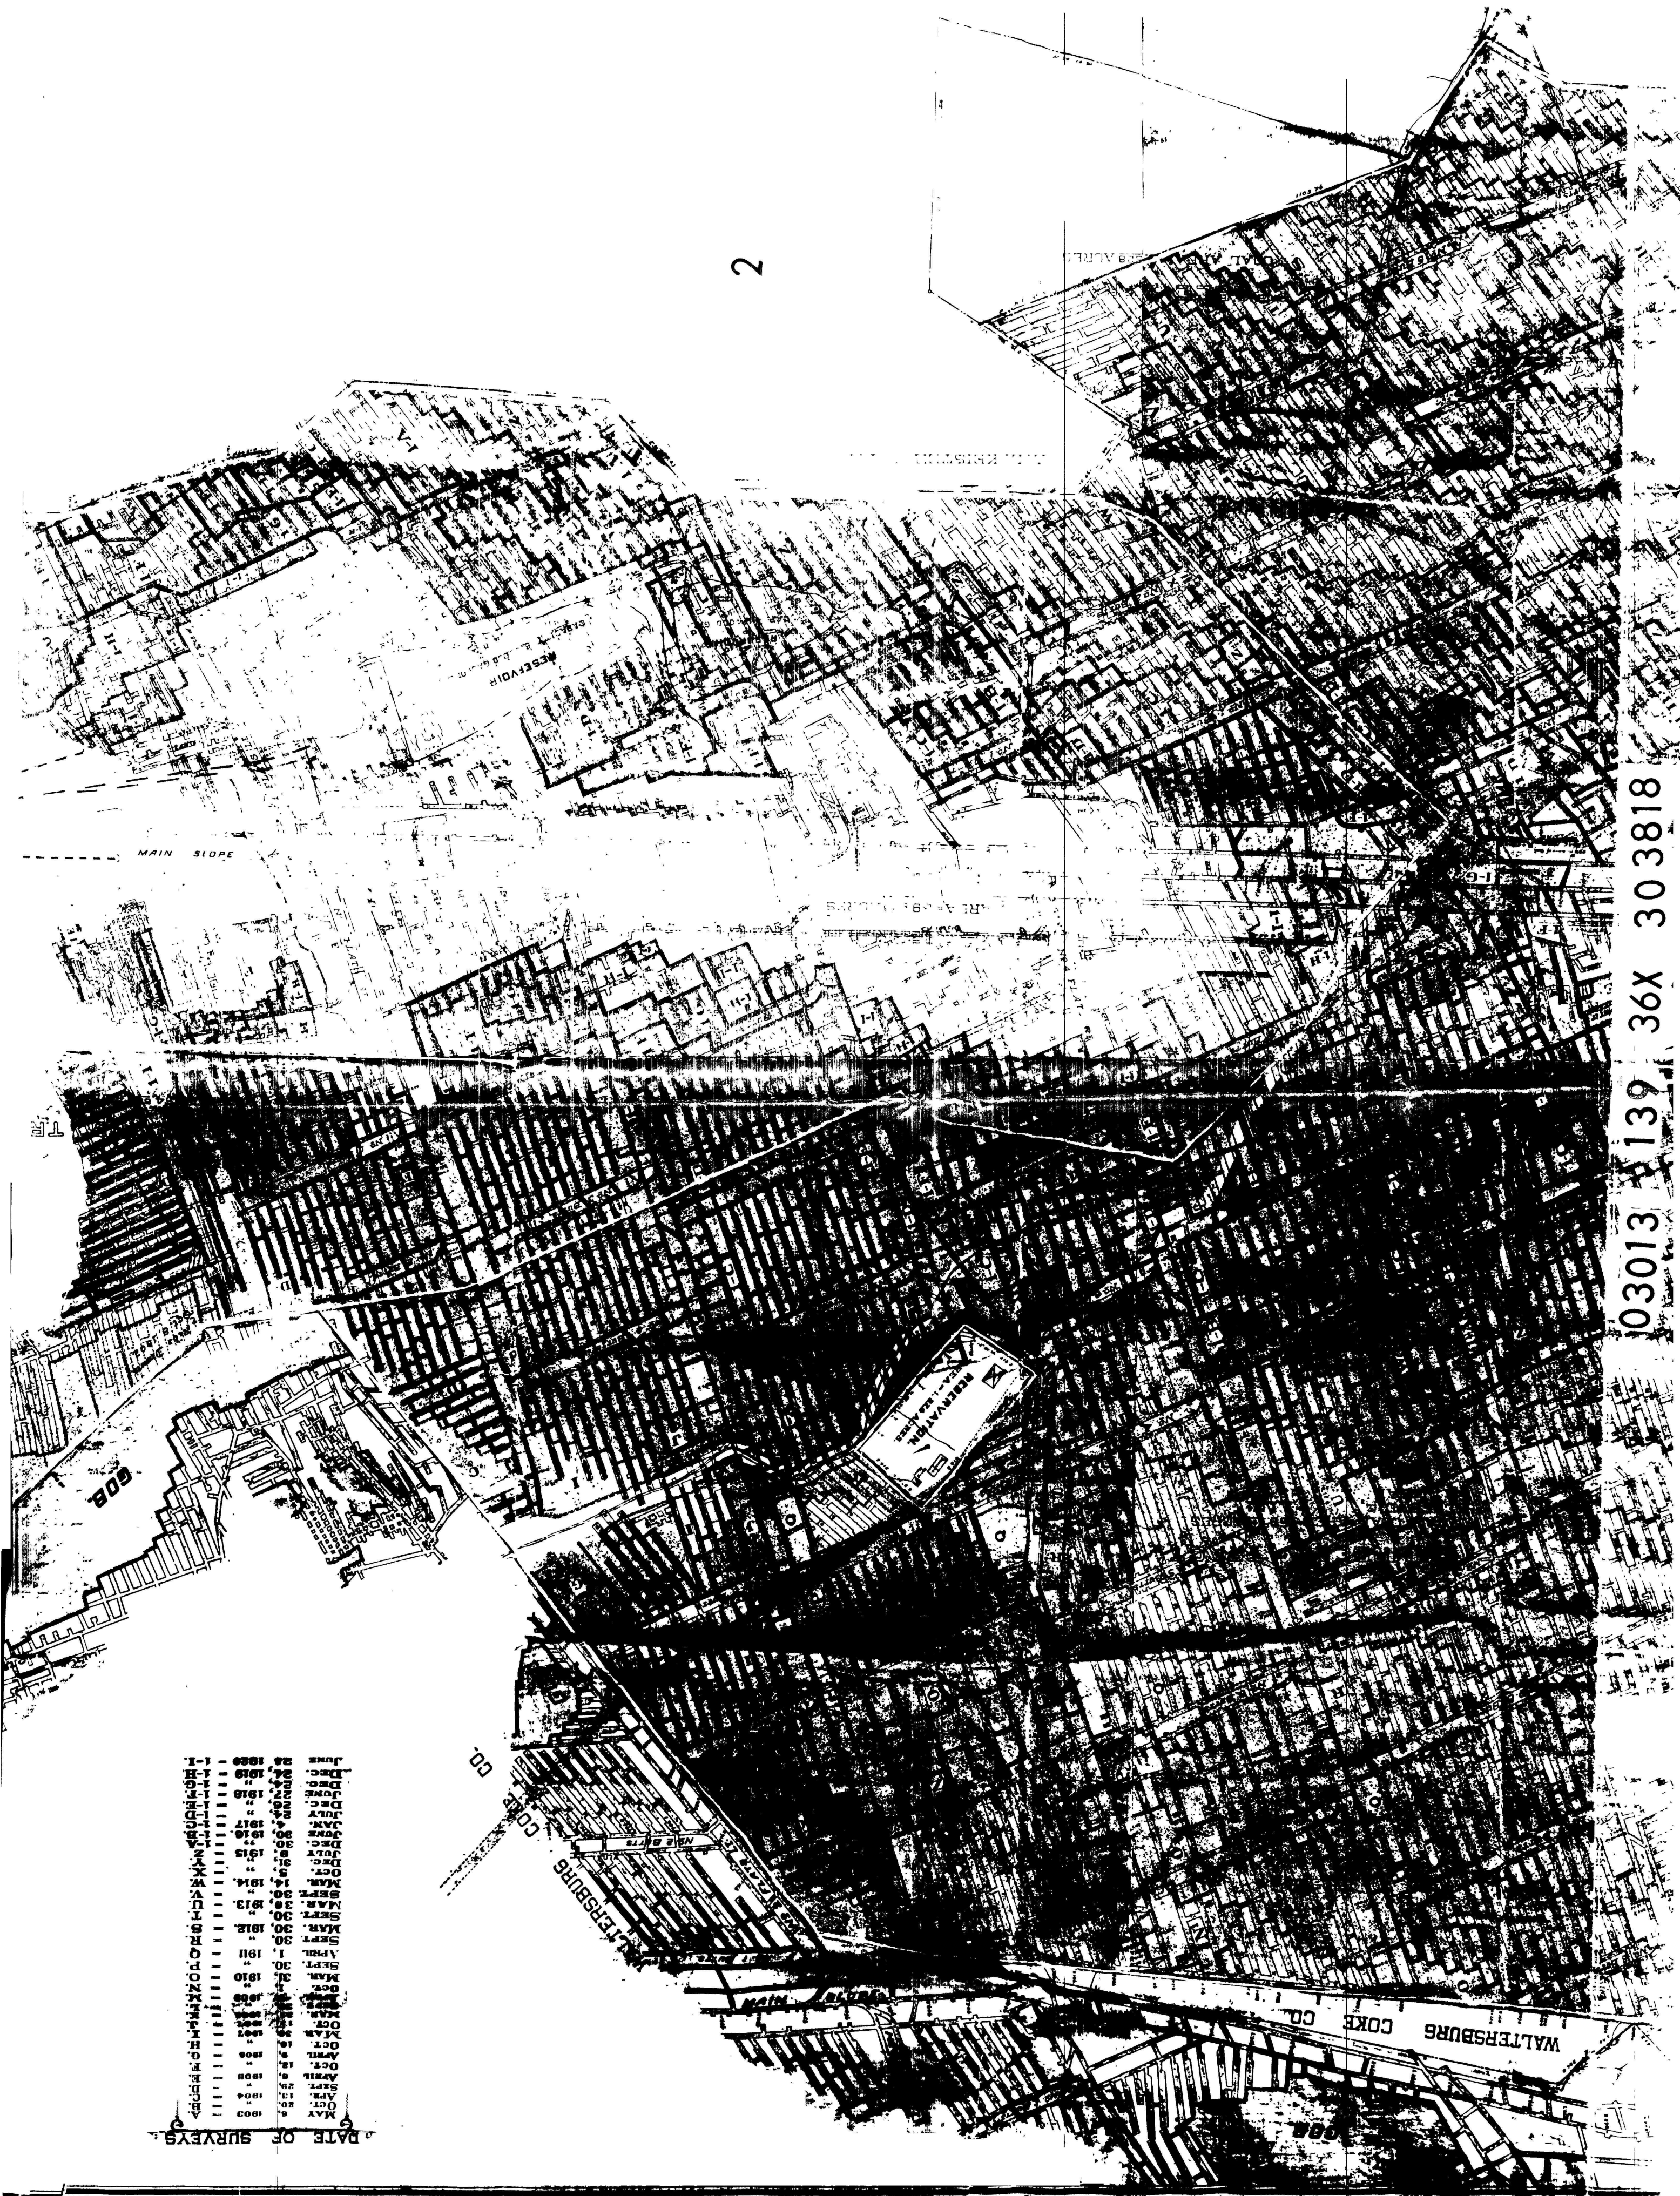

2

03013 139 36X 303818

DATE OF SURVEYS

MAY 1 1903	1-A
OCT 20 1904	1-B
APR 25 1904	1-C
APR 1 1905	1-D
OCT 1 1905	1-E
